


EAST 94

Proposed slope

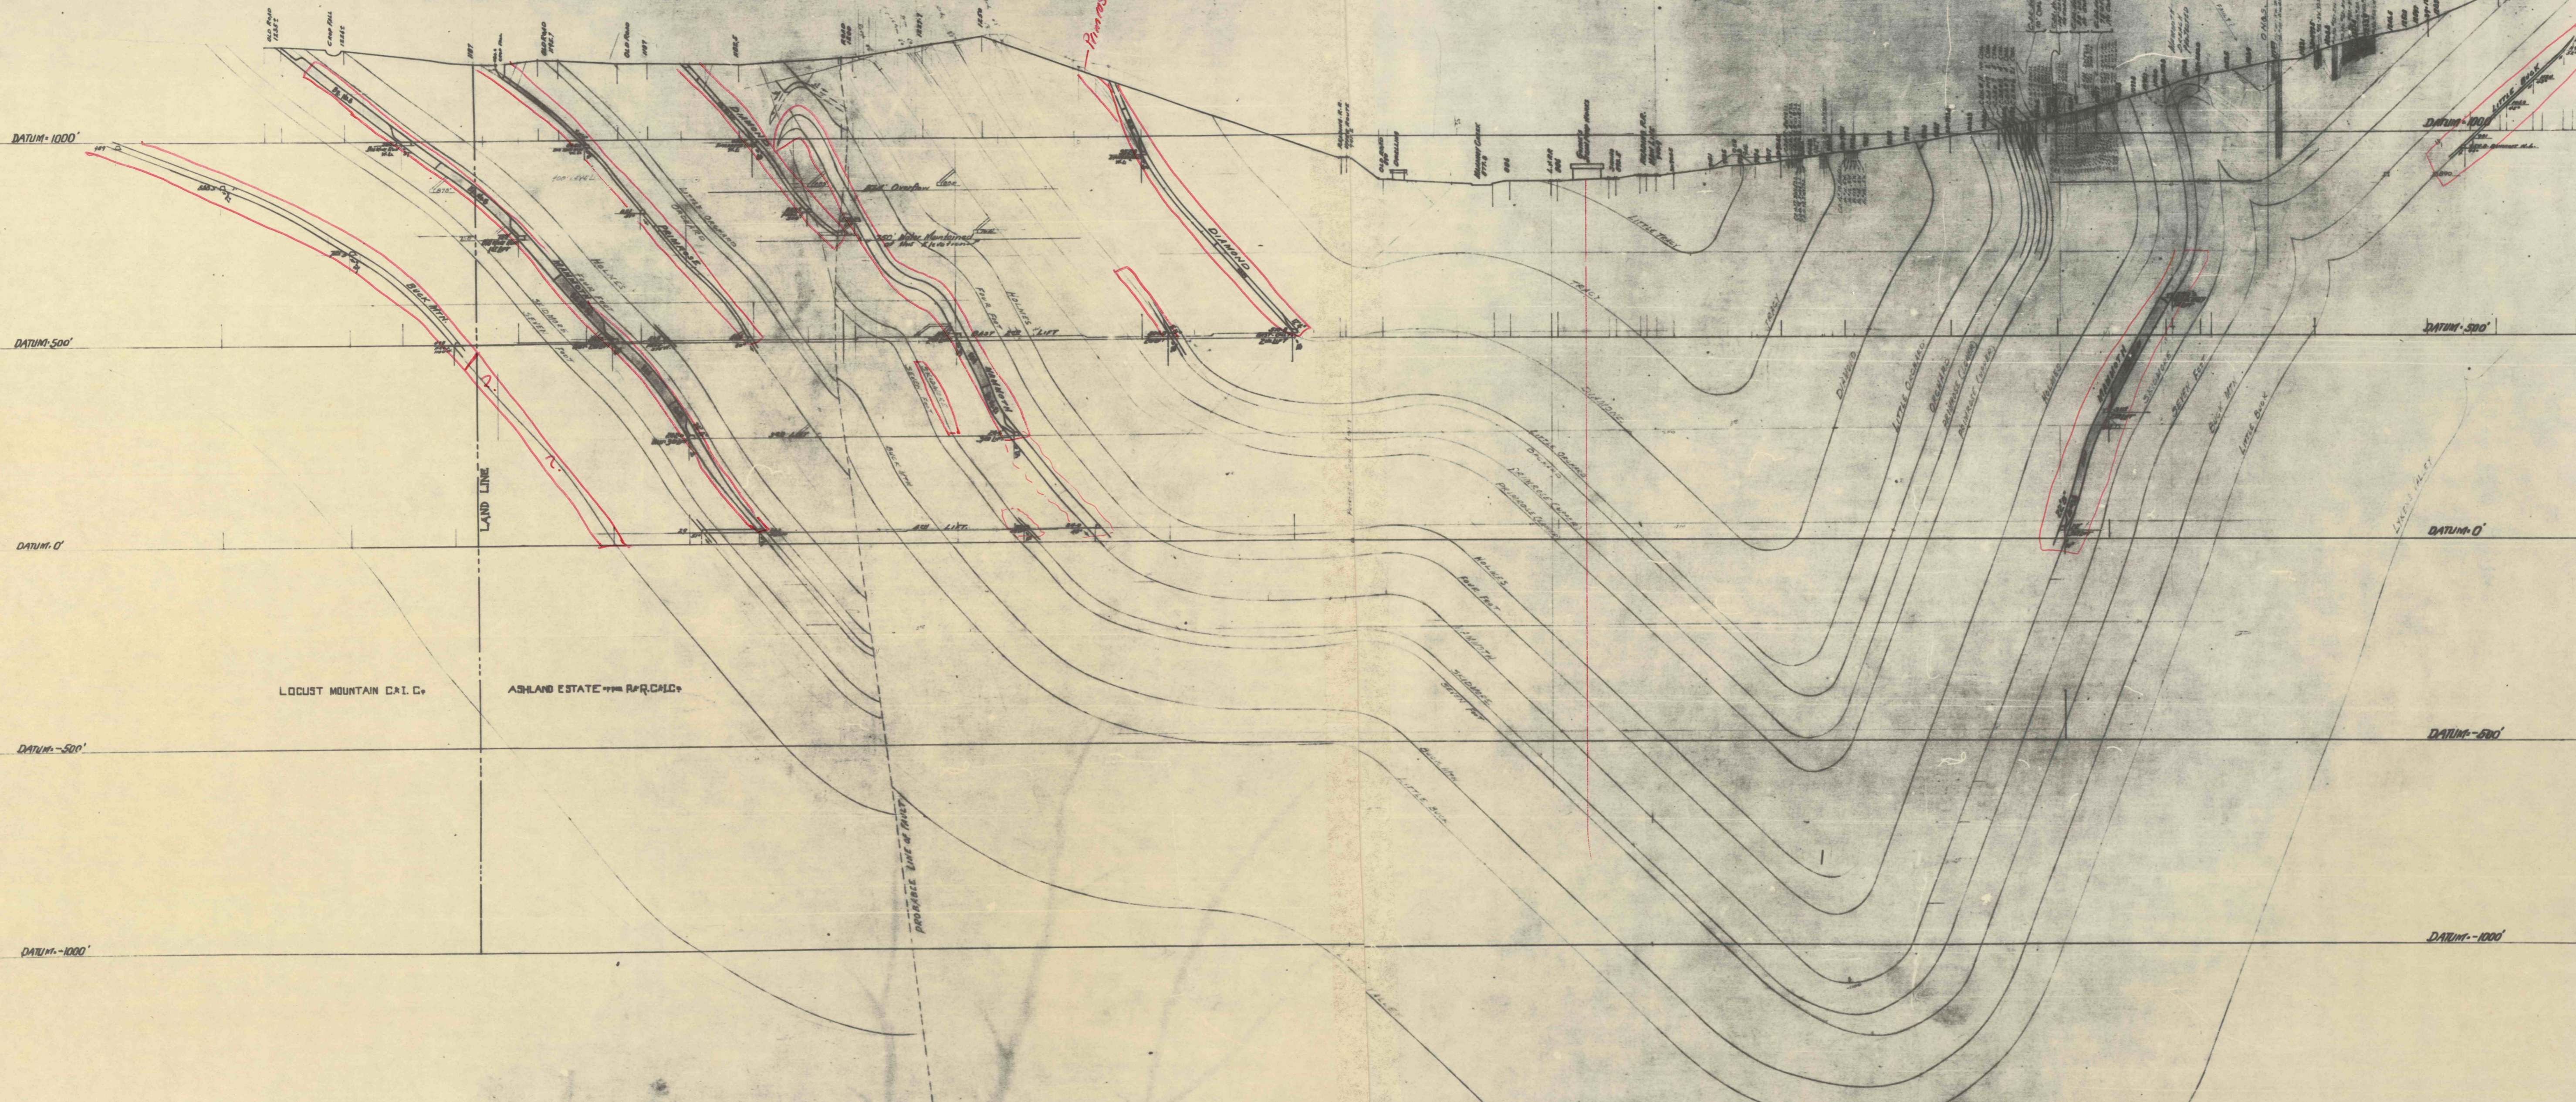

DATUM +1000'

DATUM +500'

DATUM 0'

DATUM -500'

DATUM -1000'

LOCUST MOUNTAIN CAL. C.

ASHLAND ESTATE

LAND LINE

PROPOSED LINE OF TRUST

DATUM +100'

DATUM +500'

DATUM 0'

DATUM -500'

DATUM -1000'

Advised
East
Point