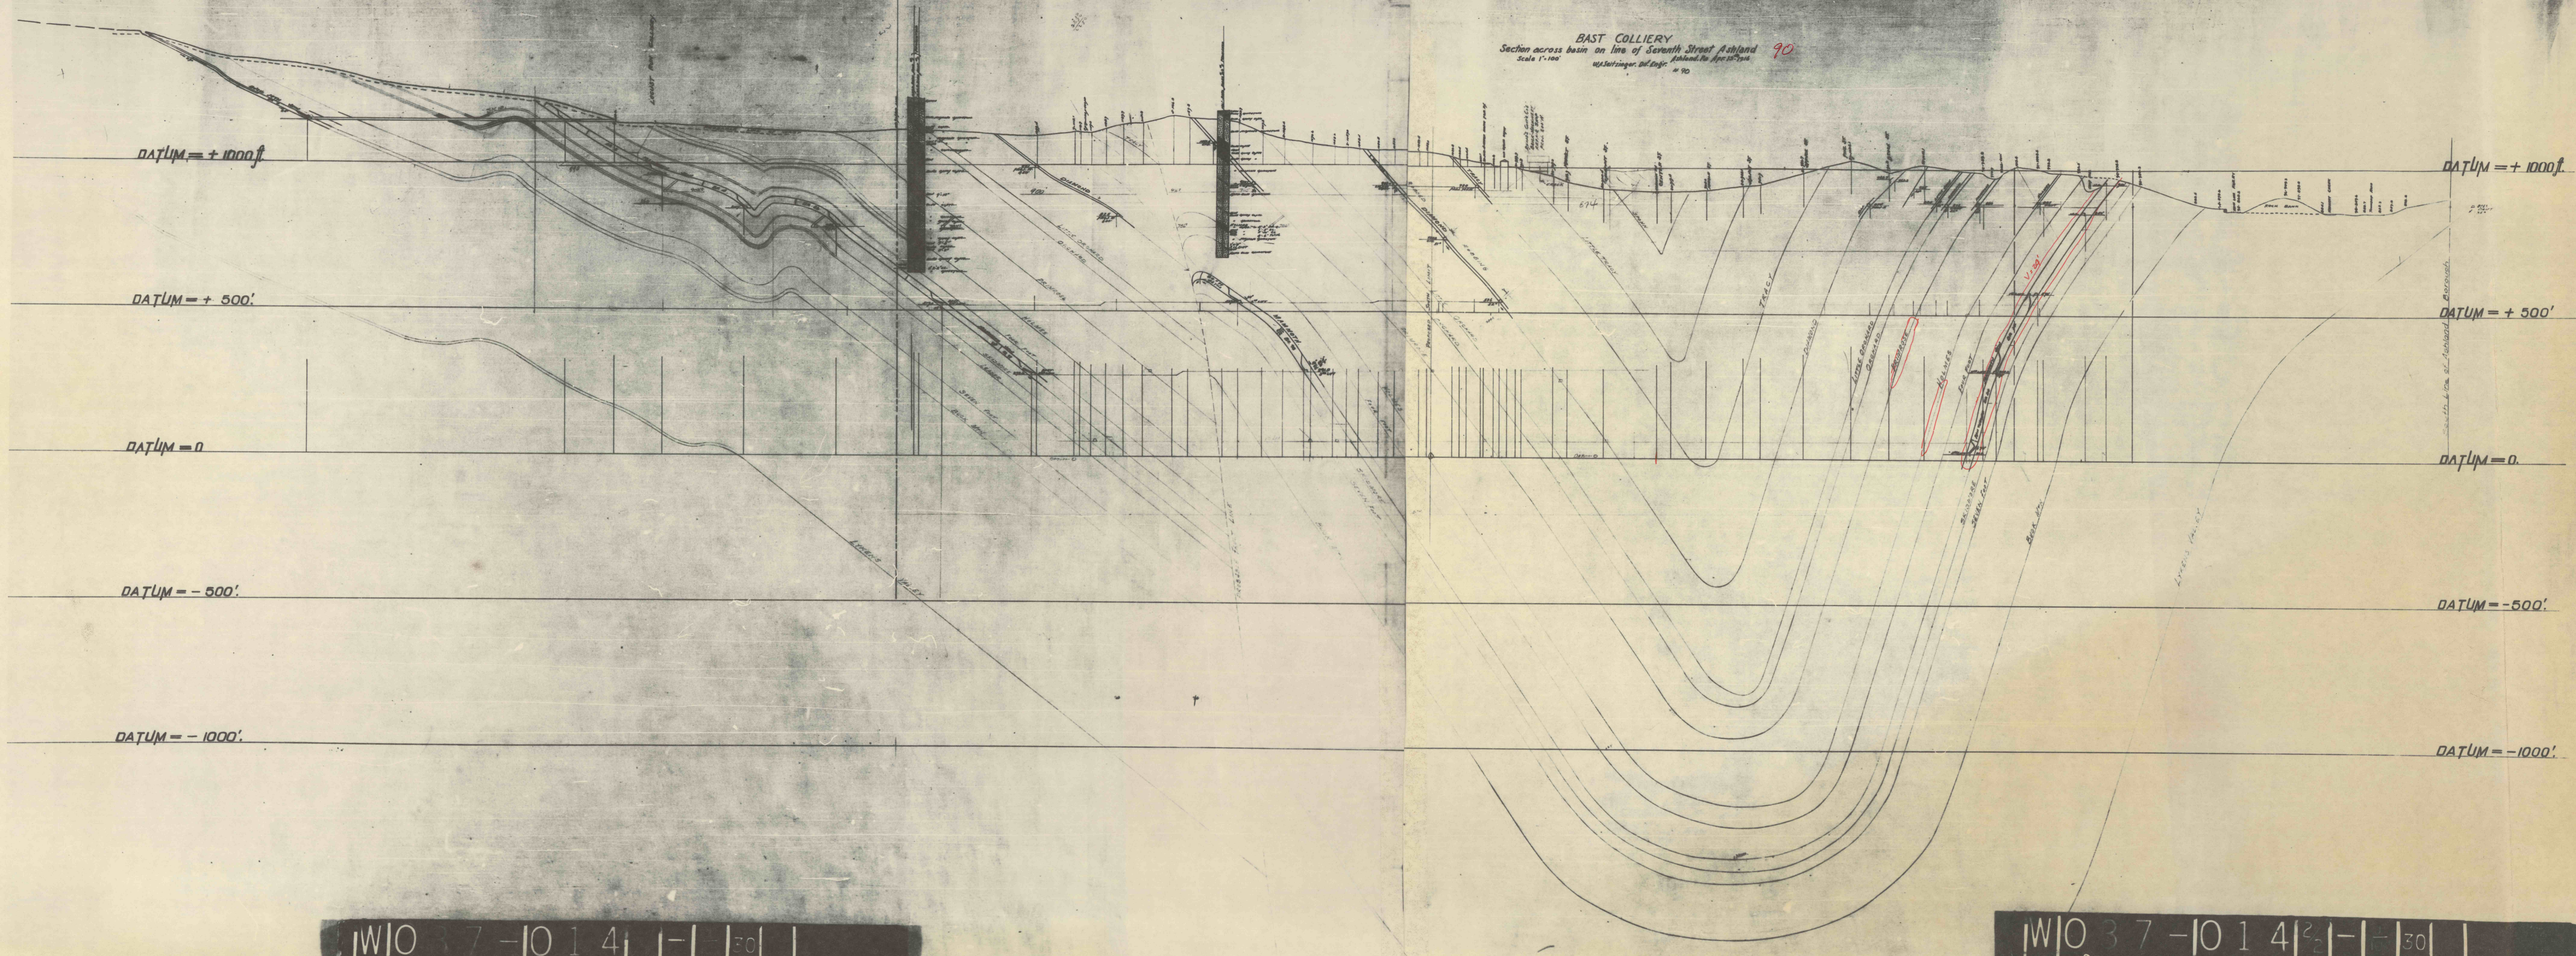

W037-0141-1-30