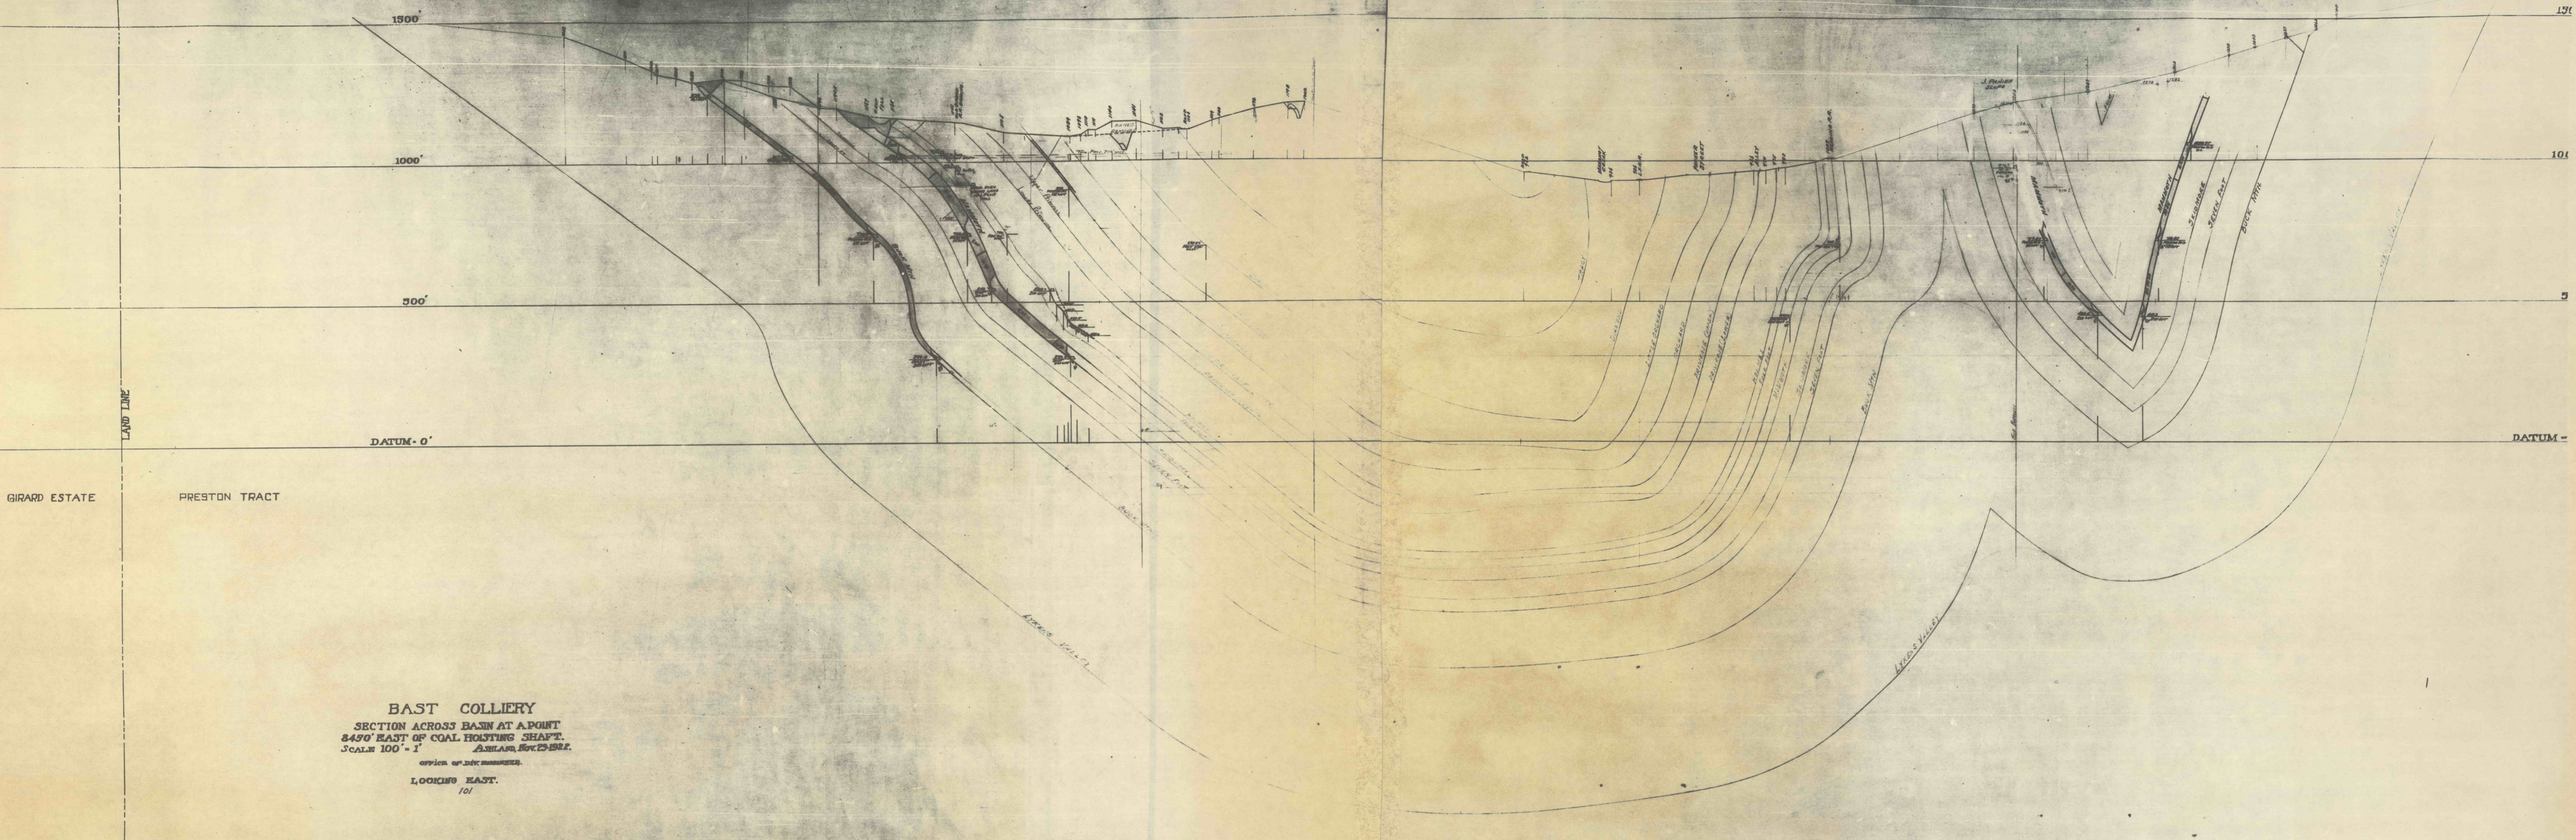
1500'
1000'
500'
DATUM - 0'
LAND LINE
GIRARD ESTATE
PRESTON TRACT
BAST COLLIERY
SECTION ACROSS BASIN AT A POINT
8450' EAST OF COAL HOISTING SHAFT.
SCALE 100' - 1'
ASHLAND, NOV. 25 - 1921.
OFFICE OF DIV. MANAGER.
LOOKING EAST.
101