


BAST COLLIERY MAP OF DIAMOND VEIN WORKINGS.

SCALE 100 FEET PER INCH ASHLAND MAR. 26 1919.
OFFICE OF DIV. ENGR.

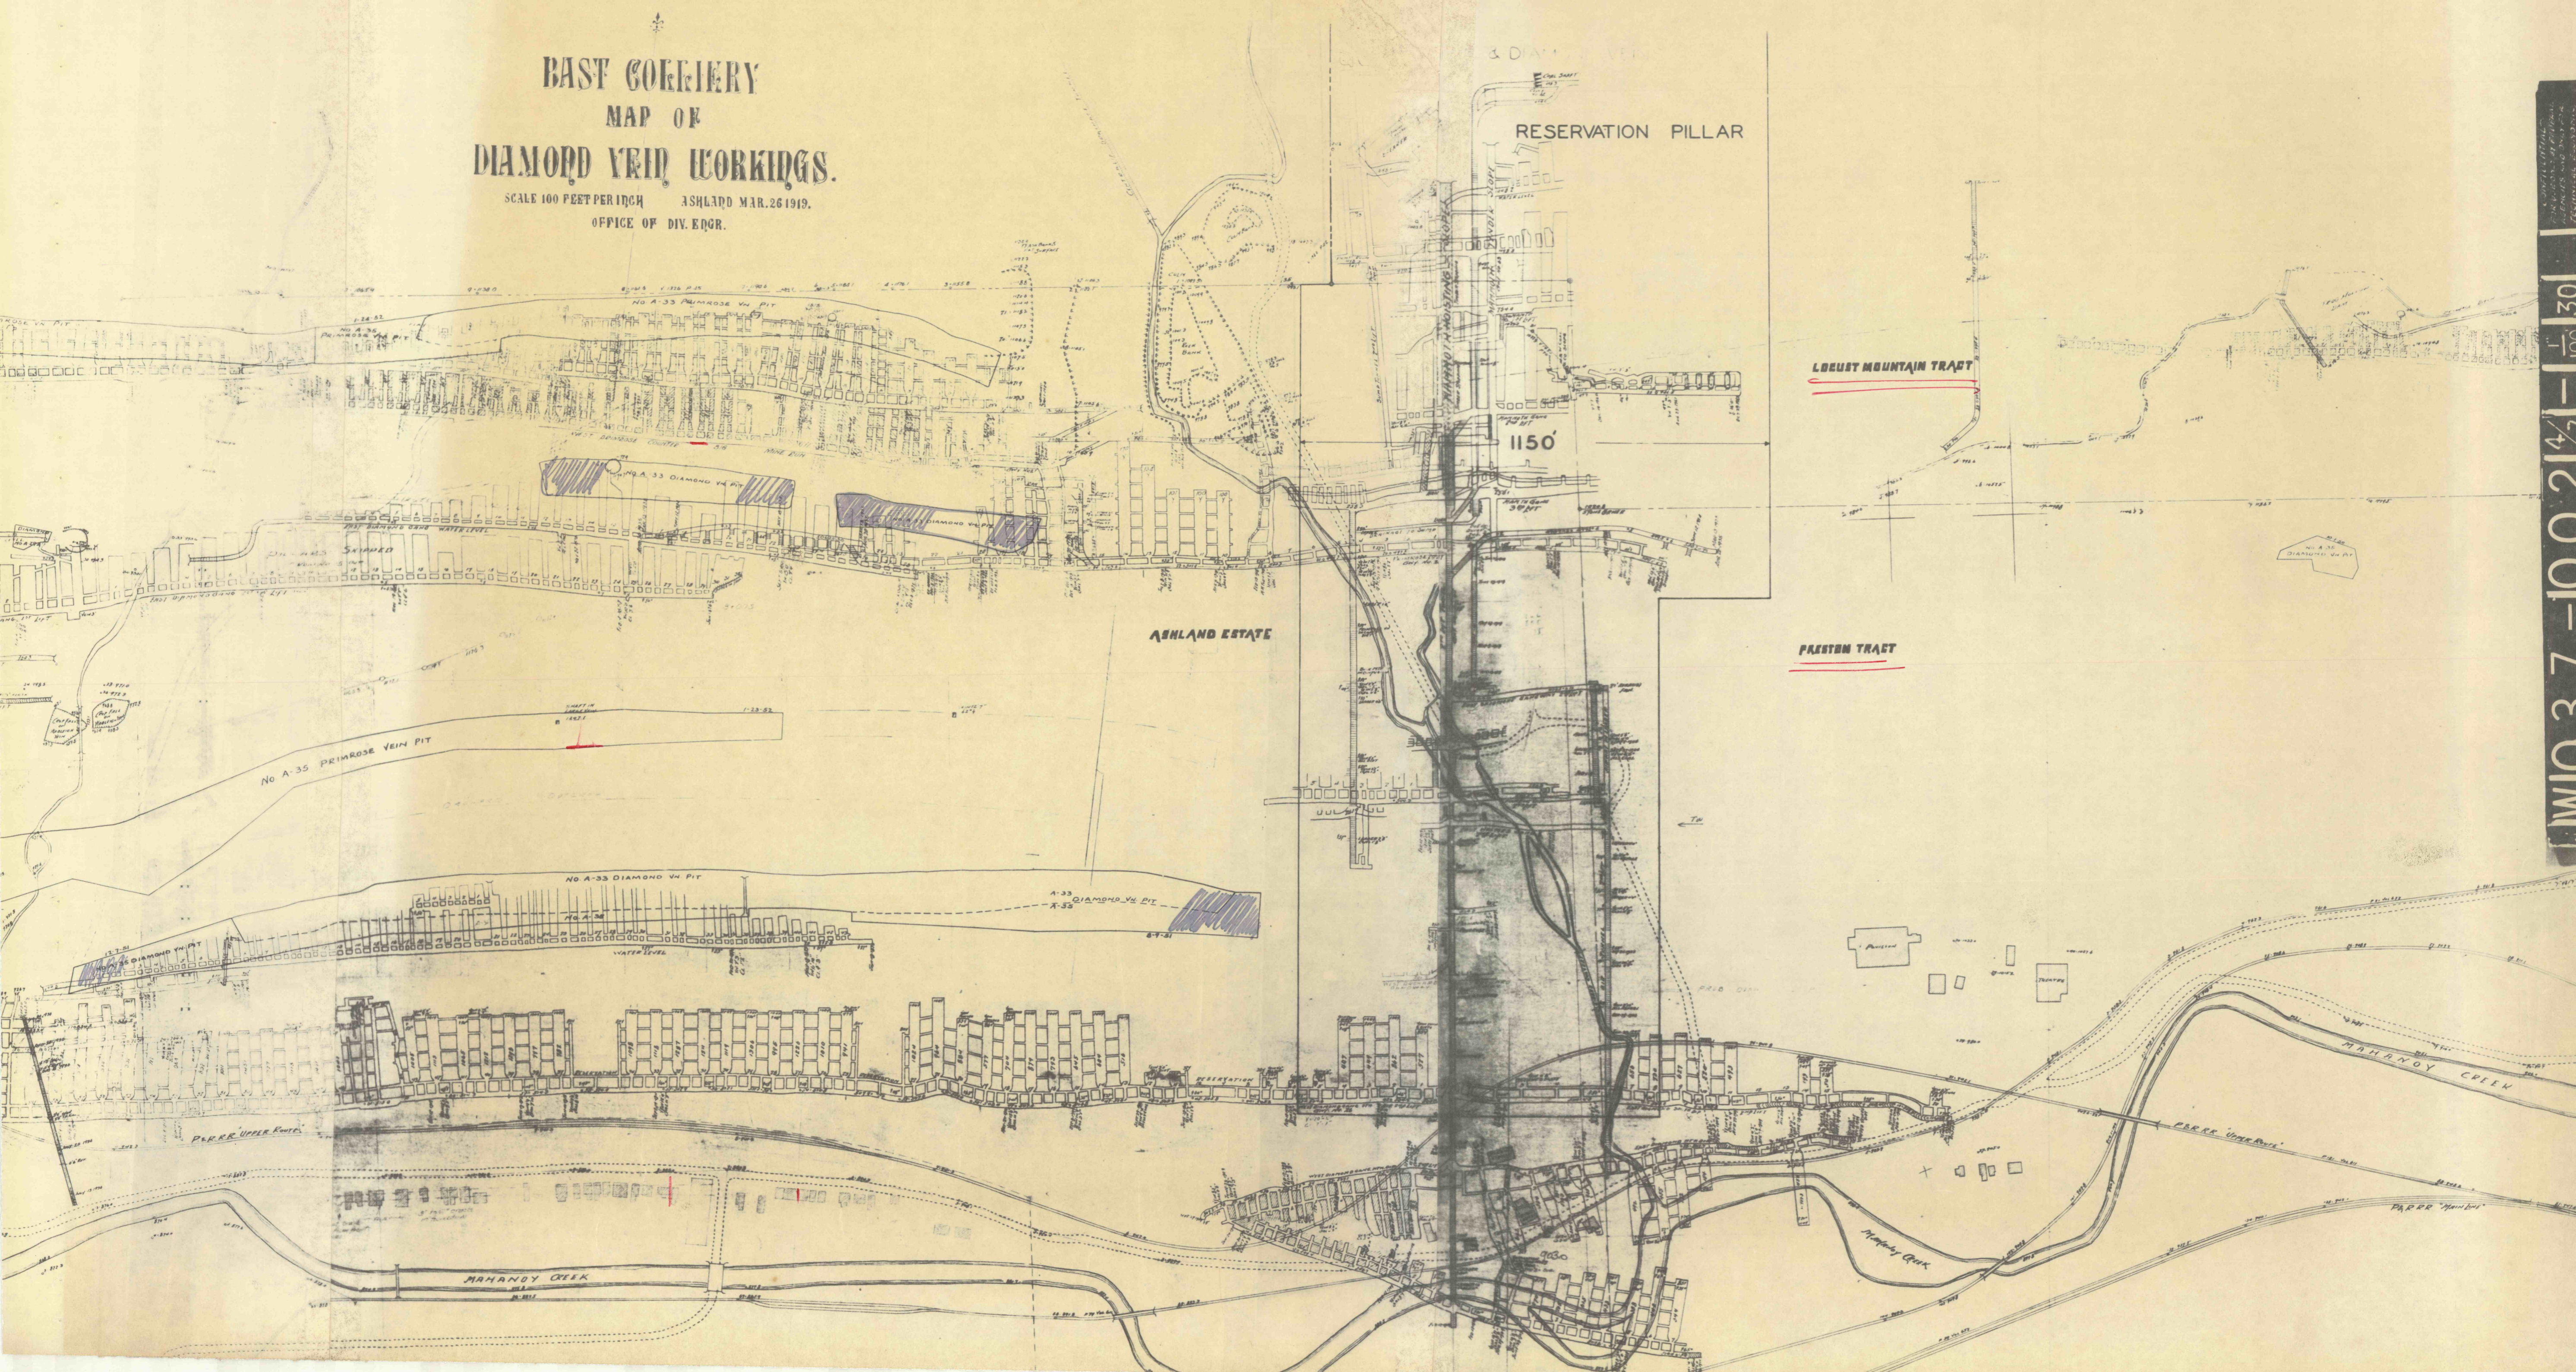

WIO 37-100214-130