


BAST COLLIER

SKIDMORE VEIN
AND
4th LIFT DEVELOPMENT
Scale 1 inch = 100 feet
Ashland
Office of Division Engineer.

RESERVATION PILLAR

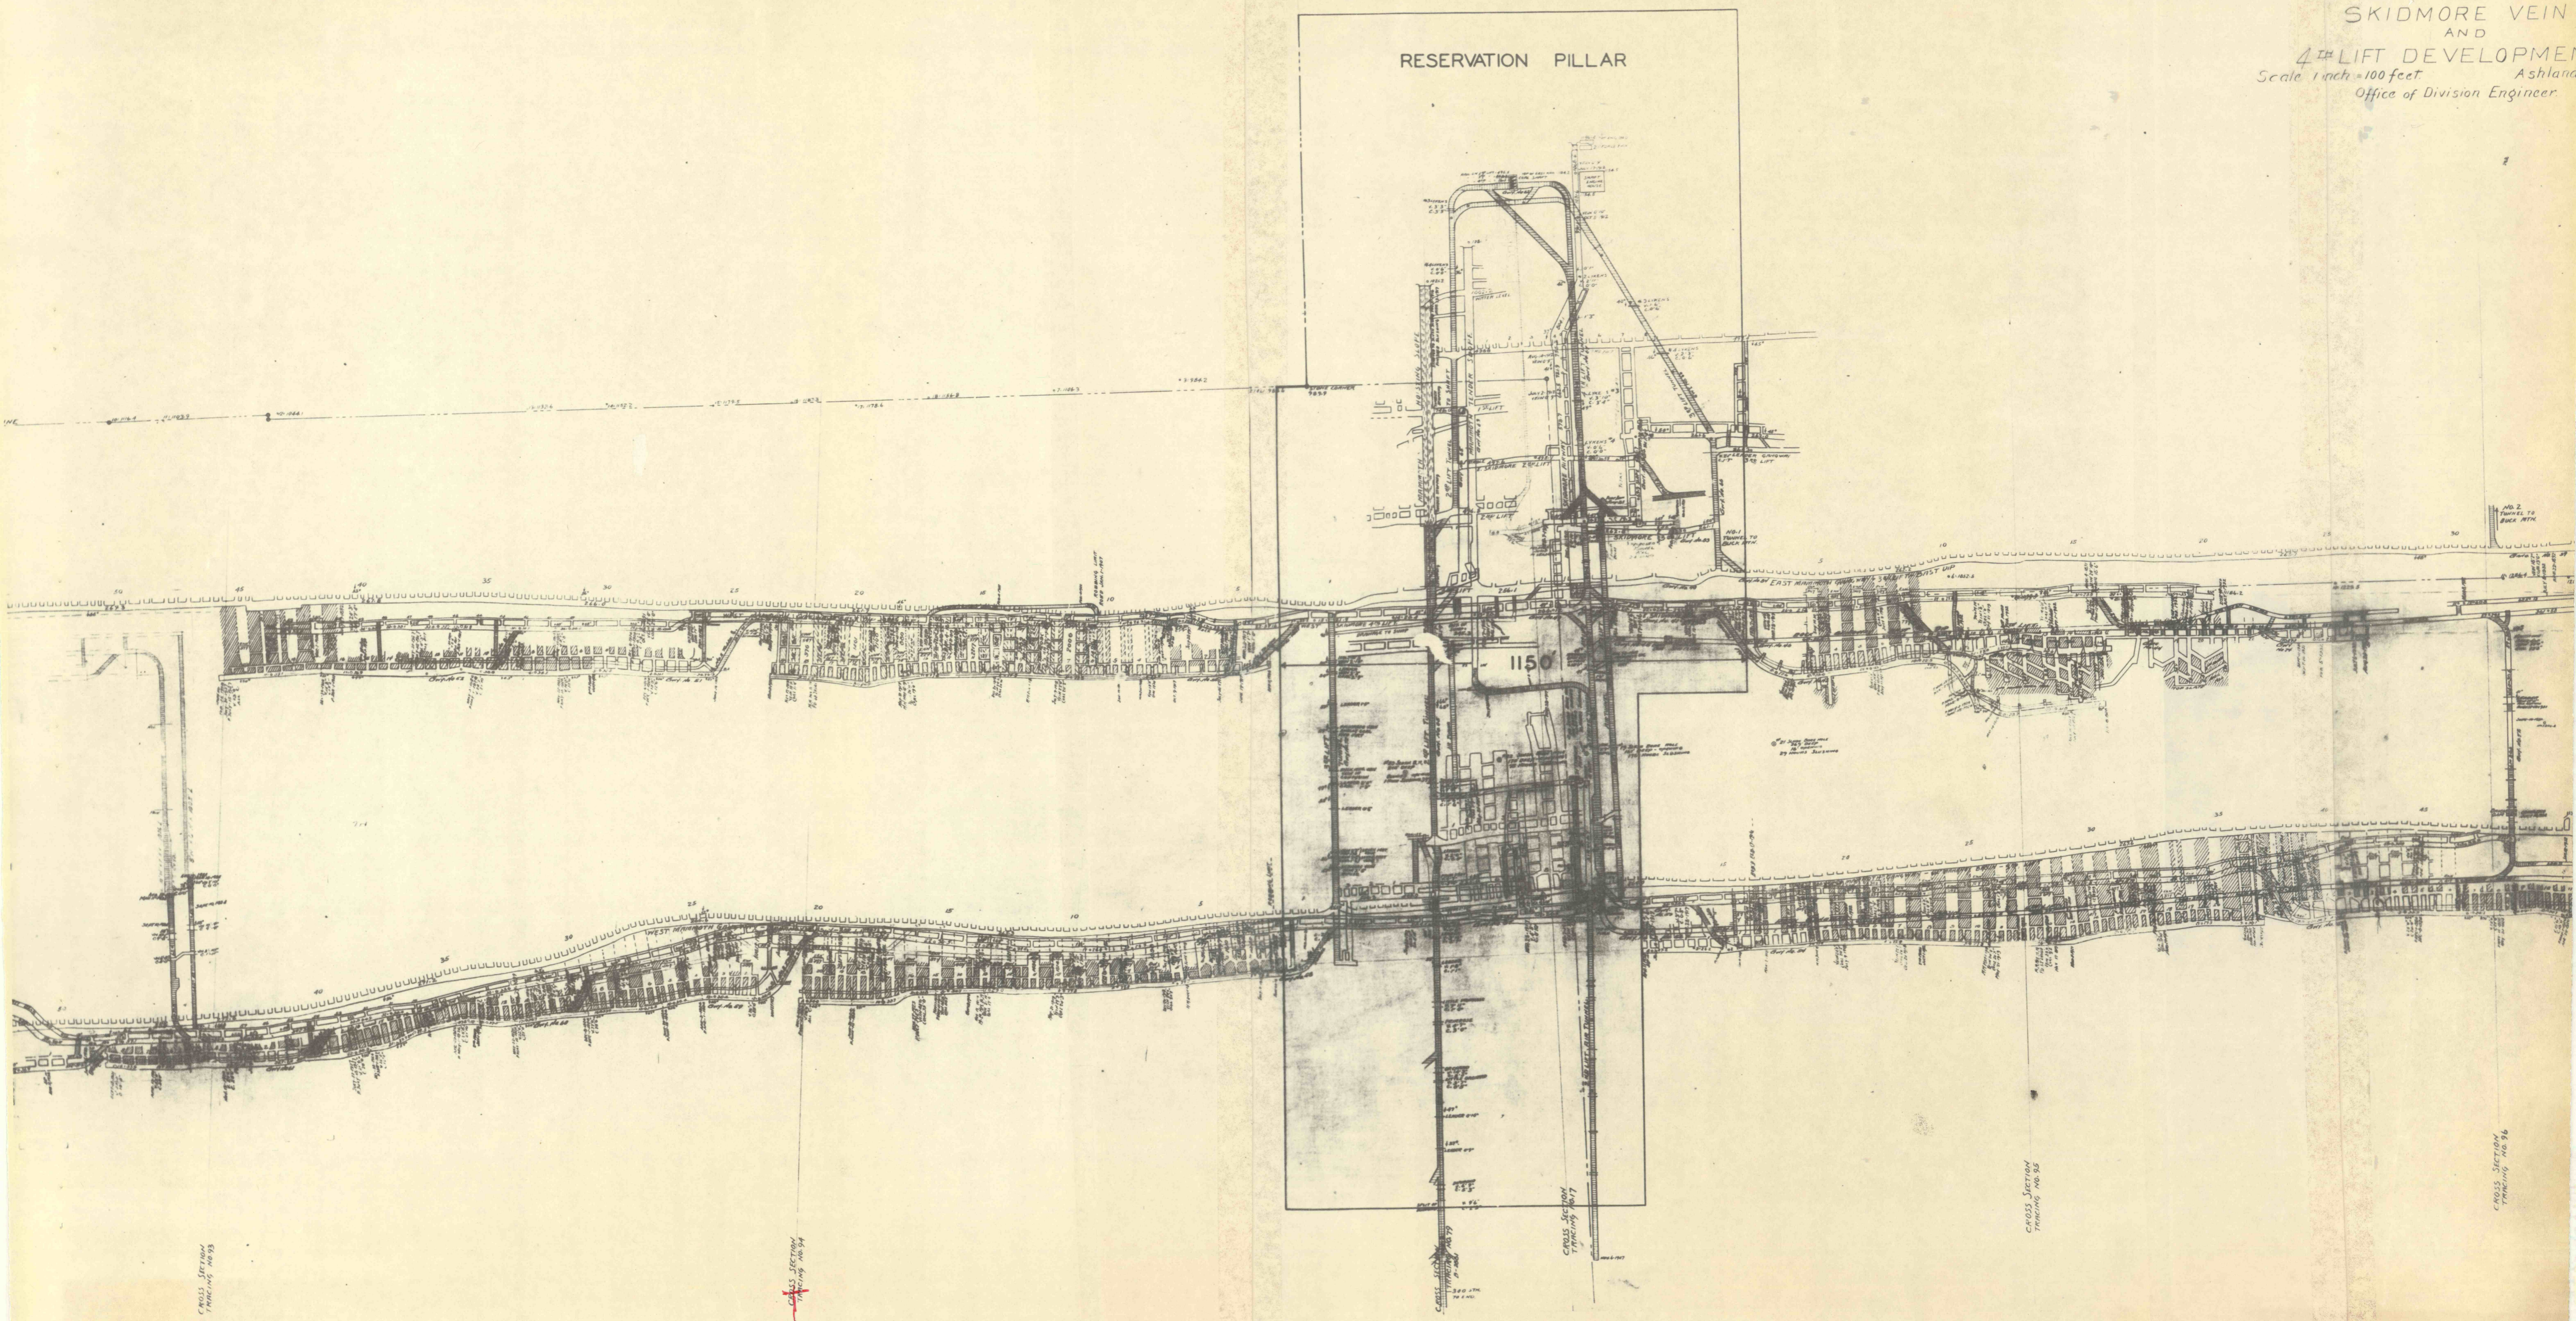

CROSS SECTION
TRACING NO. 93

CROSS SECTION
TRACING NO. 94

CROSS SECTION
TRACING NO. 97

CROSS SECTION
TRACING NO. 95

CROSS SECTION
TRACING NO. 96