


3501

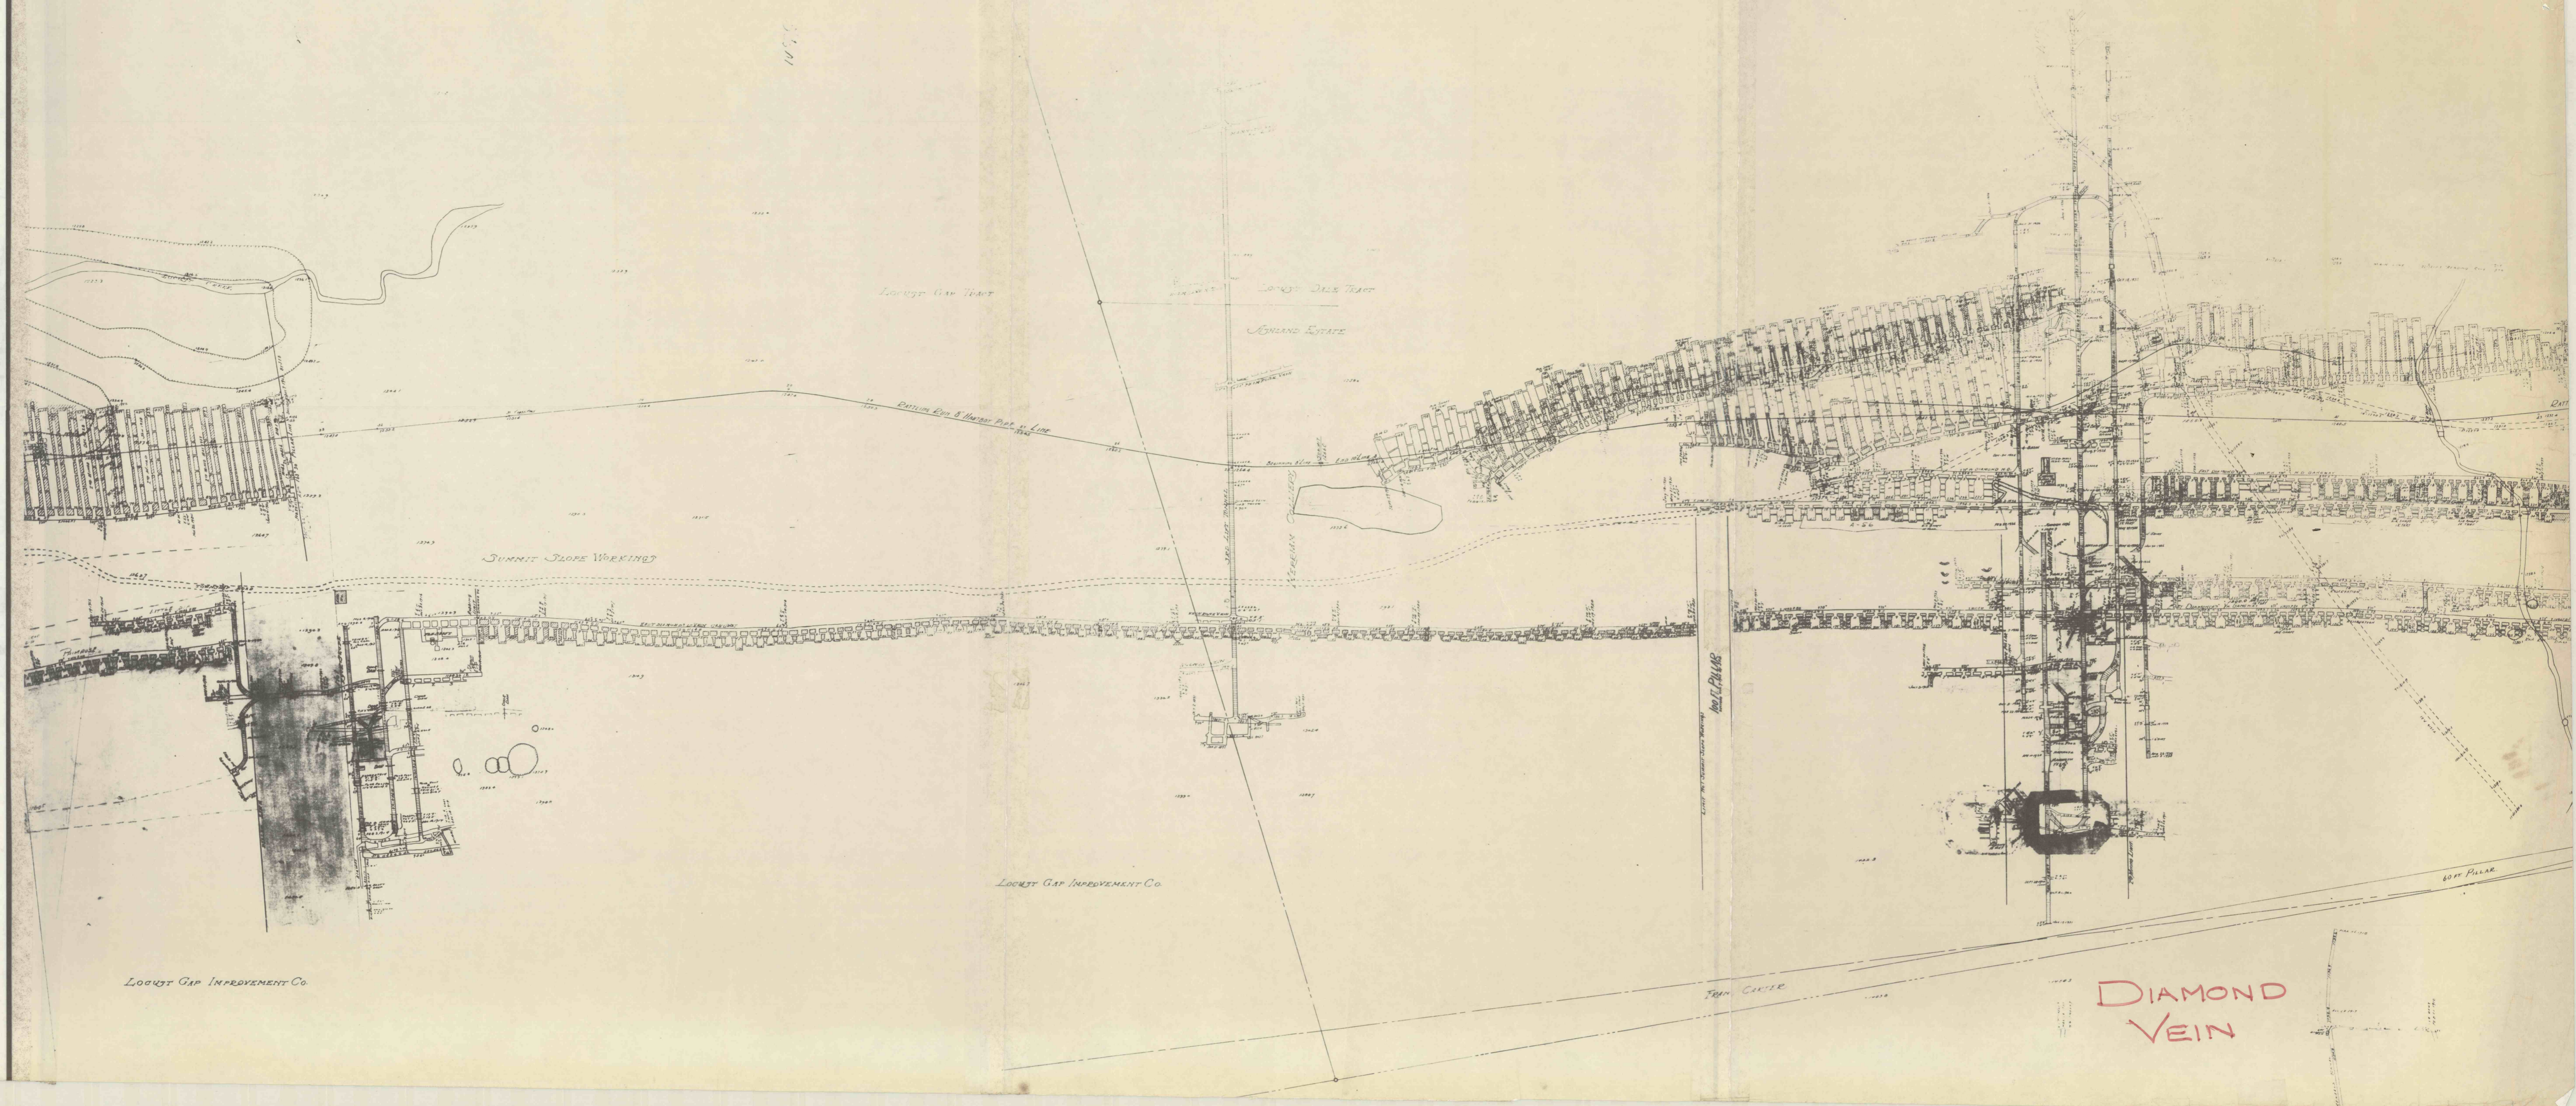



DIAMOND VEIN

TRAIL CUT

60 FT. PILLAR