


POSTING DATES	
FIRST MINING	ROBBING
DATE BY WHOM	DATE BY WHOM
1-25-23 M.C.	2-15-23 M.C.

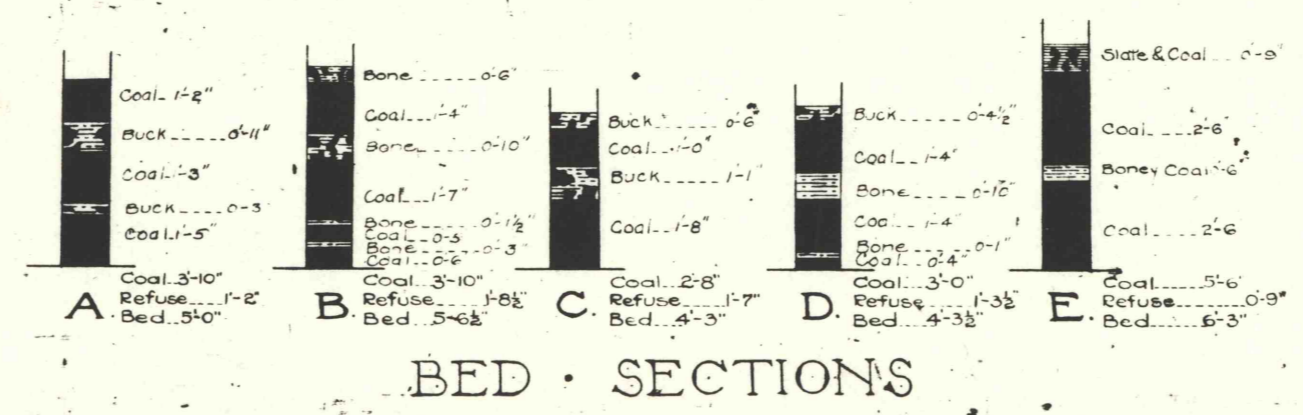

THE HUDSON COAL & IRON WORKS
 JERMYN COLLIERY
 WORKINGS IN THE
 TOP GRASSY ISLAND
 COAGE