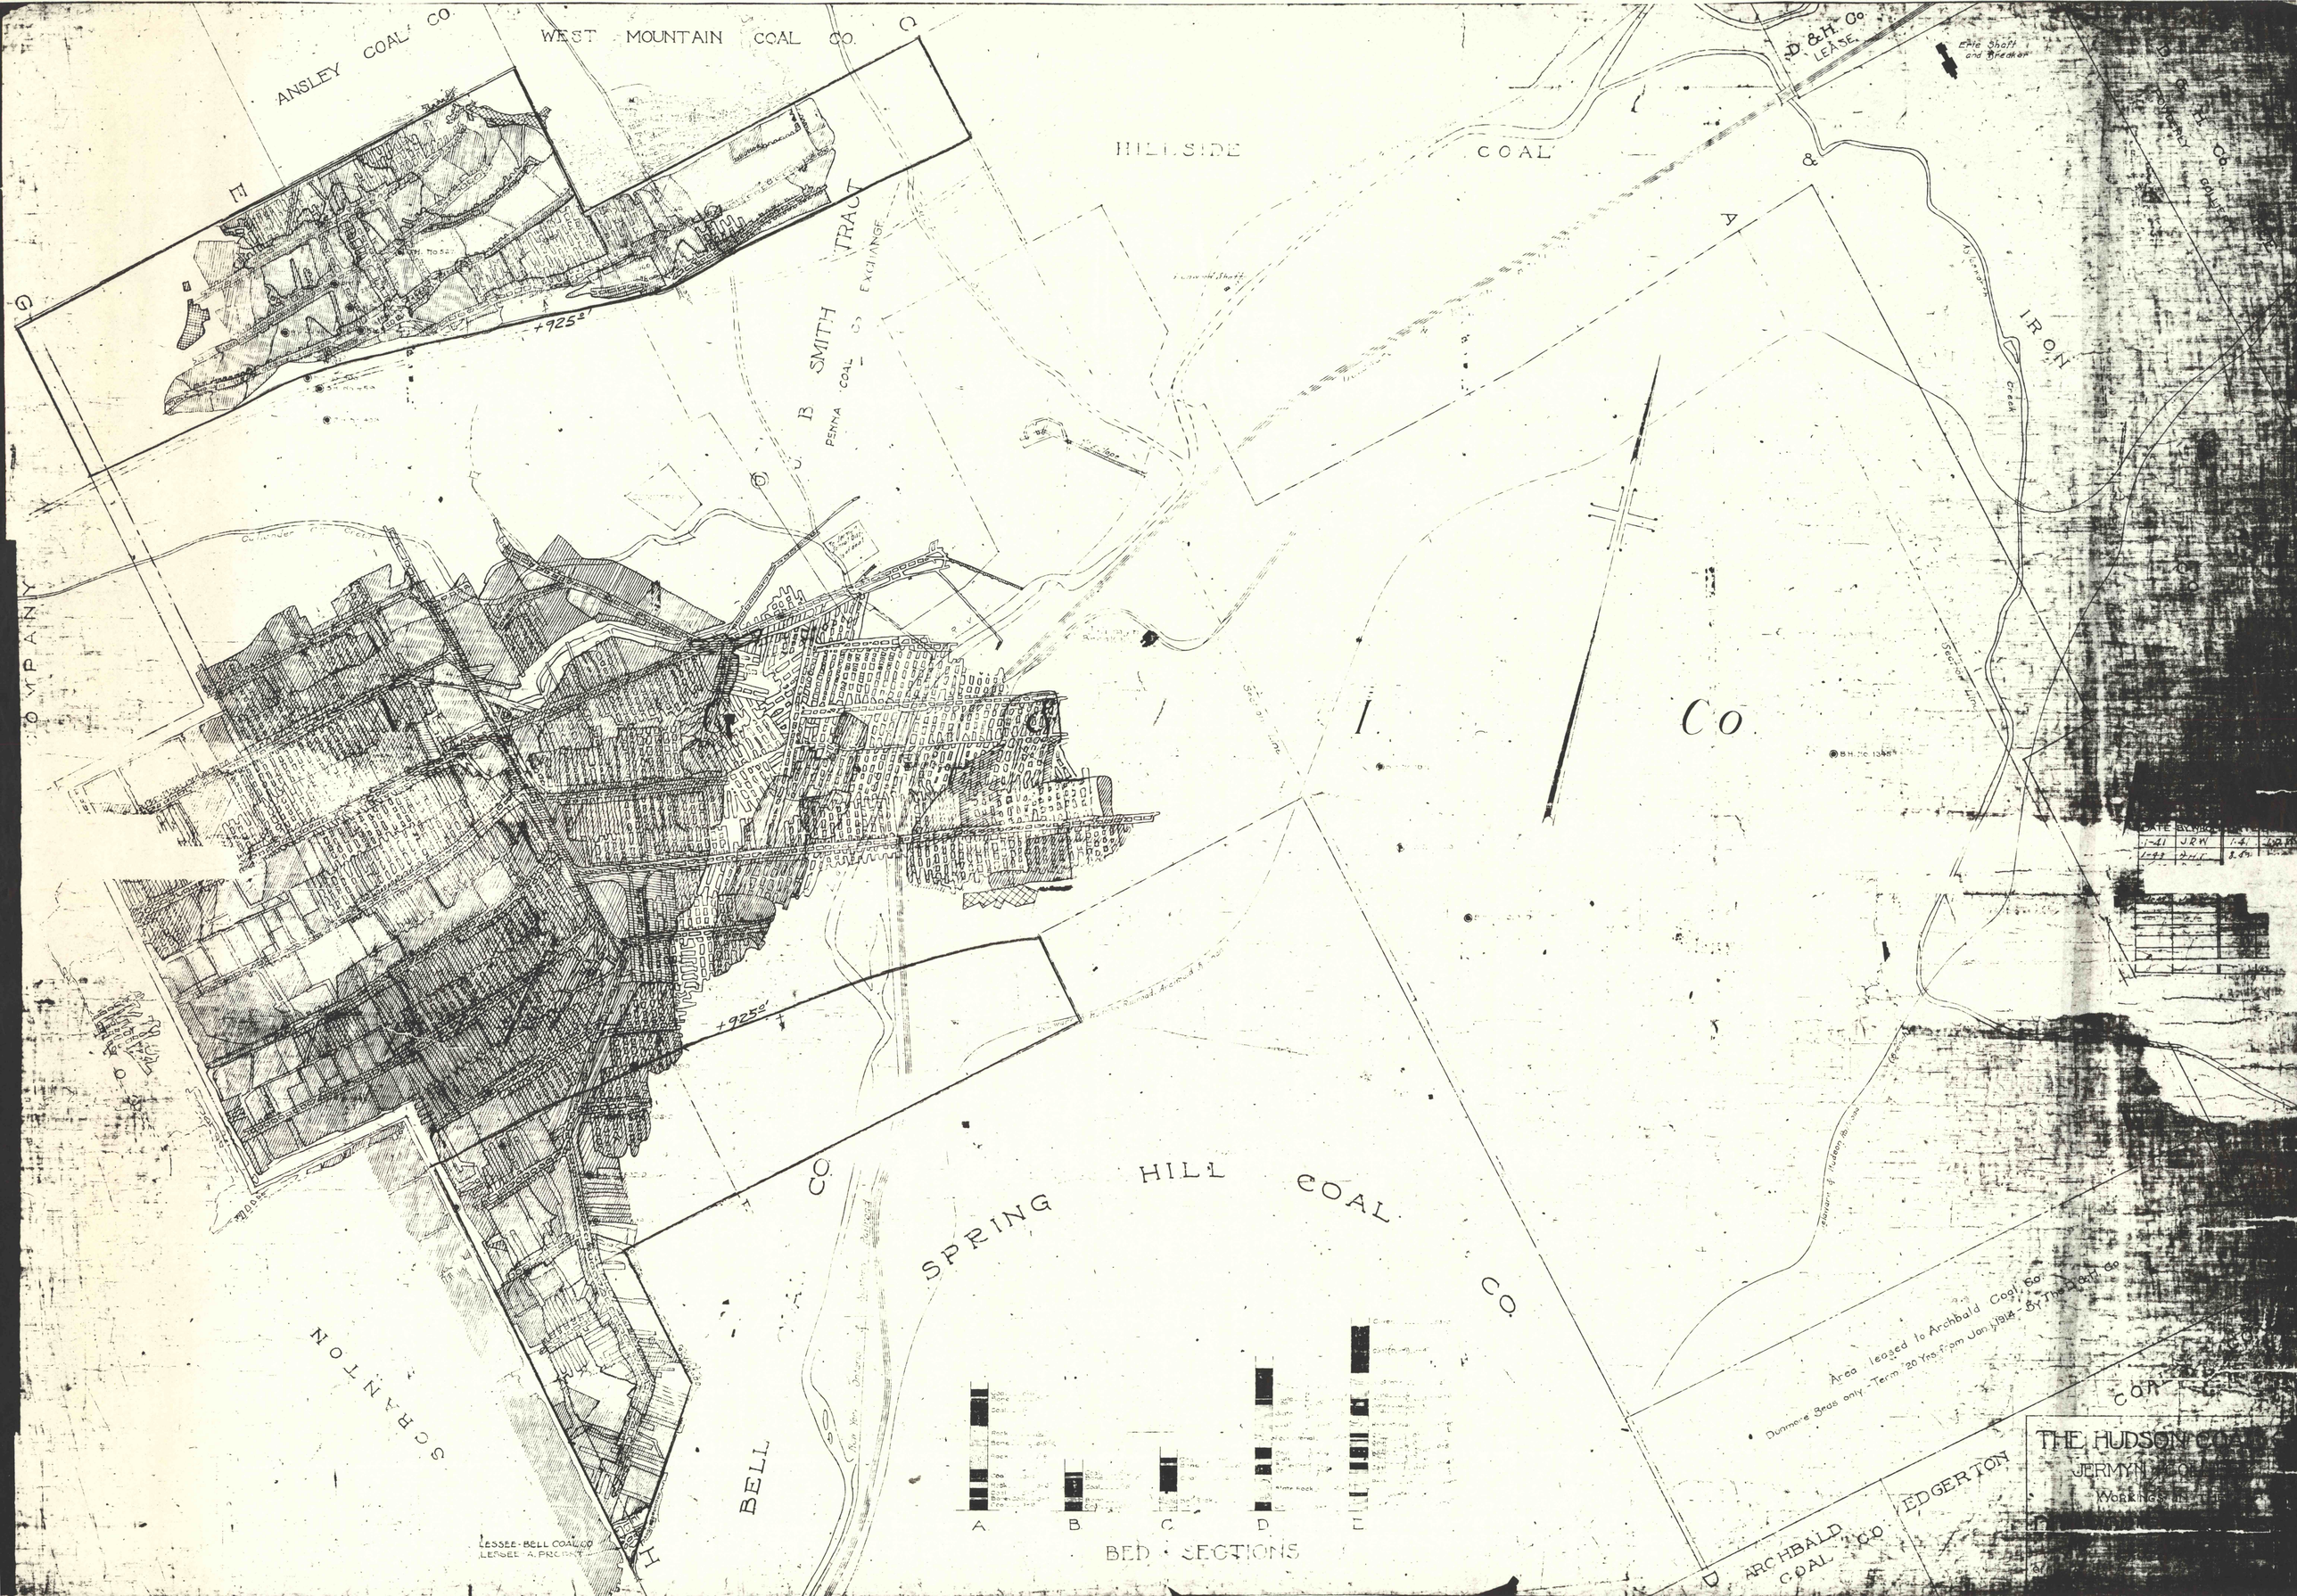

ANSLEY COAL CO.
WEST MOUNTAIN COAL CO.
HILLSIDE COAL
D. & H. Co. LEASE
Erie Shaft and Breaker
B. SMITH TRACT
PENNA COAL CO. EXCHANGE
+925'
IRON
Co.
SPRING HILL COAL CO.
BELL CO.
SCRANTON
LESSEE-BELL COAL CO.
LESSEE-A. PROCT
Area leased to Archbald Coal Co.
Dunmore Beds only - Term 20 Yrs from Jan. 1914 - By The D. & H. Co.
ARCHBALD COAL CO.
EDGERTON
A
B
C
D
E
BED SECTIONS
THE HUDSON COAL
JERMYN
WORKINGS