


DATE OF SURVEY			
FIRST MINING		ROBBING	
DATE	BY WHOM	DATE	BY WHOM
1-40	J.R.H.	1-20	J.R.H.
12-21	J.R.H.	1-23	J.R.H.
		2-28	J.R.H.
		7-26	J.R.H.
		11-22	J.R.H.
		1-23	J.R.H.
		3-28	J.R.H.
		5-28	J.R.H.

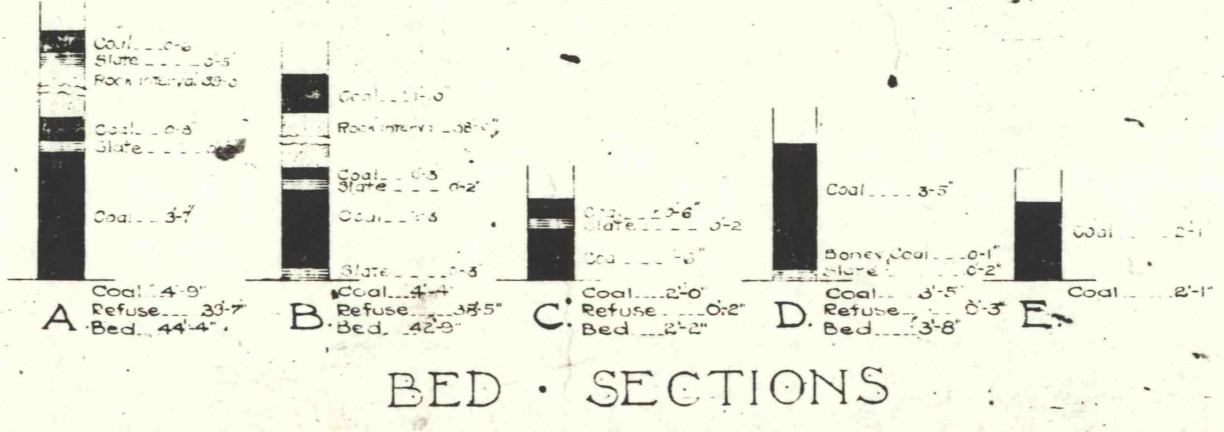

THE HUDSON COAL CO
 JERMYN COLLIERY
 WORKINGS IN THE
TOP-CLARK DE
 SHEET 400