


POSTING DATES		ROBBING	
FIRST MINING	DATE	DATE	BY WHOM
1-12-23	M.G.	1-12-23	M.G.
4-26-23	K.B.	4-26-23	K.B.
7-25	B.W.E.	7-25	B.W.E.
8-23	E.S.	8-23	E.S.
10-18-26	H.P.	10-18-26	H.P.
4-18-27	H.P.	4-18-27	H.P.
3-3-27	H.P.	3-3-27	H.P.
6-23-27	E.S.	6-23-27	E.S.
7-20	E.S.	7-20	E.S.
12-2-30	W.G.	12-2-30	W.G.
1-2	J.H.T.	1-2	J.H.T.
* DATE OF SURVEY		W.G.	
12-29	J.H.	1-21	J.H.
1-21	J.H.	1-21	J.H.
1-21	J.H.	1-21	J.H.
1-2	J.H.T.	1-2	J.H.T.

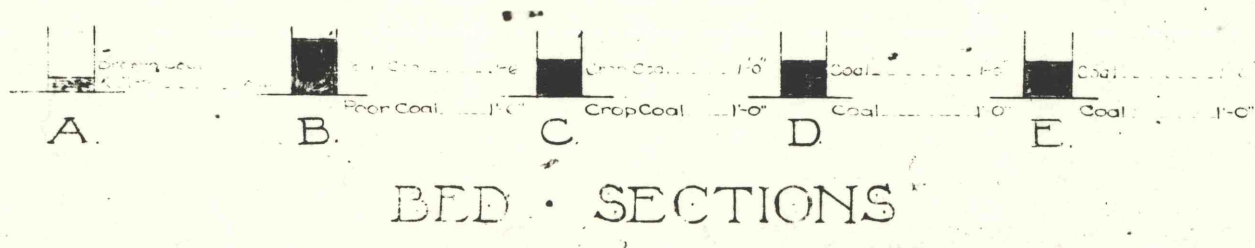

THE HUDSON COAL CO.
 JERMYN COLLIERY
 WORKINGS IN THE
ROCK BED
 SCALE 1"=400'
 Office of
 Forecast Dept.
 State Dept.