

ANSLEY COAL CO

WEST MOUNTAIN COAL CO

HILLSIDE COAL

D. & H. Co. LEASE

D. S. H. CO. COLLIERIES

IRON

TRACT ANGE

MEADY COMPANY

SCRANTON

D & H Co

BELL COAL CO

SPRING HILL COAL CO


CO

ARCHBALD COAL CO

EDGERTON

THE HUDSON COAL JERMYN COLLIERY WORKINGS IN THE GRASSY ISLAND

DATE OF SURVEY	
FIRST FINING	ROBBINS
DATE BYWHM	DATE BYWHM
12-11-07	12-11-07
12-11-07	12-11-07
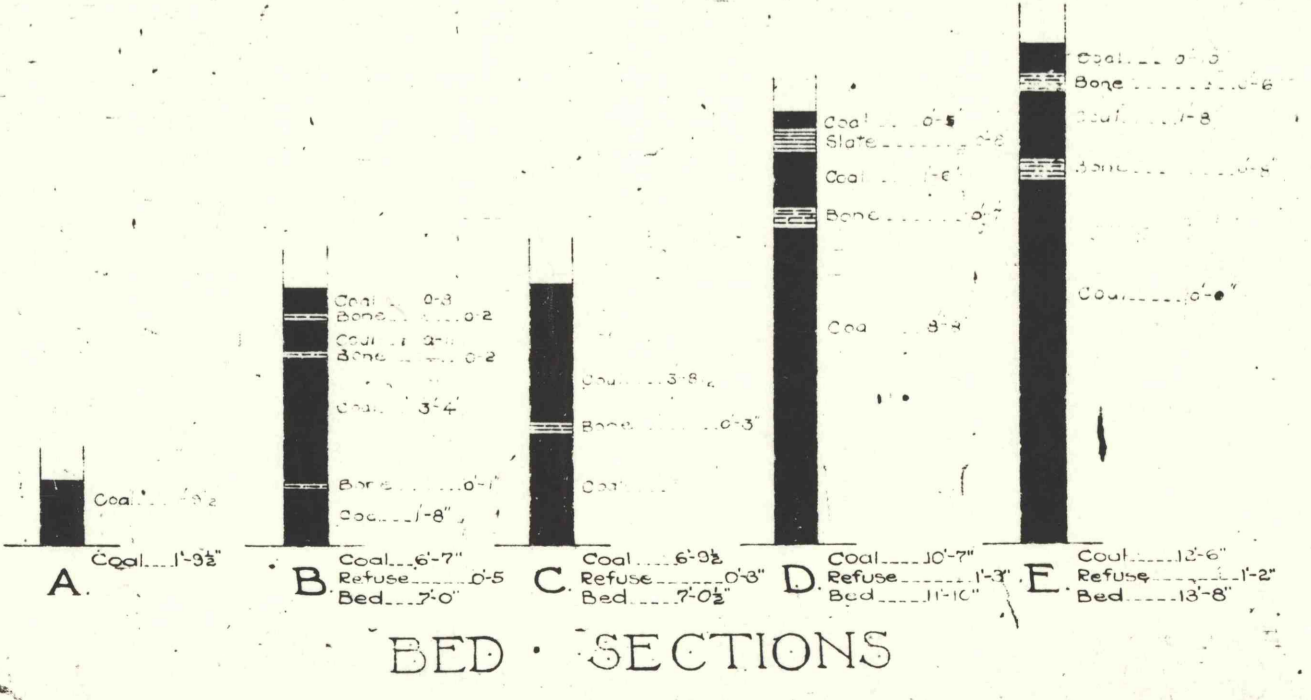

SCALE 1" = 400'