
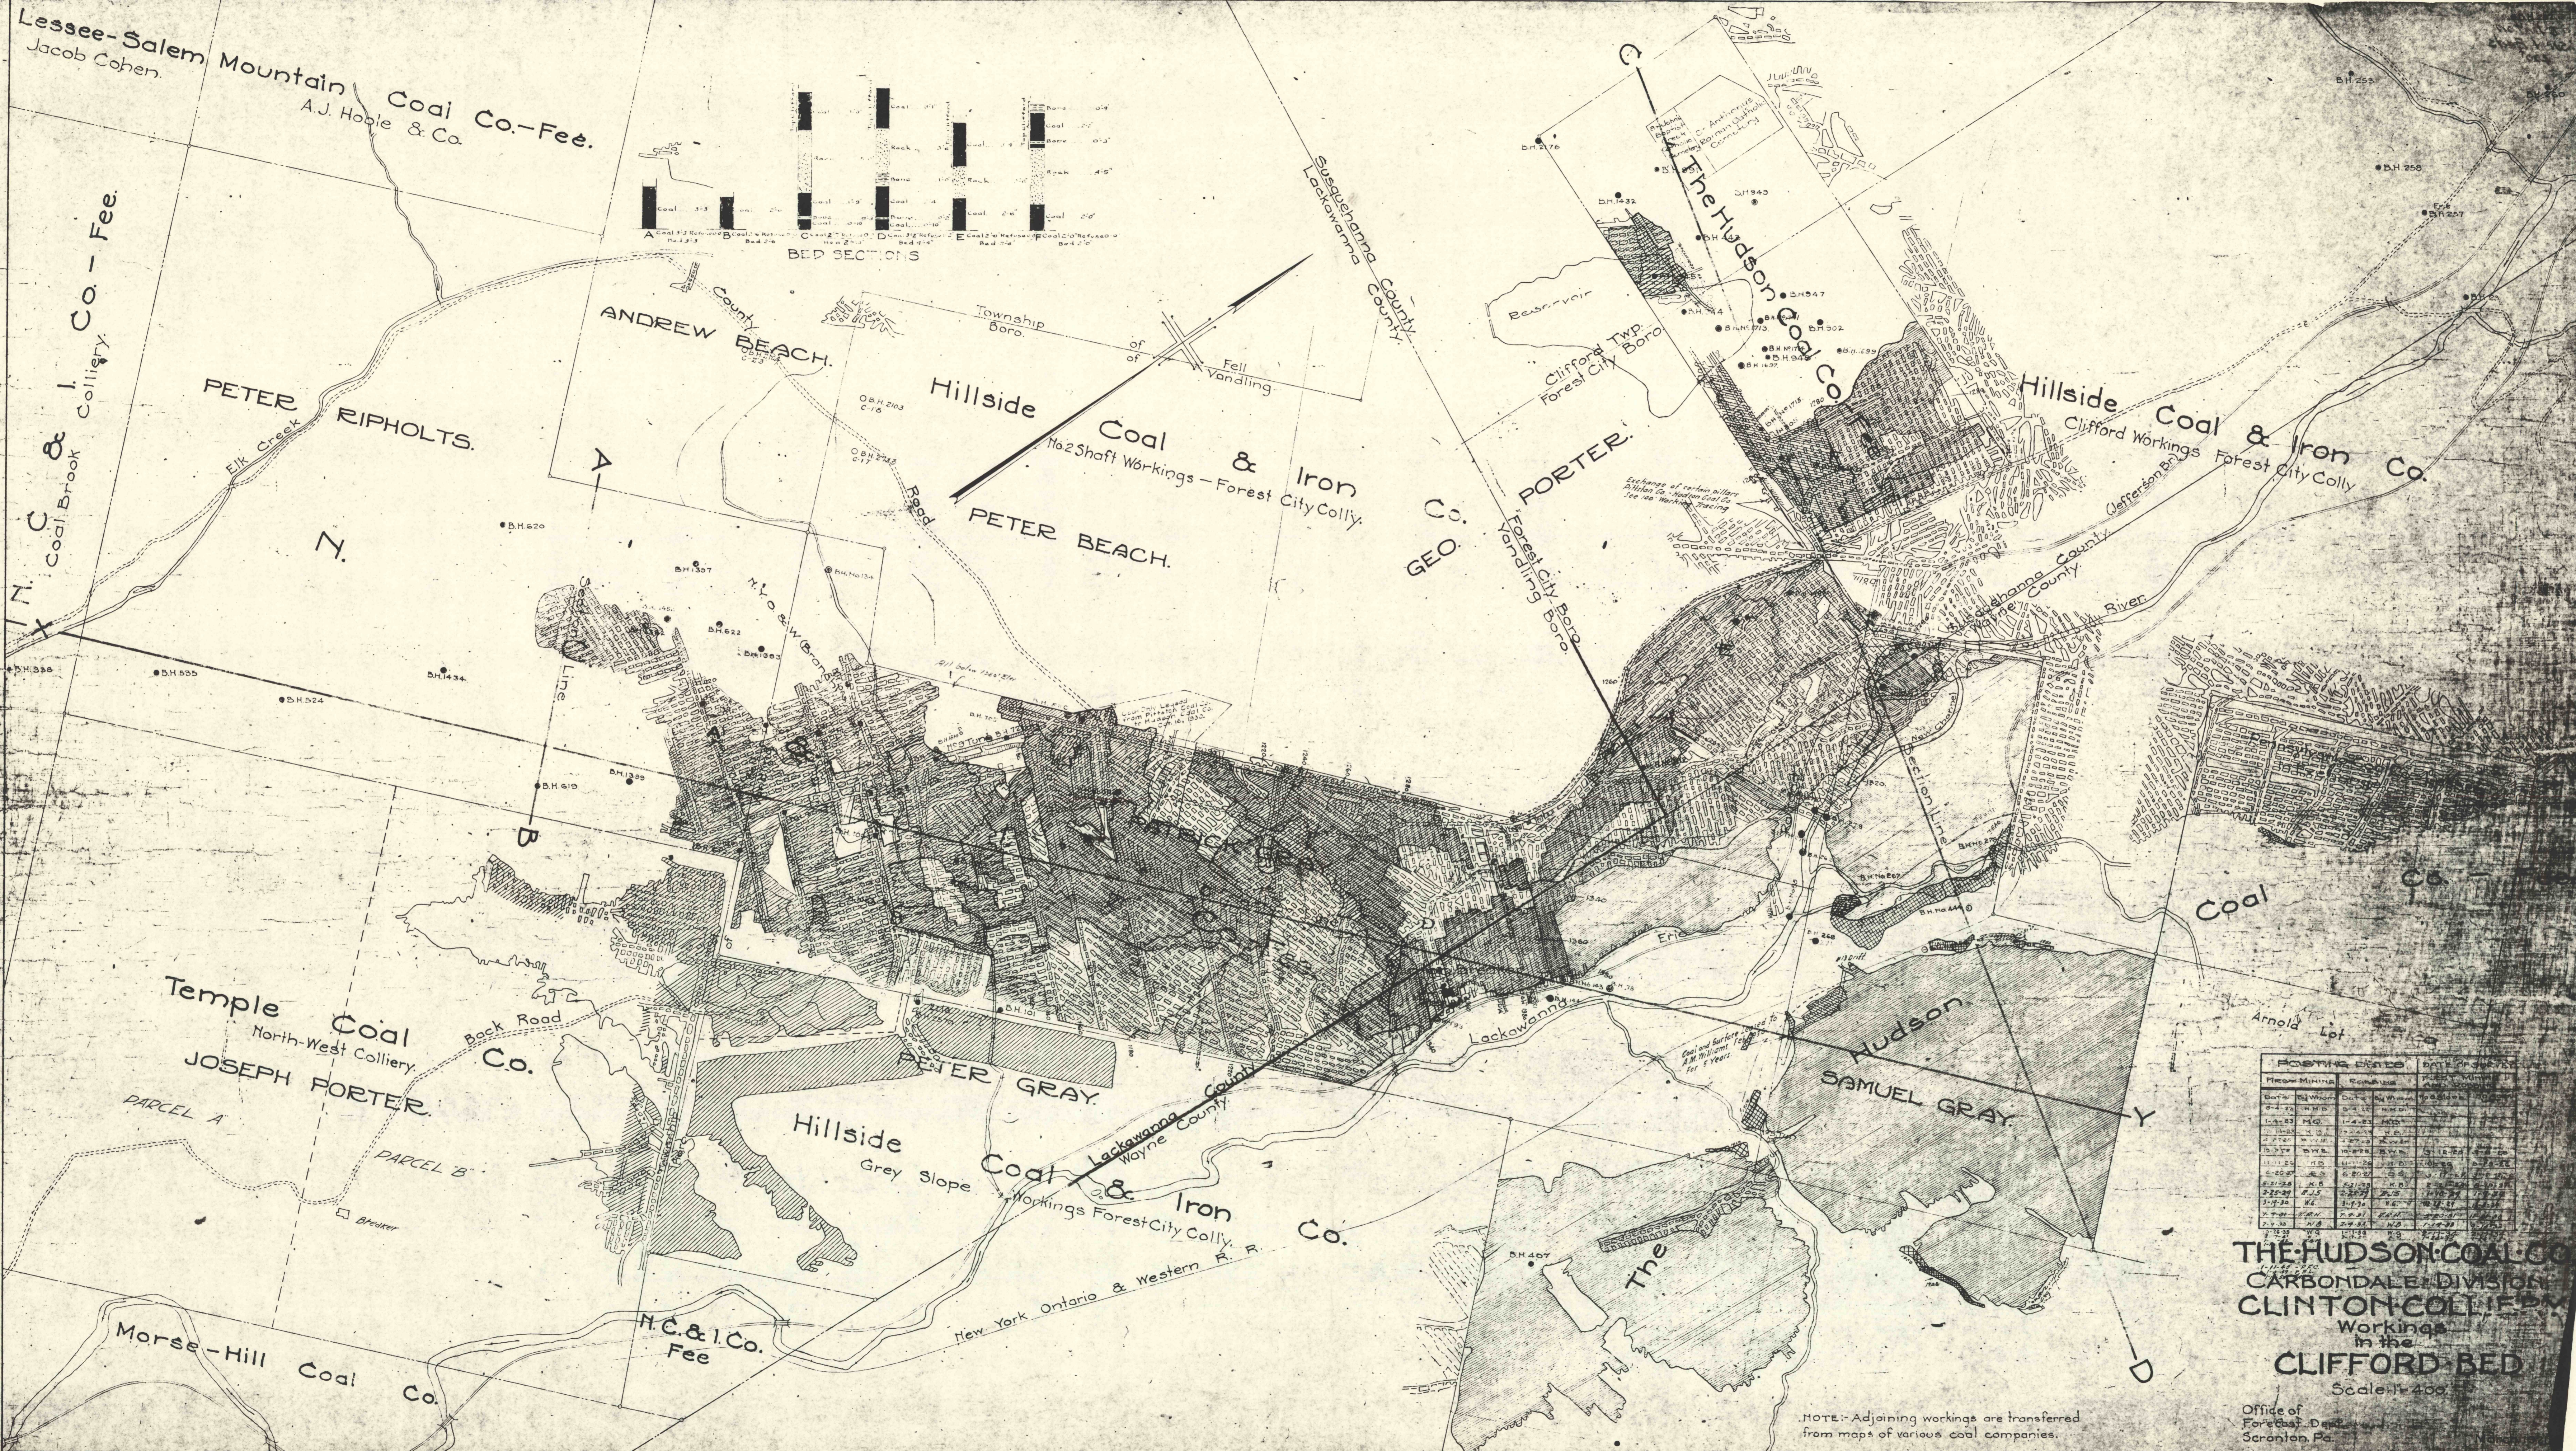


Lessee-Salem Mountain Coal Co.-Fee.
Jacob Cohen.
A.J. Hoole & Co.

C & I Coal, Brook Colliery Co.-Fee.

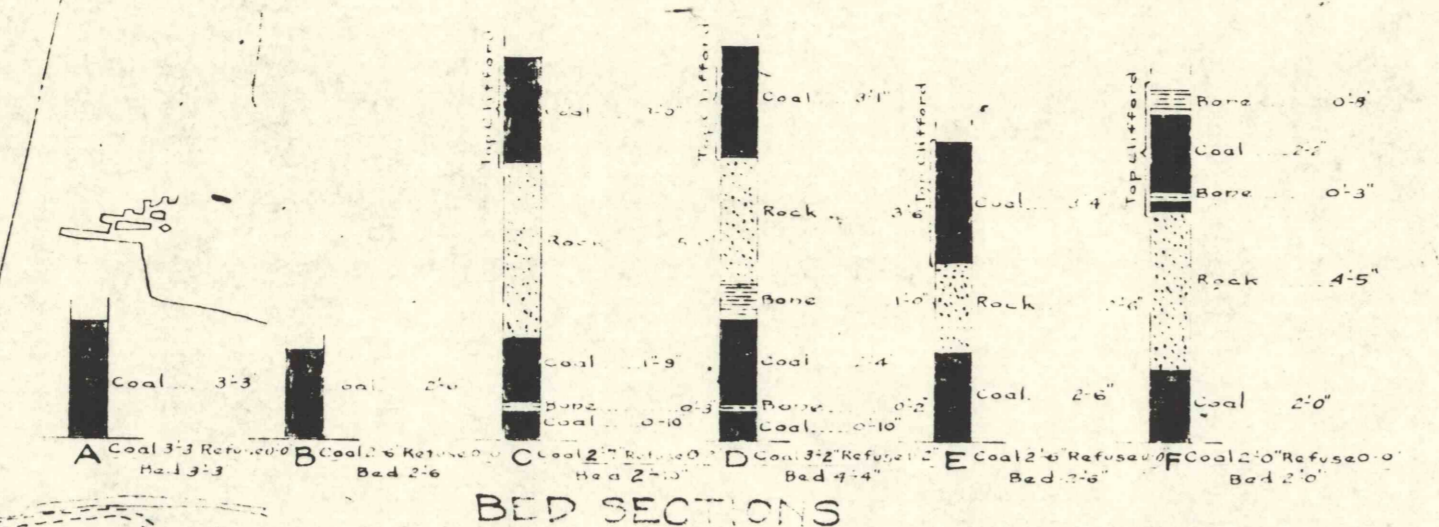

RECOVERING DATES		DATE OF SURVEY	
From Mine	From Shaft	From Mine	From Shaft
1884-85	1884-85	1884-85	1884-85

THE HUDSON COAL CO.
CARBONDALE DIVISION
CLINTON COLLIERY
Workings
in the
CLIFFORD BED
Scale: 1" = 400'

NOTE: Adjoining workings are transferred from maps of various coal companies.

Office of
Forest City
Scranton, Pa.