


Lessee-Salem Mountain Coal Co.-Fee.
Jacob Cohen.
A.J. Hoole & Co.

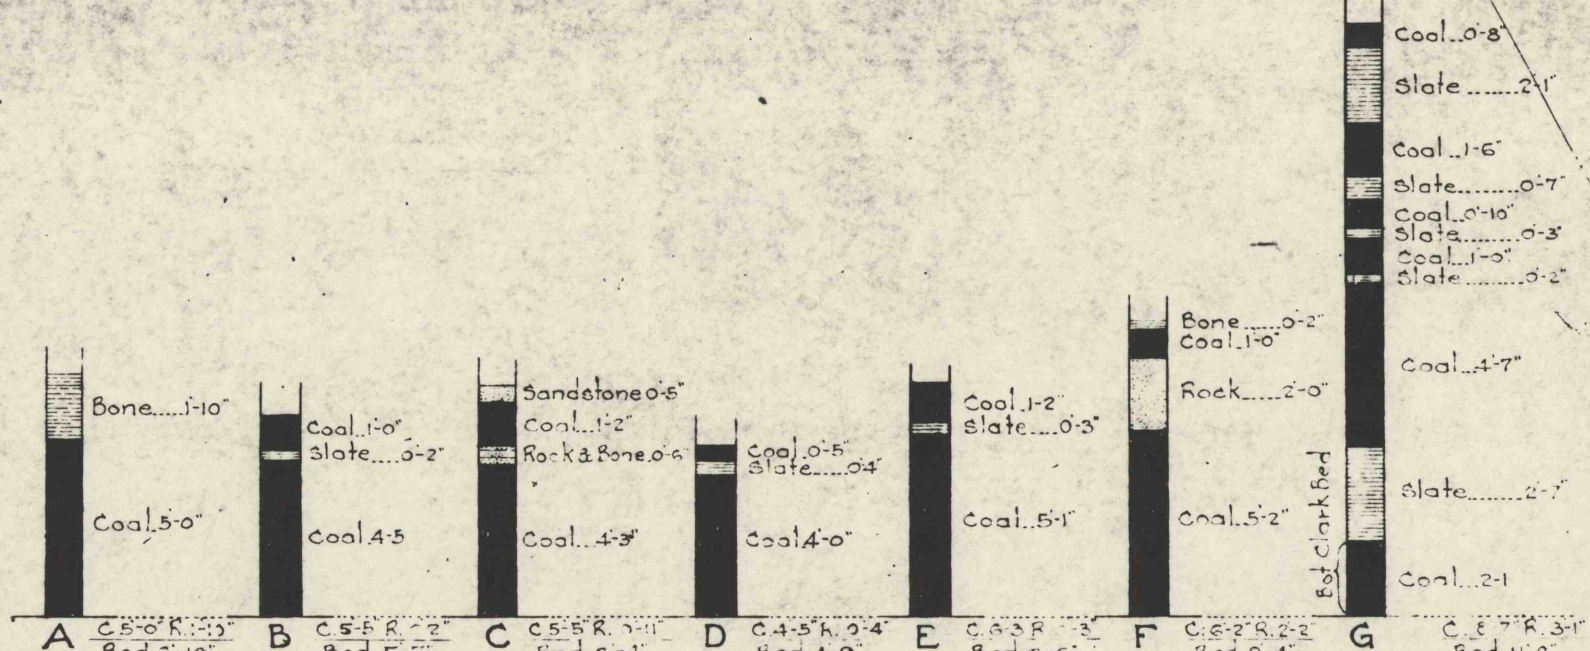

POSTING DATES		DATE OF SURVEY		100 ACRES NO. 38 OF COAL BED
FIRST MINING	ROBBING	FIRST MINING	ROBBING	
8-3-11	N.H.C.	8-3-11	N.H.C.	
1-3-23	M.C.	1-3-23	M.C.	
12-14-23	M.C.	12-14-23	M.C.	
5-27-29	D.W.L.	4-27-29	D.W.L.	
10-2-26	B.W.L.	10-2-26	B.W.L.	
6-21-27	E.S.	6-21-27	E.S.	
5-21-16	M.C.	5-21-16	M.C.	
2-27-29	E.S.	2-27-29	E.S.	
3-2-11	M.C.	3-2-11	M.C.	
2-1-21	M.C.	2-1-21	M.C.	
2-1-21	E.V.	2-1-21	E.V.	

THE HUDSON COAL CO.
CARBONDALE DIVISION
CLINTON COLLIERY
Workings
in the
TOP CLARK

Scale: 1" = 400'
Office of Forecast Dept. Scranton, Pa.
March, 1921

NOTE:—Adjoining workings are transferred from maps of various coal companies.