
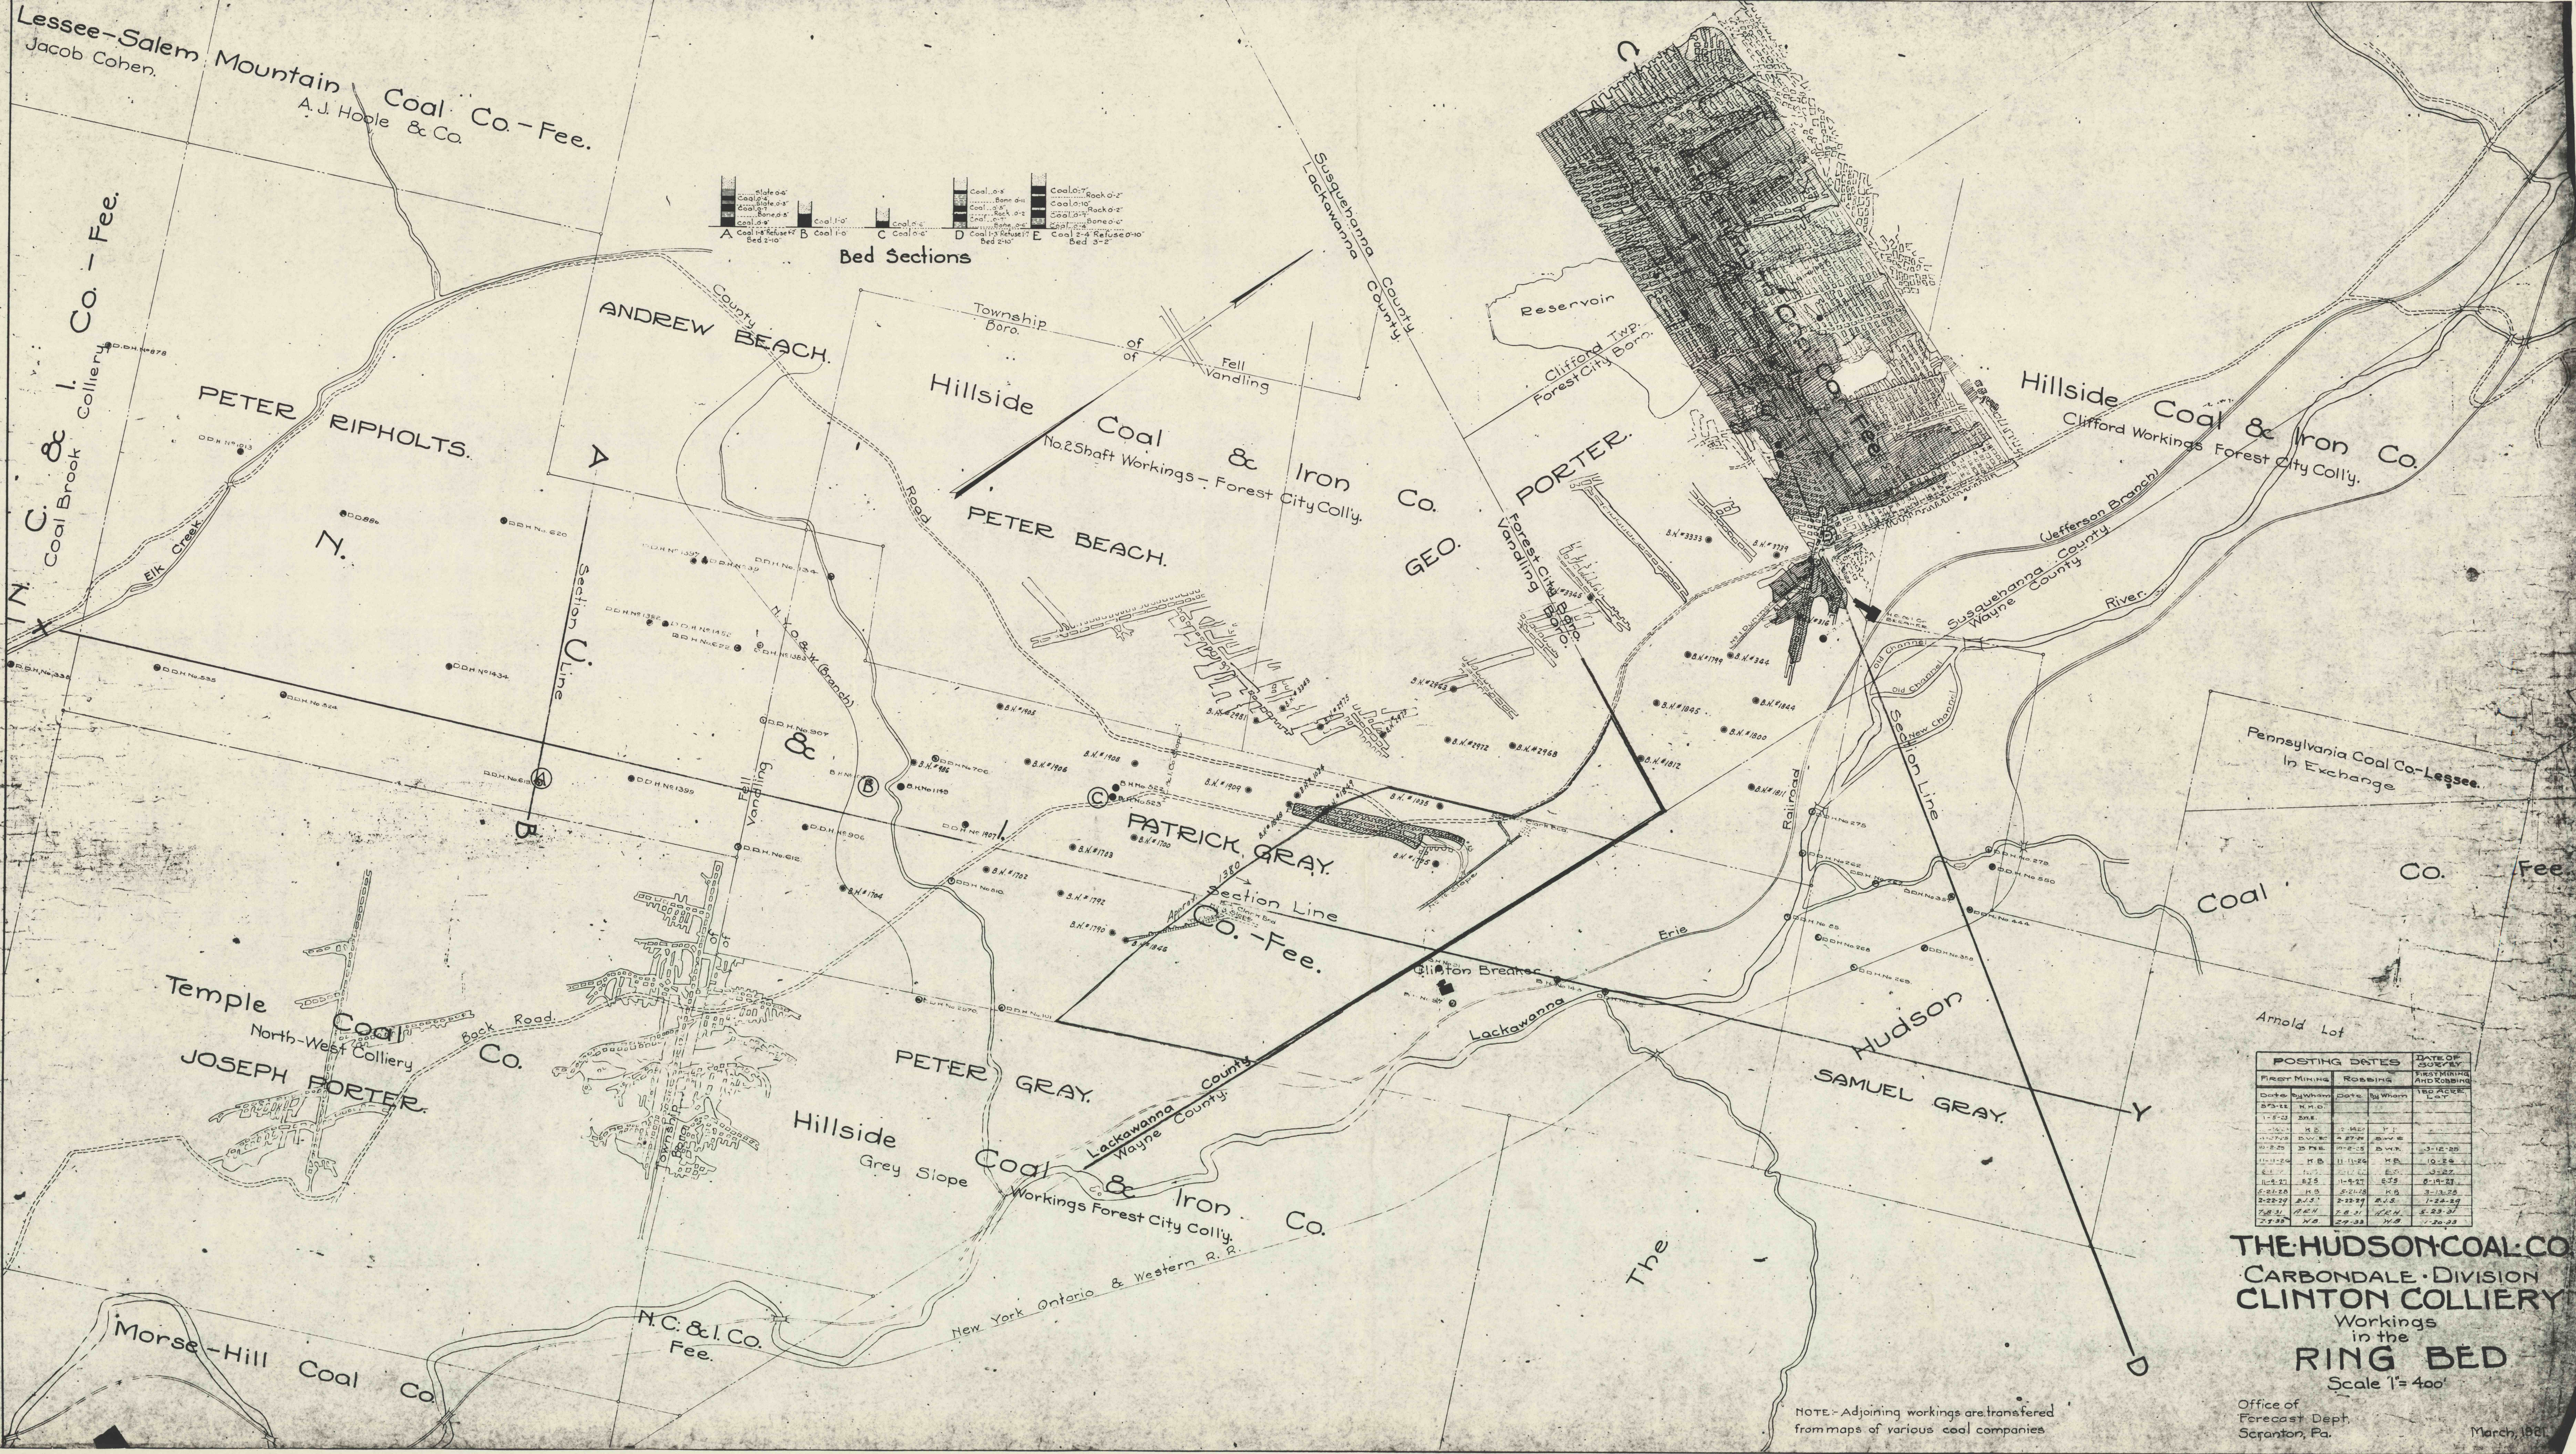


Lessee-Salem Mountain Coal Co.-Fee.  
Jacob Cohen.  
A.J. Hoole & Co.

C. & I. Co. - Fee.  
Coal Brook Colliery

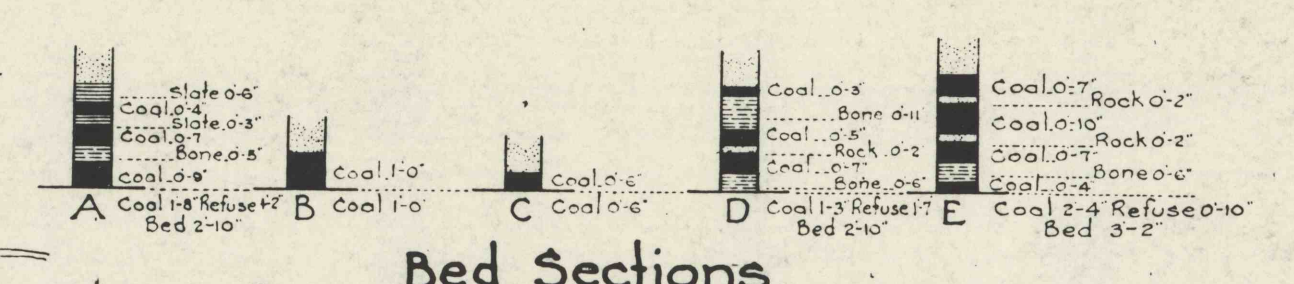

POSTING DATES		DATE OF SURVEY	
FIRST MINING	ROBBING	FIRST MINING	ROBBING
1875-18	N.M.D.	1875-18	N.M.D.

**THE HUDSON COAL CO.**  
CARBONDALE DIVISION  
**CLINTON COLLIERY**  
Workings  
in the  
**RING BED**  
Scale 1" = 400'

NOTE-Adjoining workings are transferred from maps of various coal companies

Office of Forecast Dept. Scranton, Pa. March, 1901