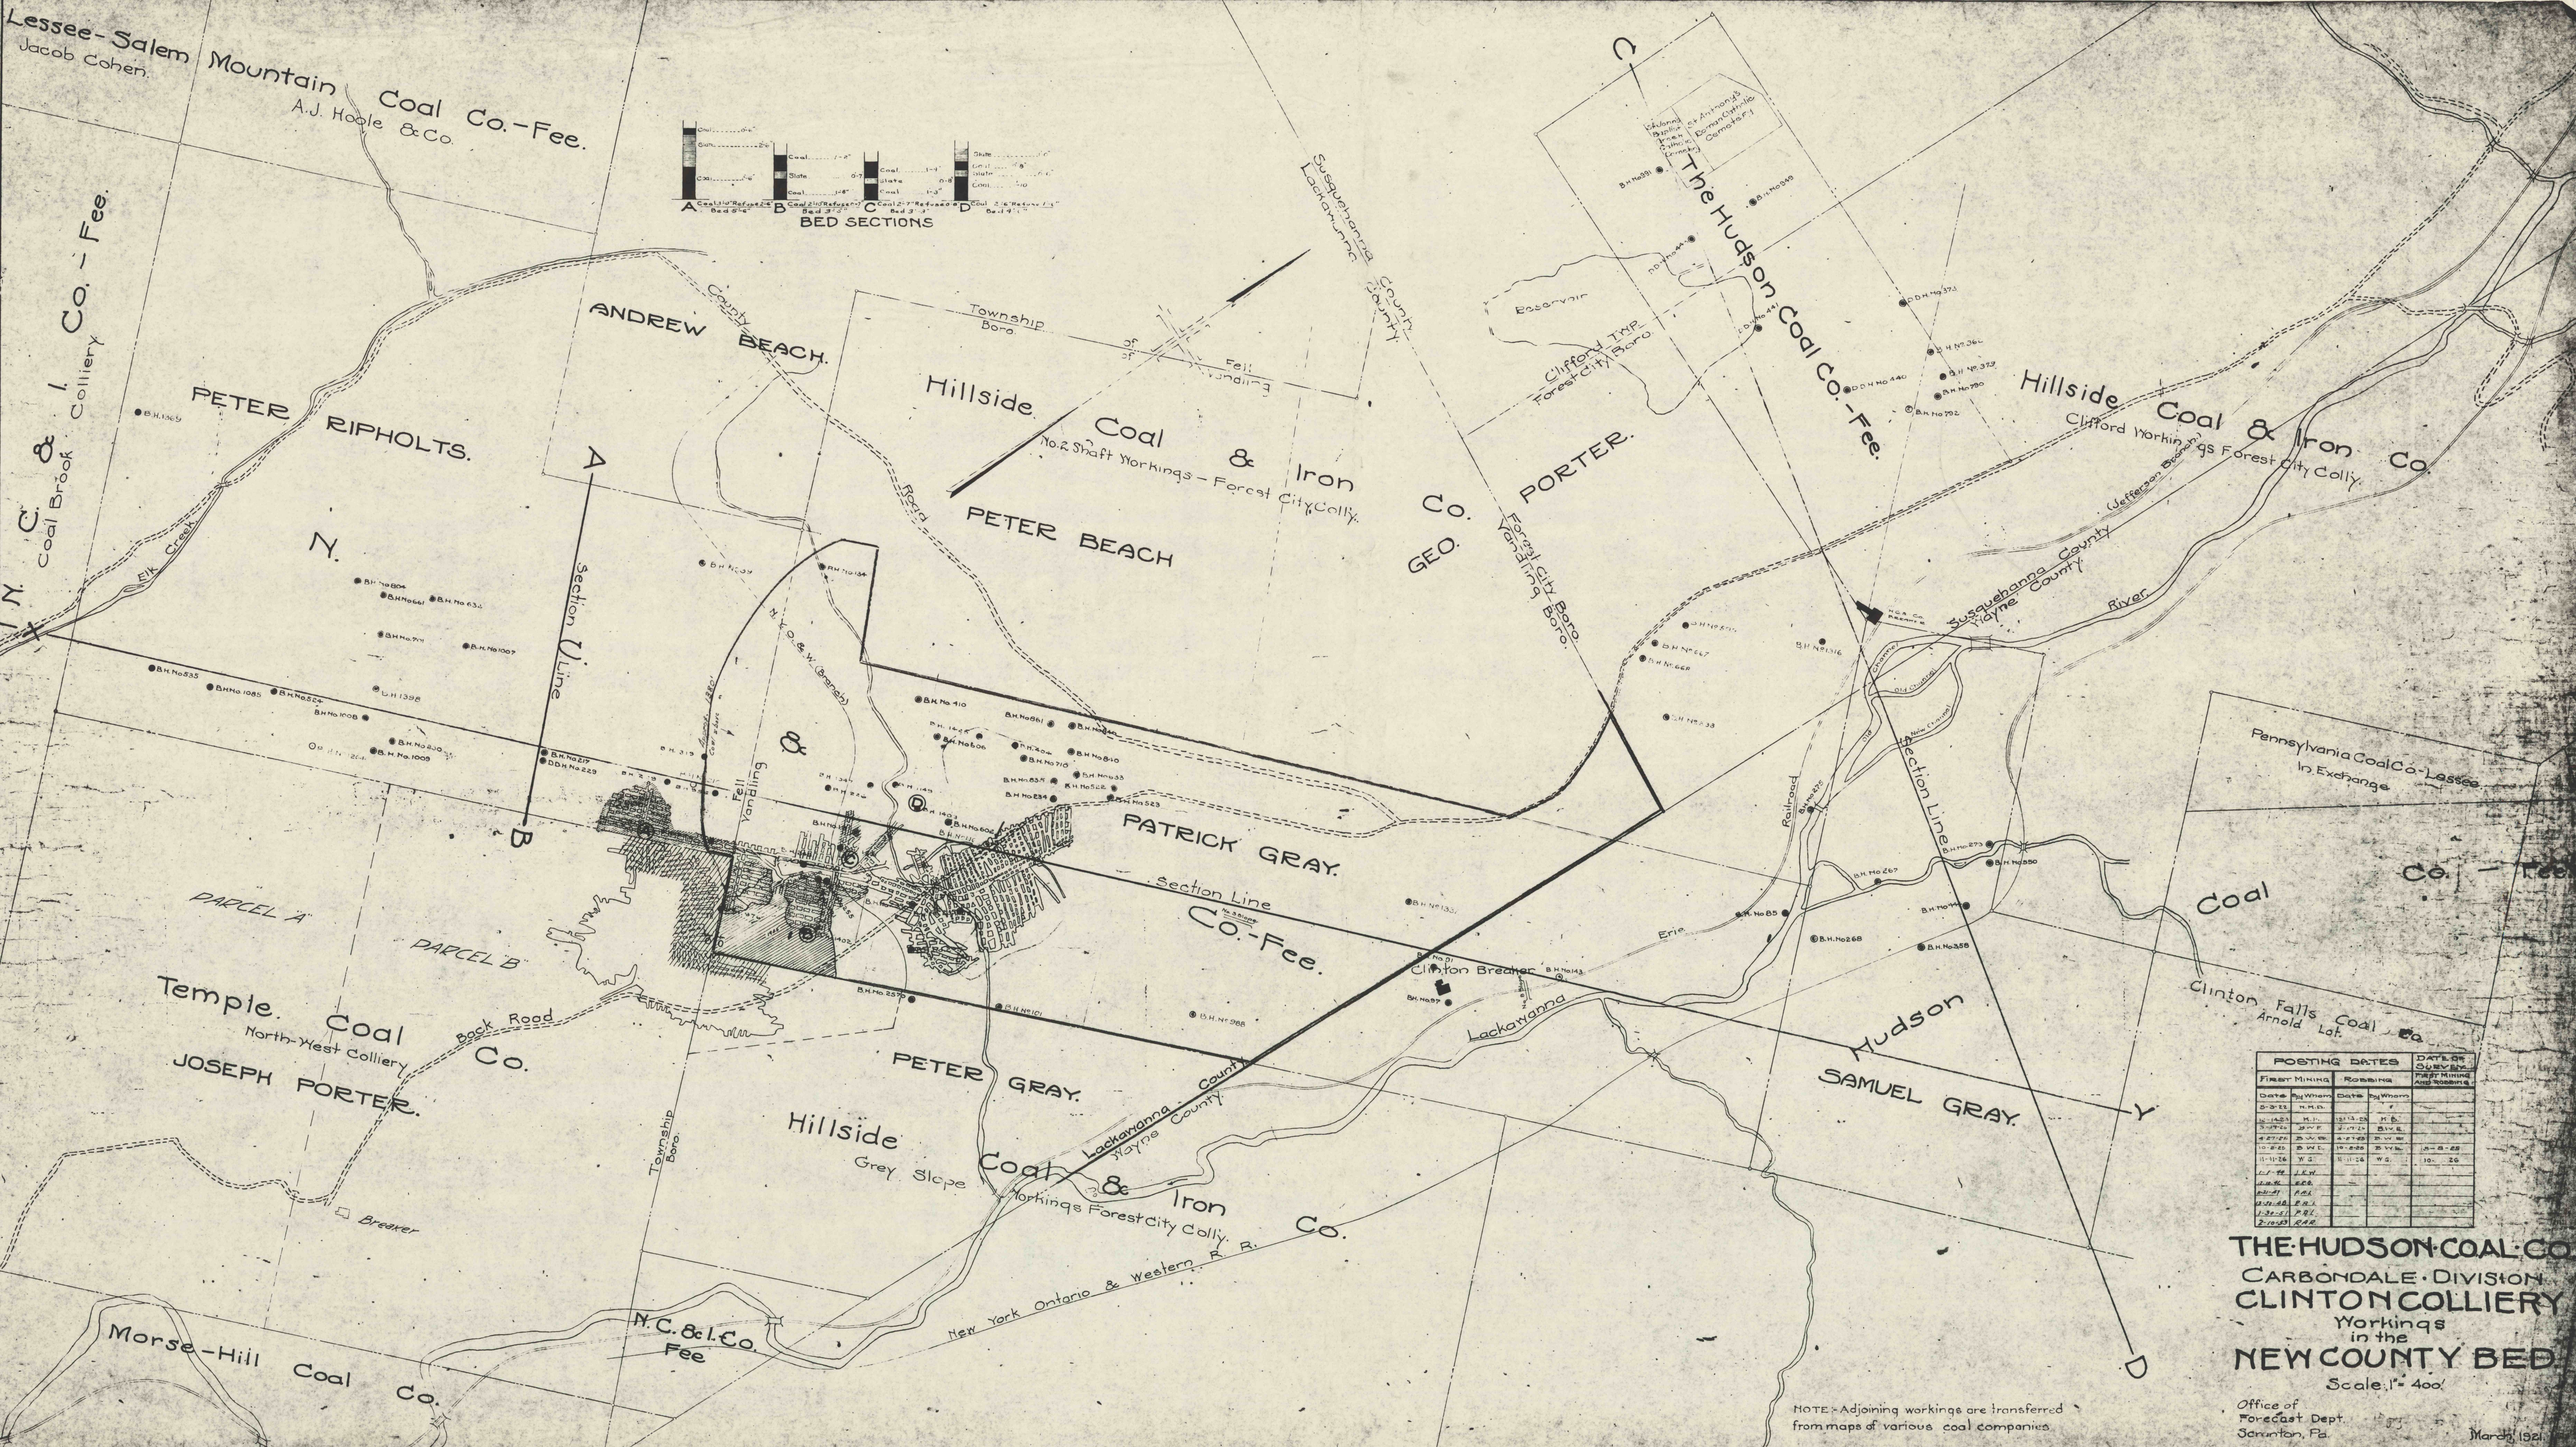

POSTING DATES				DATE OF SURVEY FOR MINE MAPPING AND ROBBING
FIRST MINING		ROBBING		
Date	By Whom	Date	By Whom	
8-3-23	H.R.D.		F	
4-1-25	H.J.	3-13-28	F.B.	
4-27-31	D.W.W.	2-1-32	B.W.E.	
4-27-31	D.W.W.	4-21-33	D.W.W.	
10-8-35	D.W.L.	10-8-35	D.W.L.	3-8-36
11-1-36	W.E.	11-1-36	W.E.	10-25
1-1-37	J.L.H.			
1-18-38	E.E.B.			
10-1-41	A.D.J.			
1-31-46	F.B.J.			
1-31-51	F.B.J.			
2-10-53	R.A.R.			

THE HUDSON COAL CO.
CARBONDALE DIVISION
CLINTON COLLIERY
Workings in the
NEW COUNTY BED
Scale 1" = 400'

Office of Forecast Dept. Scranton, Pa.

March 1921

NOTE:- Adjoining workings are transferred from maps of various coal companies.