



Lessee - Salem Mountain Coal Co. - Fee
Jacob Cohen
A.J. Hoyle & Co.

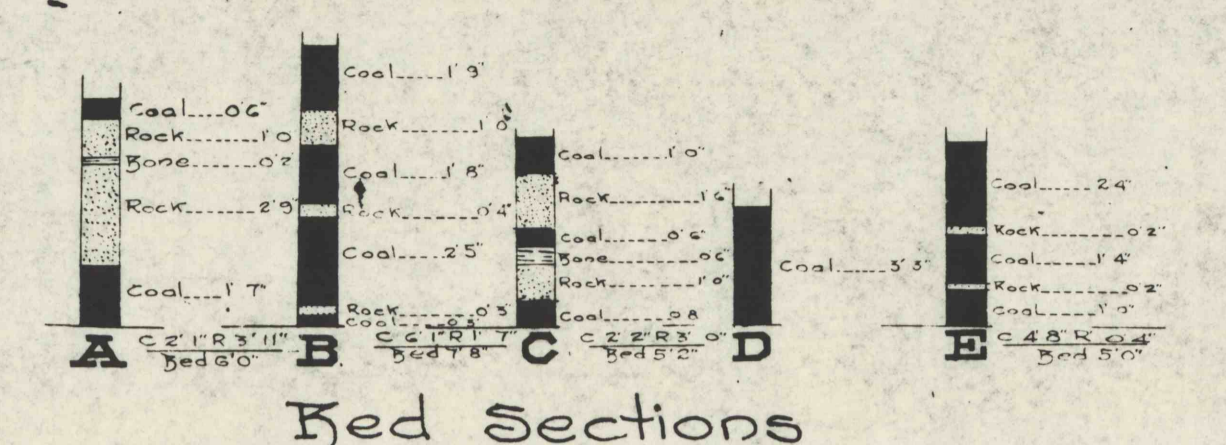

Coal Brook Colliery Co. - Fee

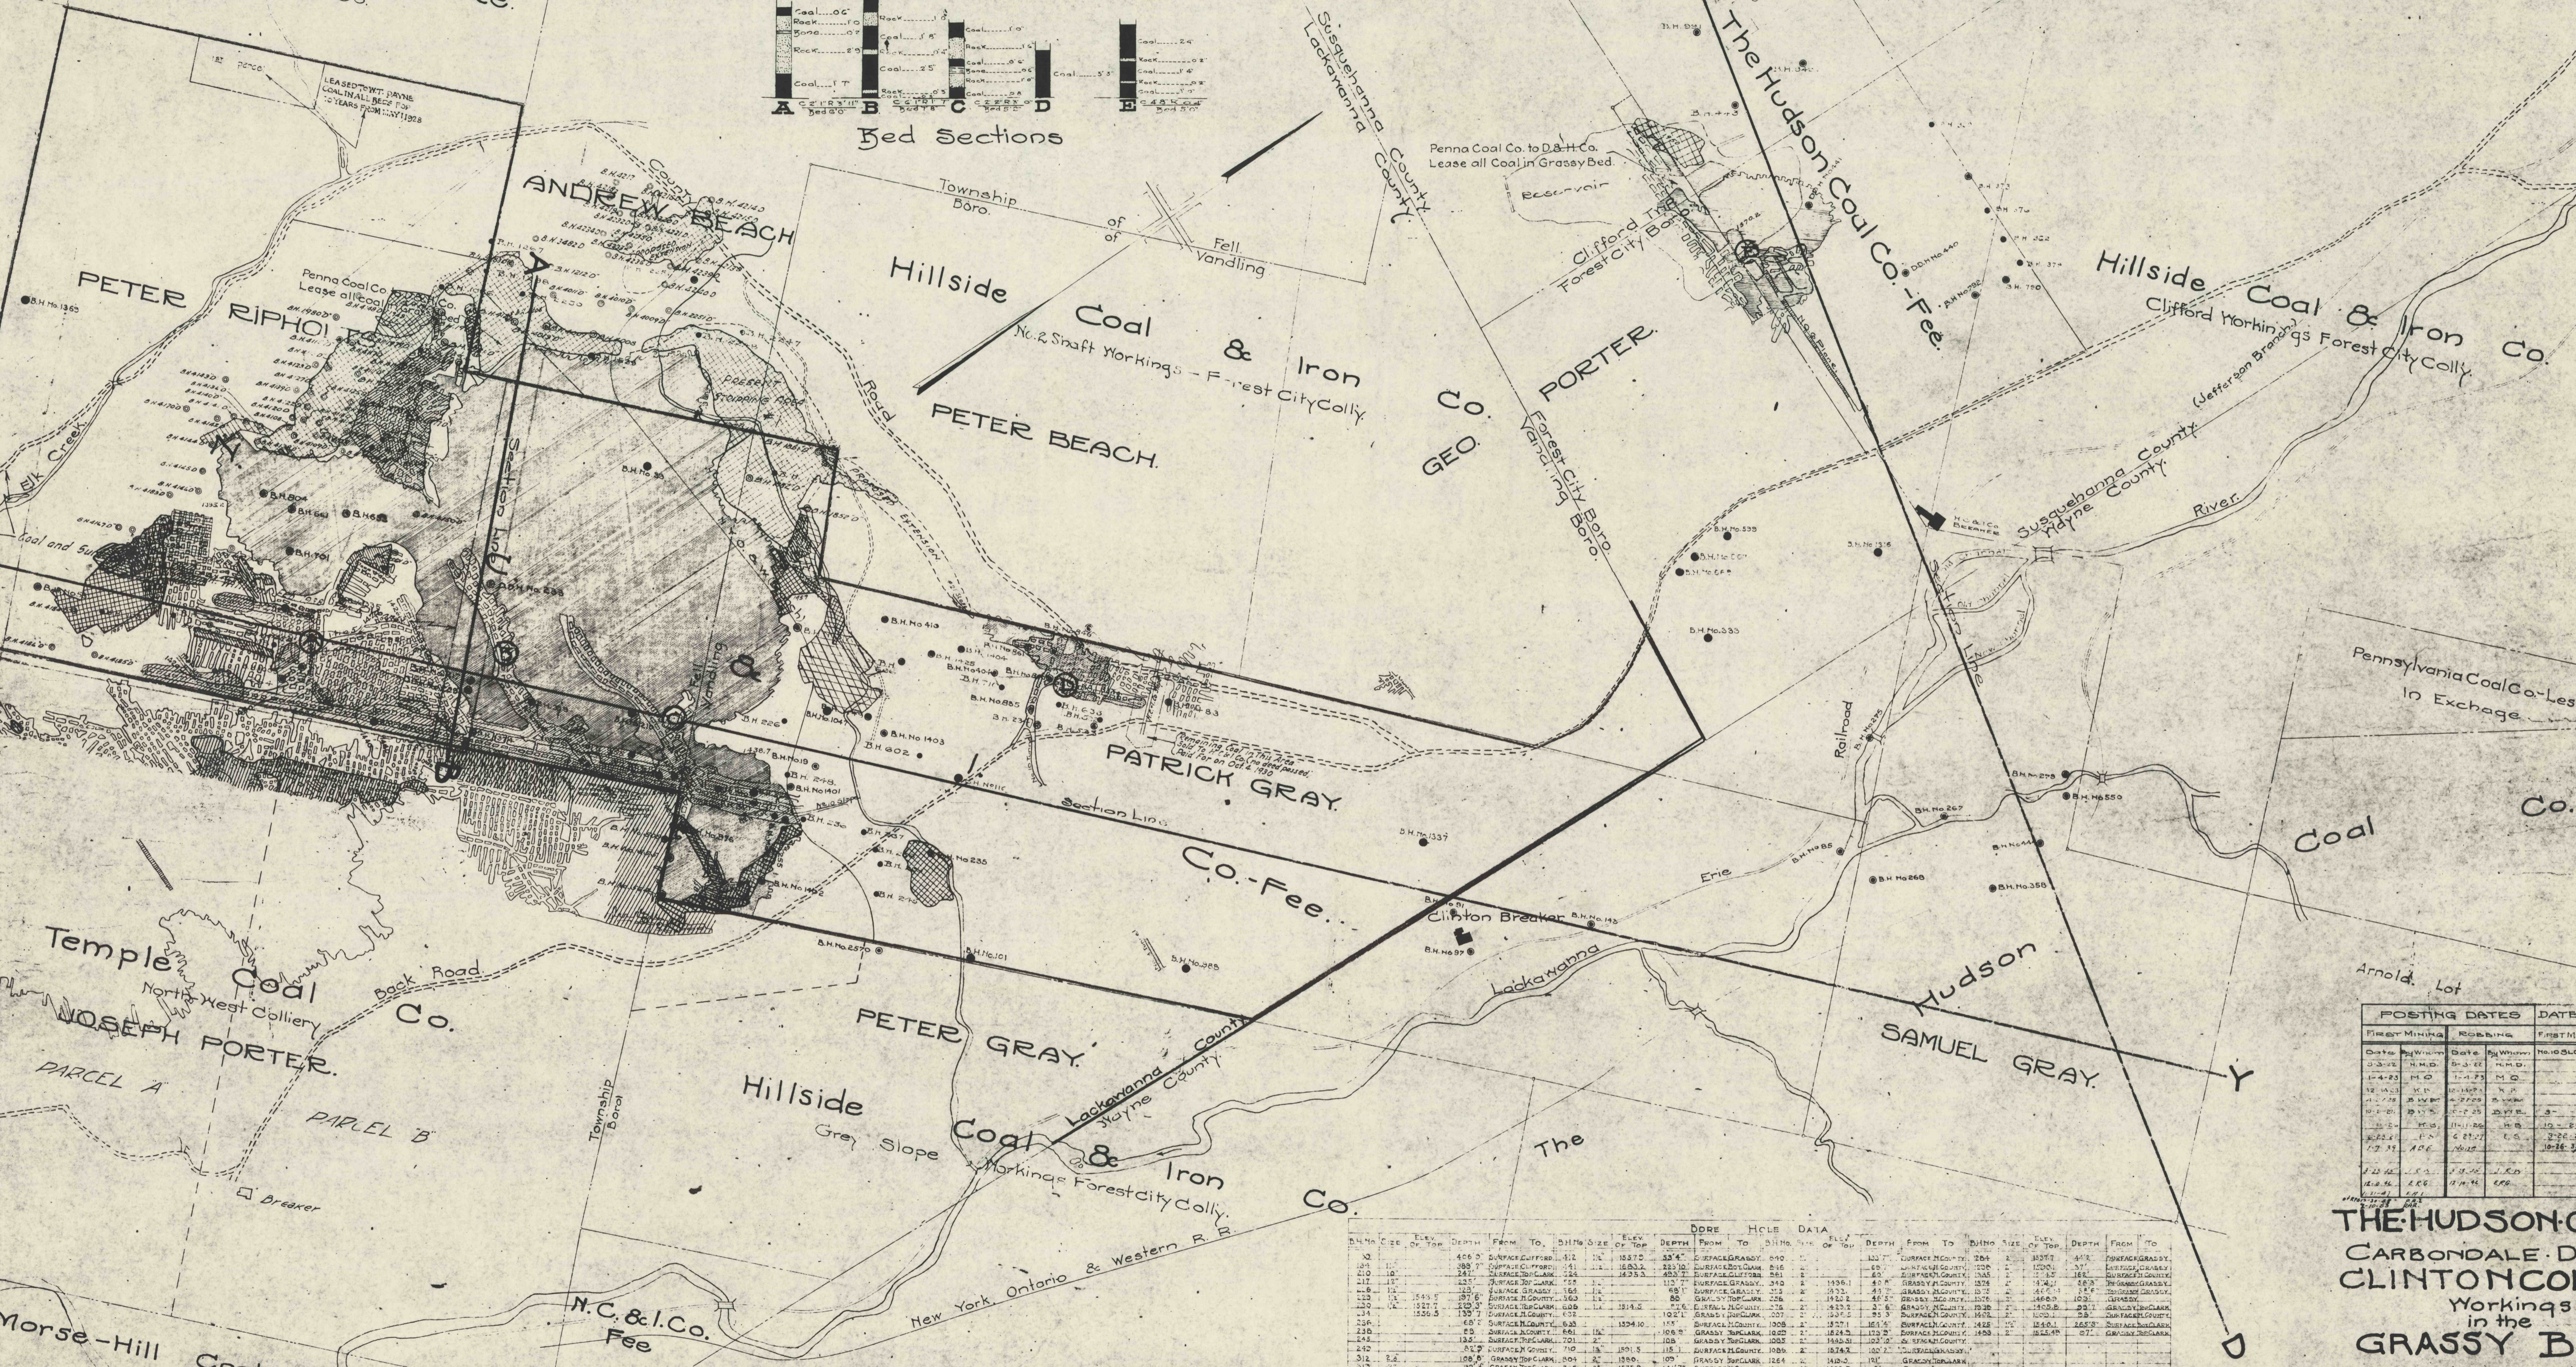

POSTING DATES		ROBBING		DATE OF SURVEY	
Date	By Whom	Date	By Whom	No. of Slope	No. of Infall
3-3-18	H.M.D.	5-3-18	H.M.D.		
1-4-18	H.M.D.	1-1-18	H.M.D.		

B.H. No.		Elev. of Top		From To		Dip		Dip		Dip		Dip		Dip	
THE HUDSON COAL CO.
CARBONDALE DIVISION
CLINTON COLLIERY
Workings in the
GRASSY BED.

Scale: 1" = 400'
Office of Forecast Dept. Scranton, Pa. March 1921

NOTE: Adjoining workings are transferred from maps of various coal companies.