
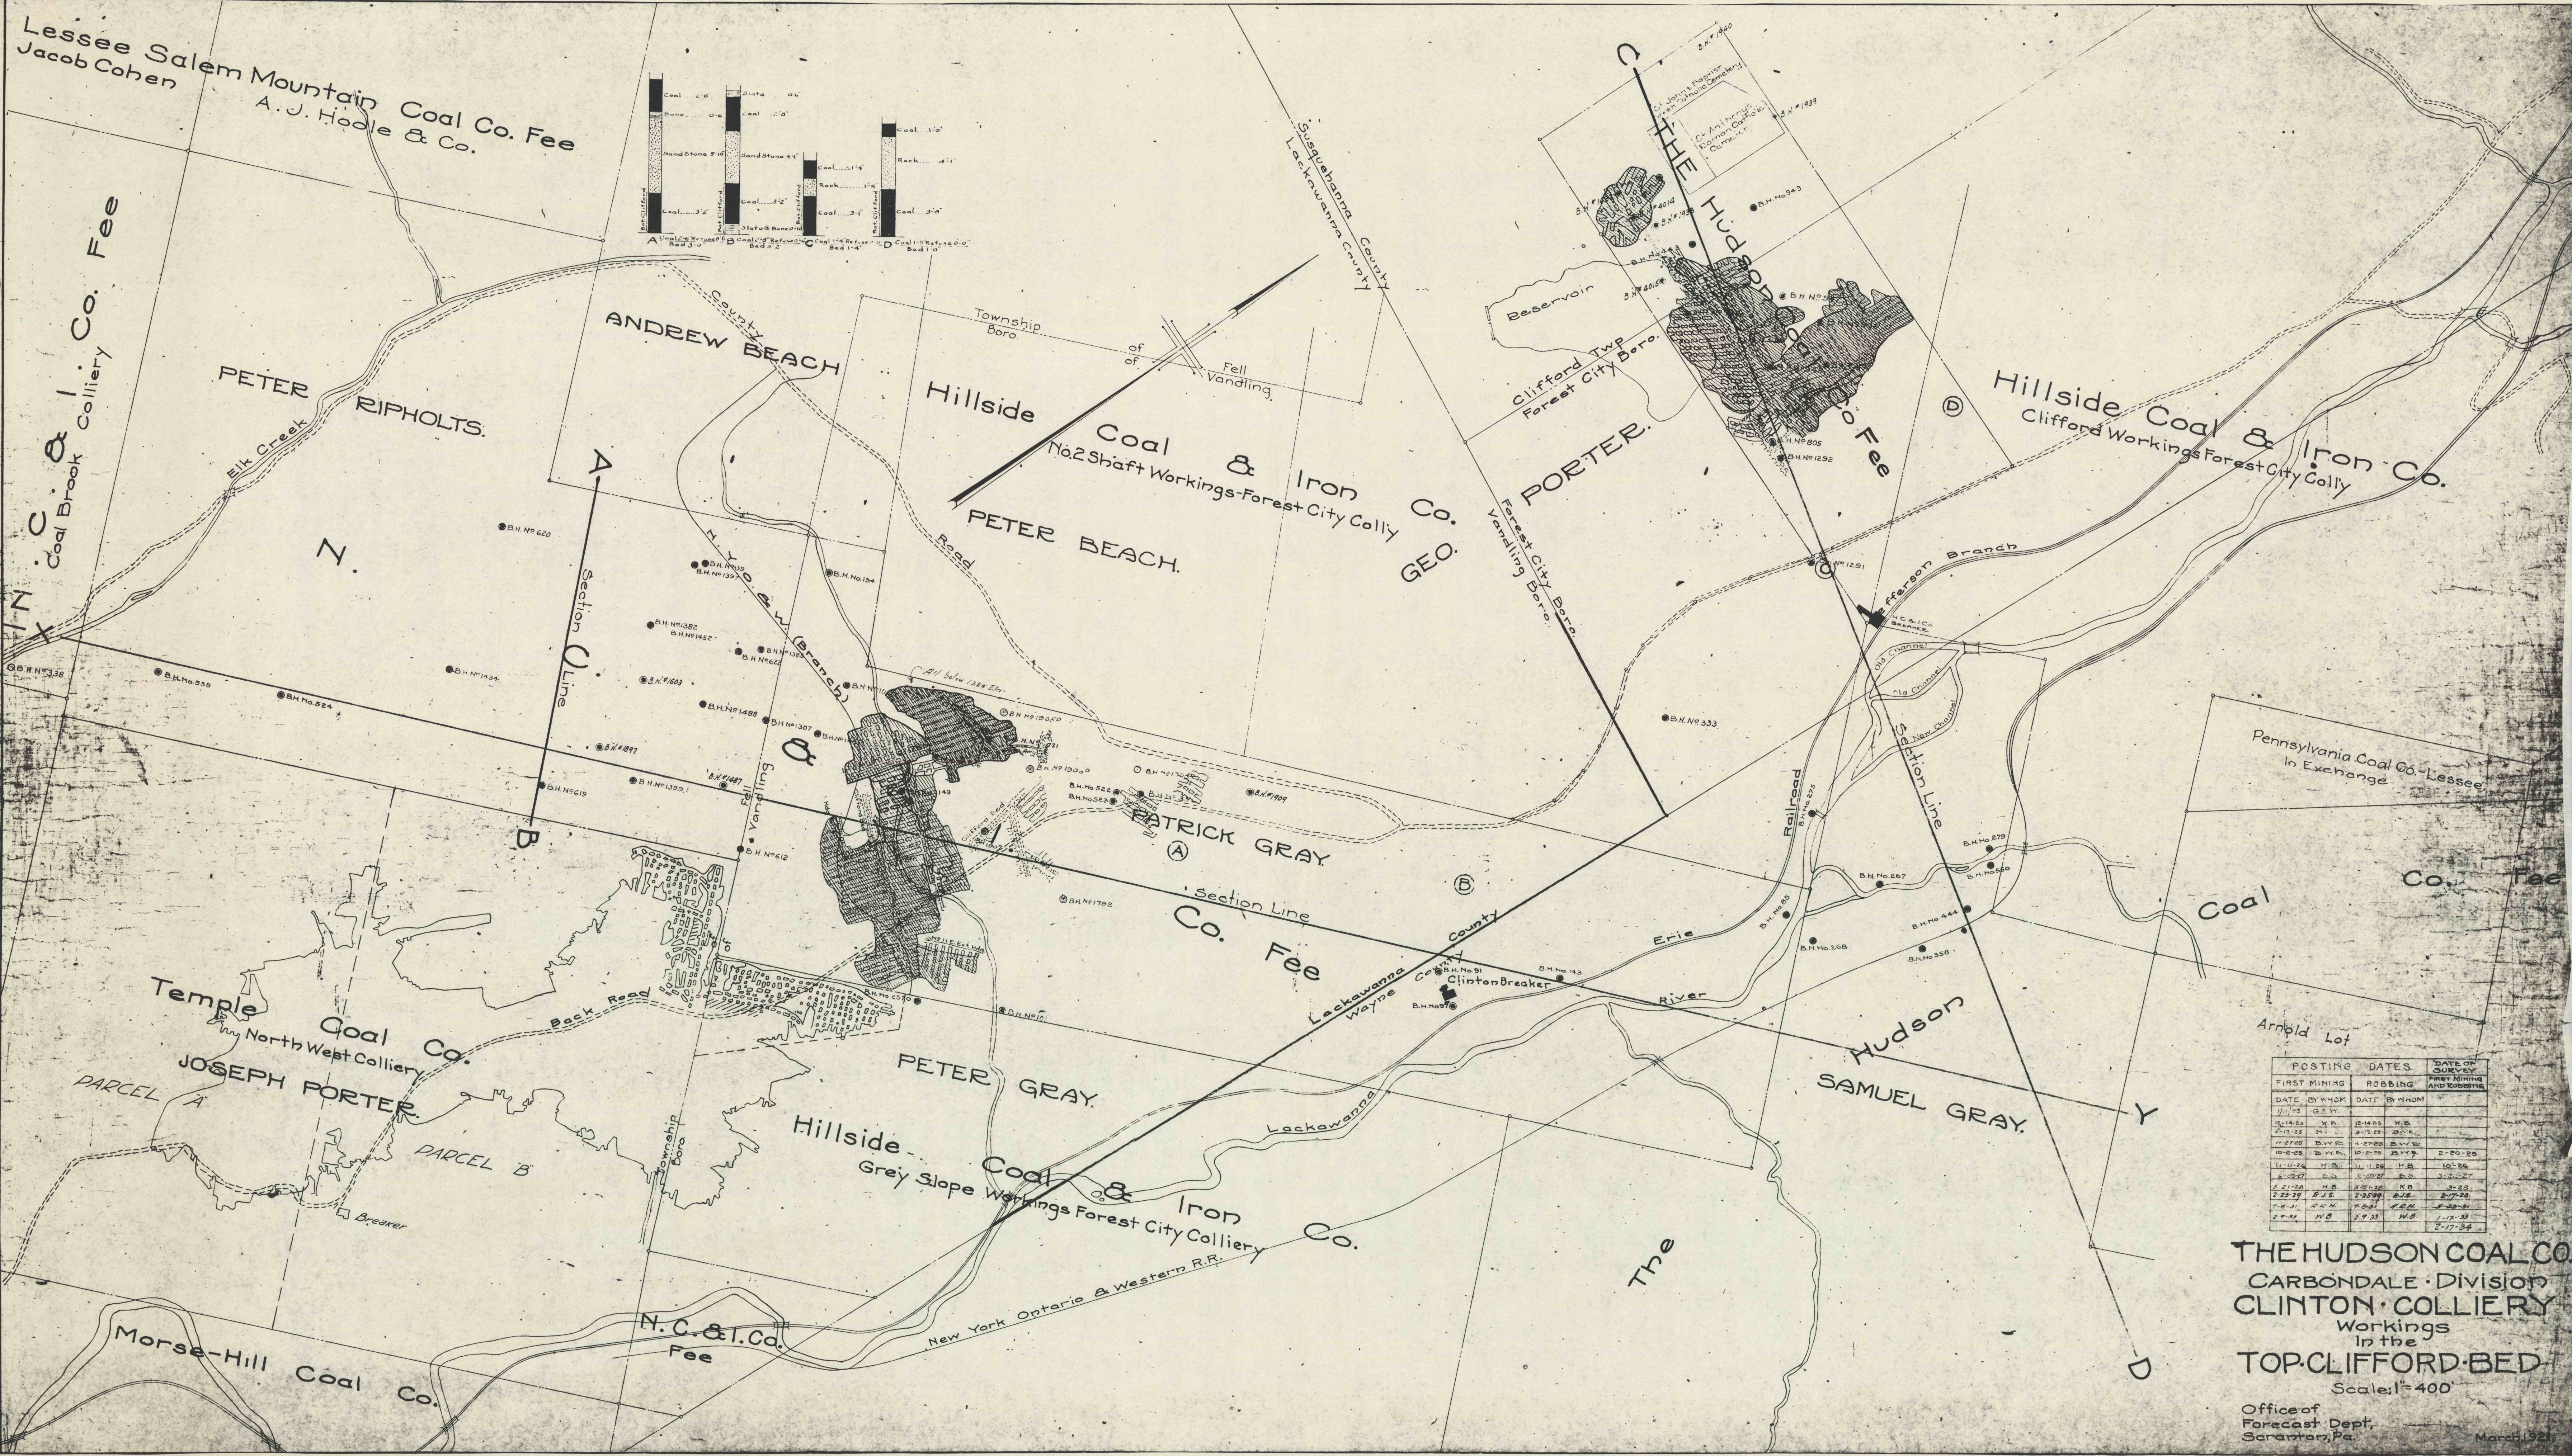


Lessee Salem Mountain Coal Co. Fee  
Jacob Cohen  
A. J. Hoole & Co.

C. & I. Co. Fee  
Coal Brook Colliery Co. Fee

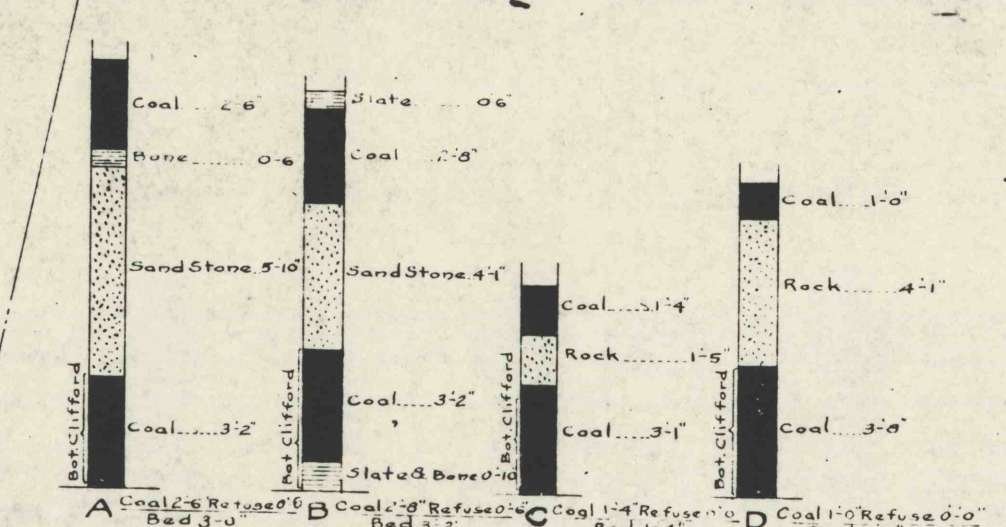

POSTING DATES		DATES OF SURVEY	
DATE	BY WHOM	DATE	BY WHOM
10-12-23	W. B.	10-12-23	W. B.

THE HUDSON COAL CO.  
CARBONDALE DIVISION  
CLINTON COLLIERY  
Workings  
In the  
TOP CLIFFORD BED  
Scale: 1" = 400'

Office of  
Forecast Dept.  
Scranton, Pa.  
March 1924