


- PYNE - NEW COUNTY VN. -
SIBLEY SECTION
SLIDE N°3-2

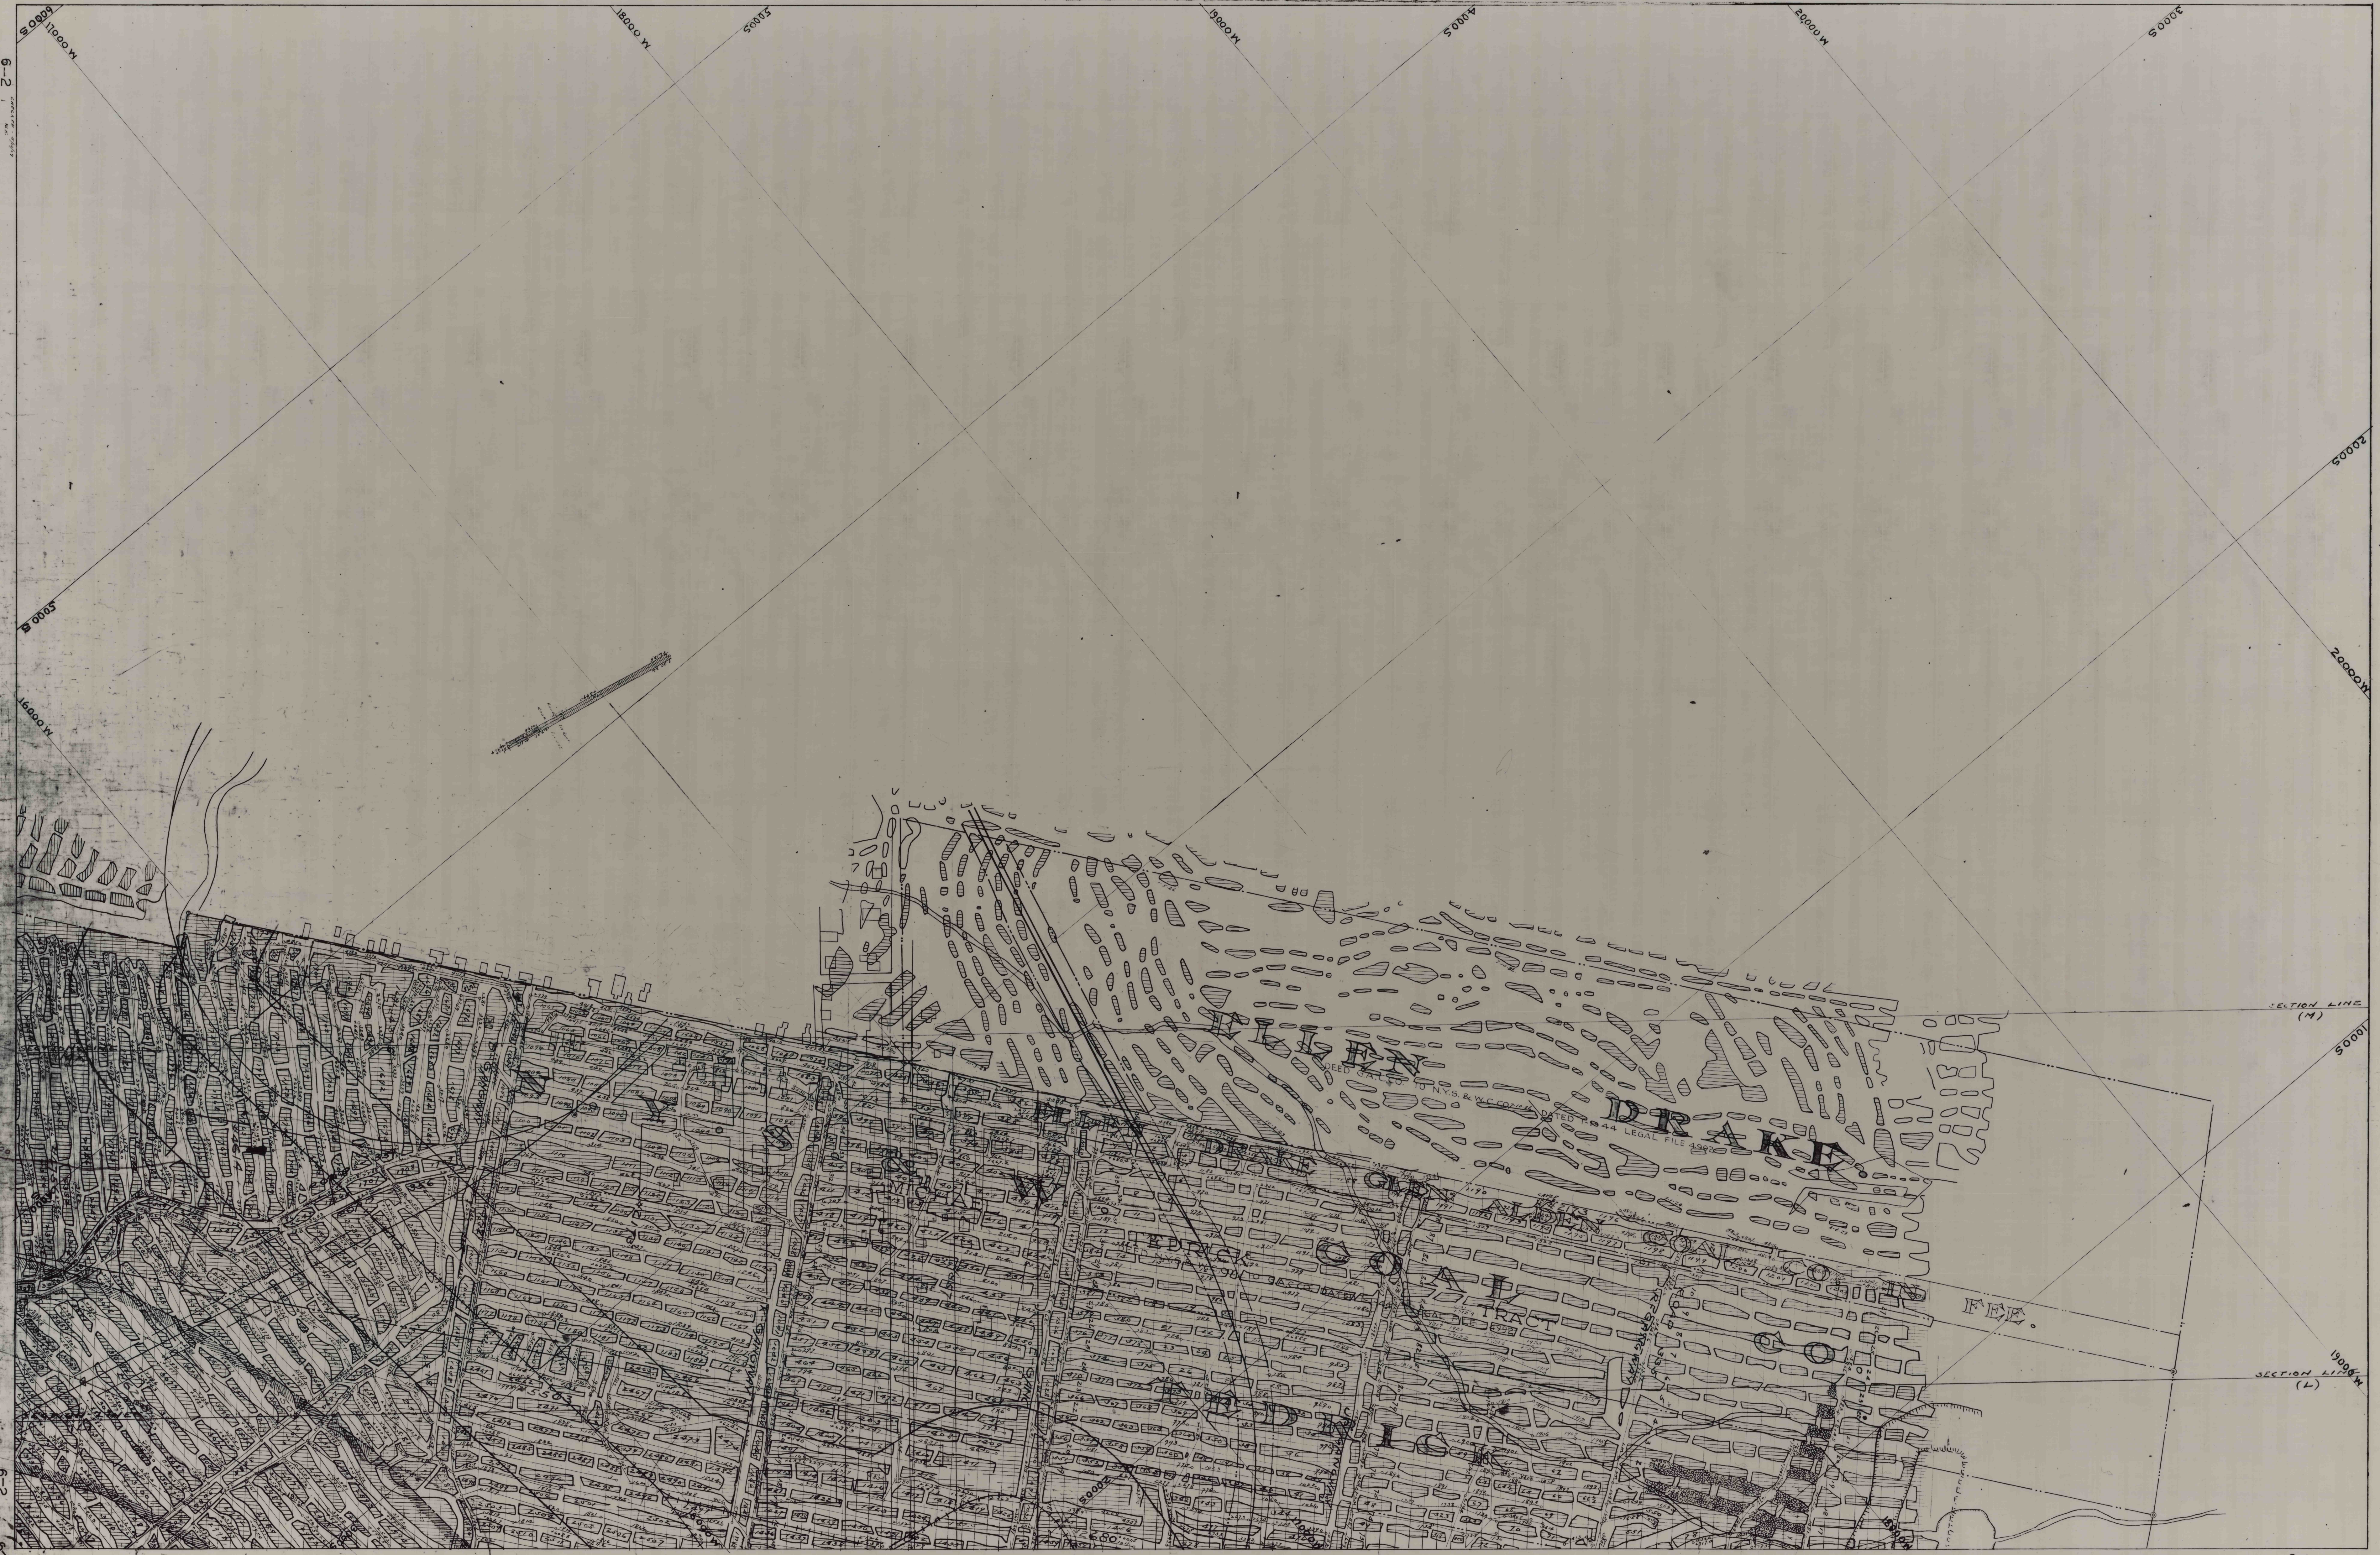

- PYNE - NEW COUNTY VN. -
SIBLEY SECTION
SLIDE N°3-2

For the List of Maps Number See Fine-Sight Section
Average