


SIBLEY SECTION
No. 1 DUNMORE VEIN
SLIDE - No. 3-2

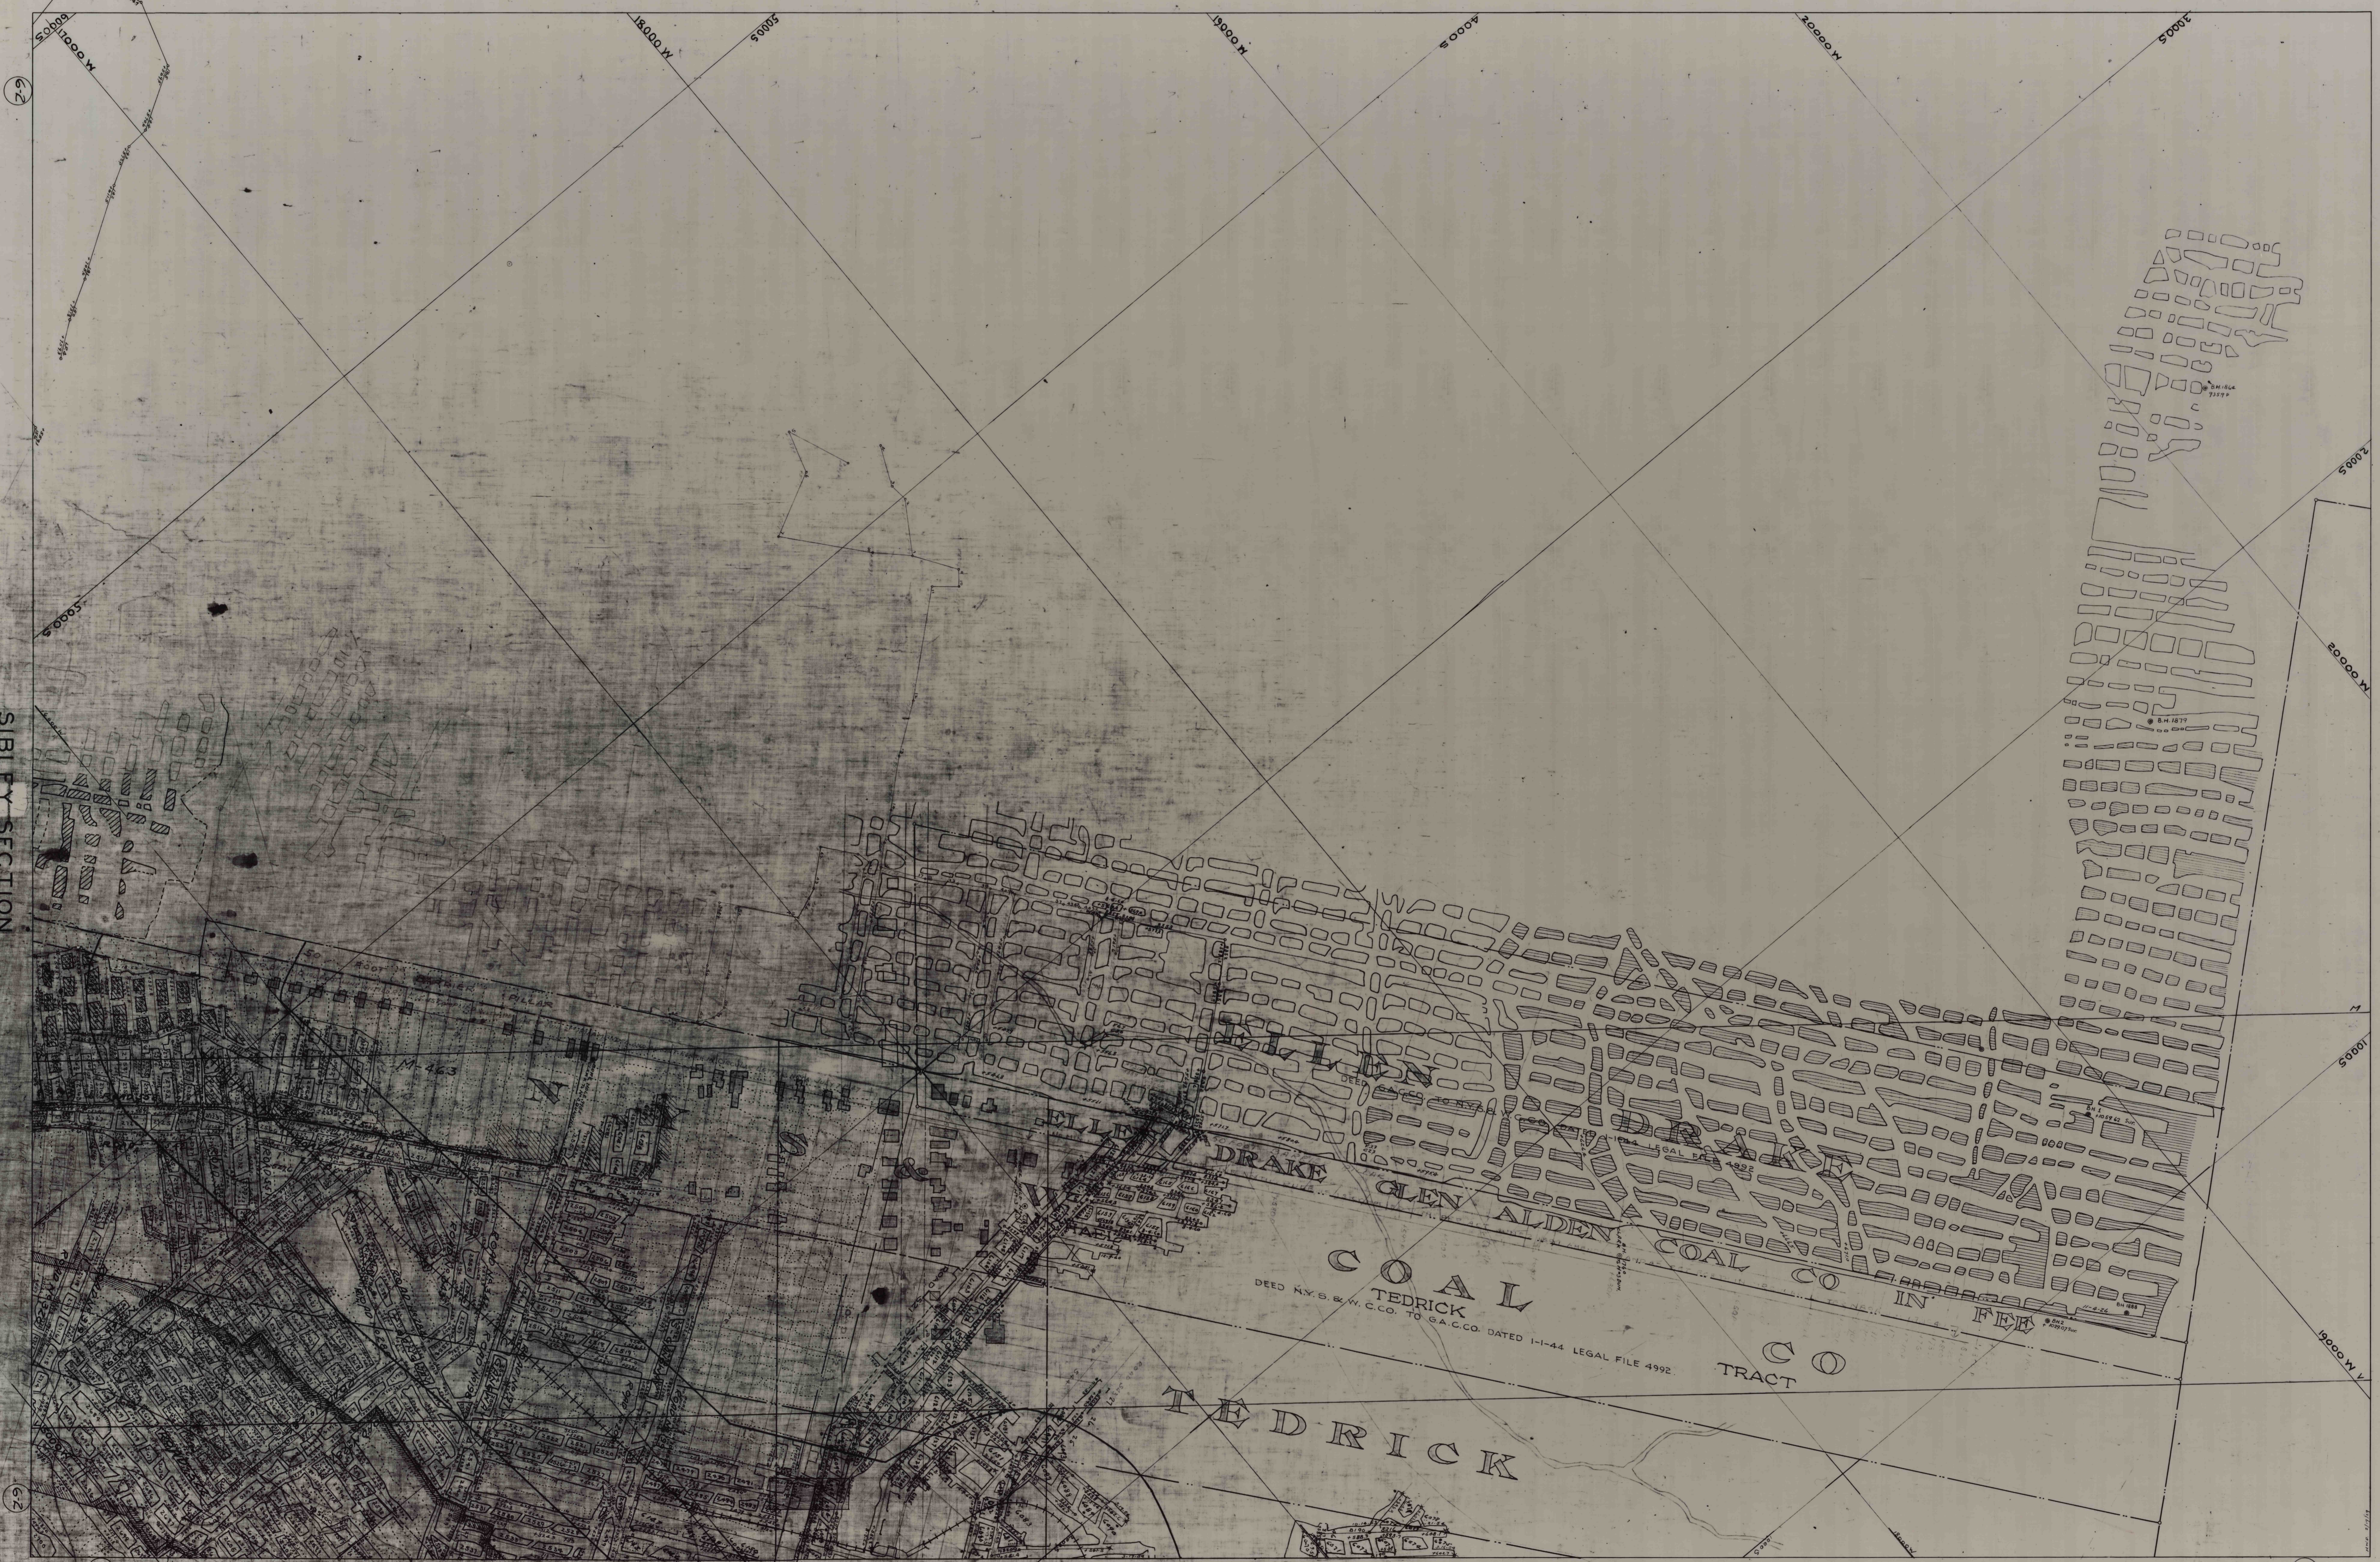

SIBLEY SECTION
No. 1 DUNMORE VEIN
SLIDE - No. 3-2