


SIBLEY SECTION
No 2 DUNMORE VN
SLIDE 3-2

SIBLEY SECTION
No 2 DUNMORE VN
SLIDE 3-2

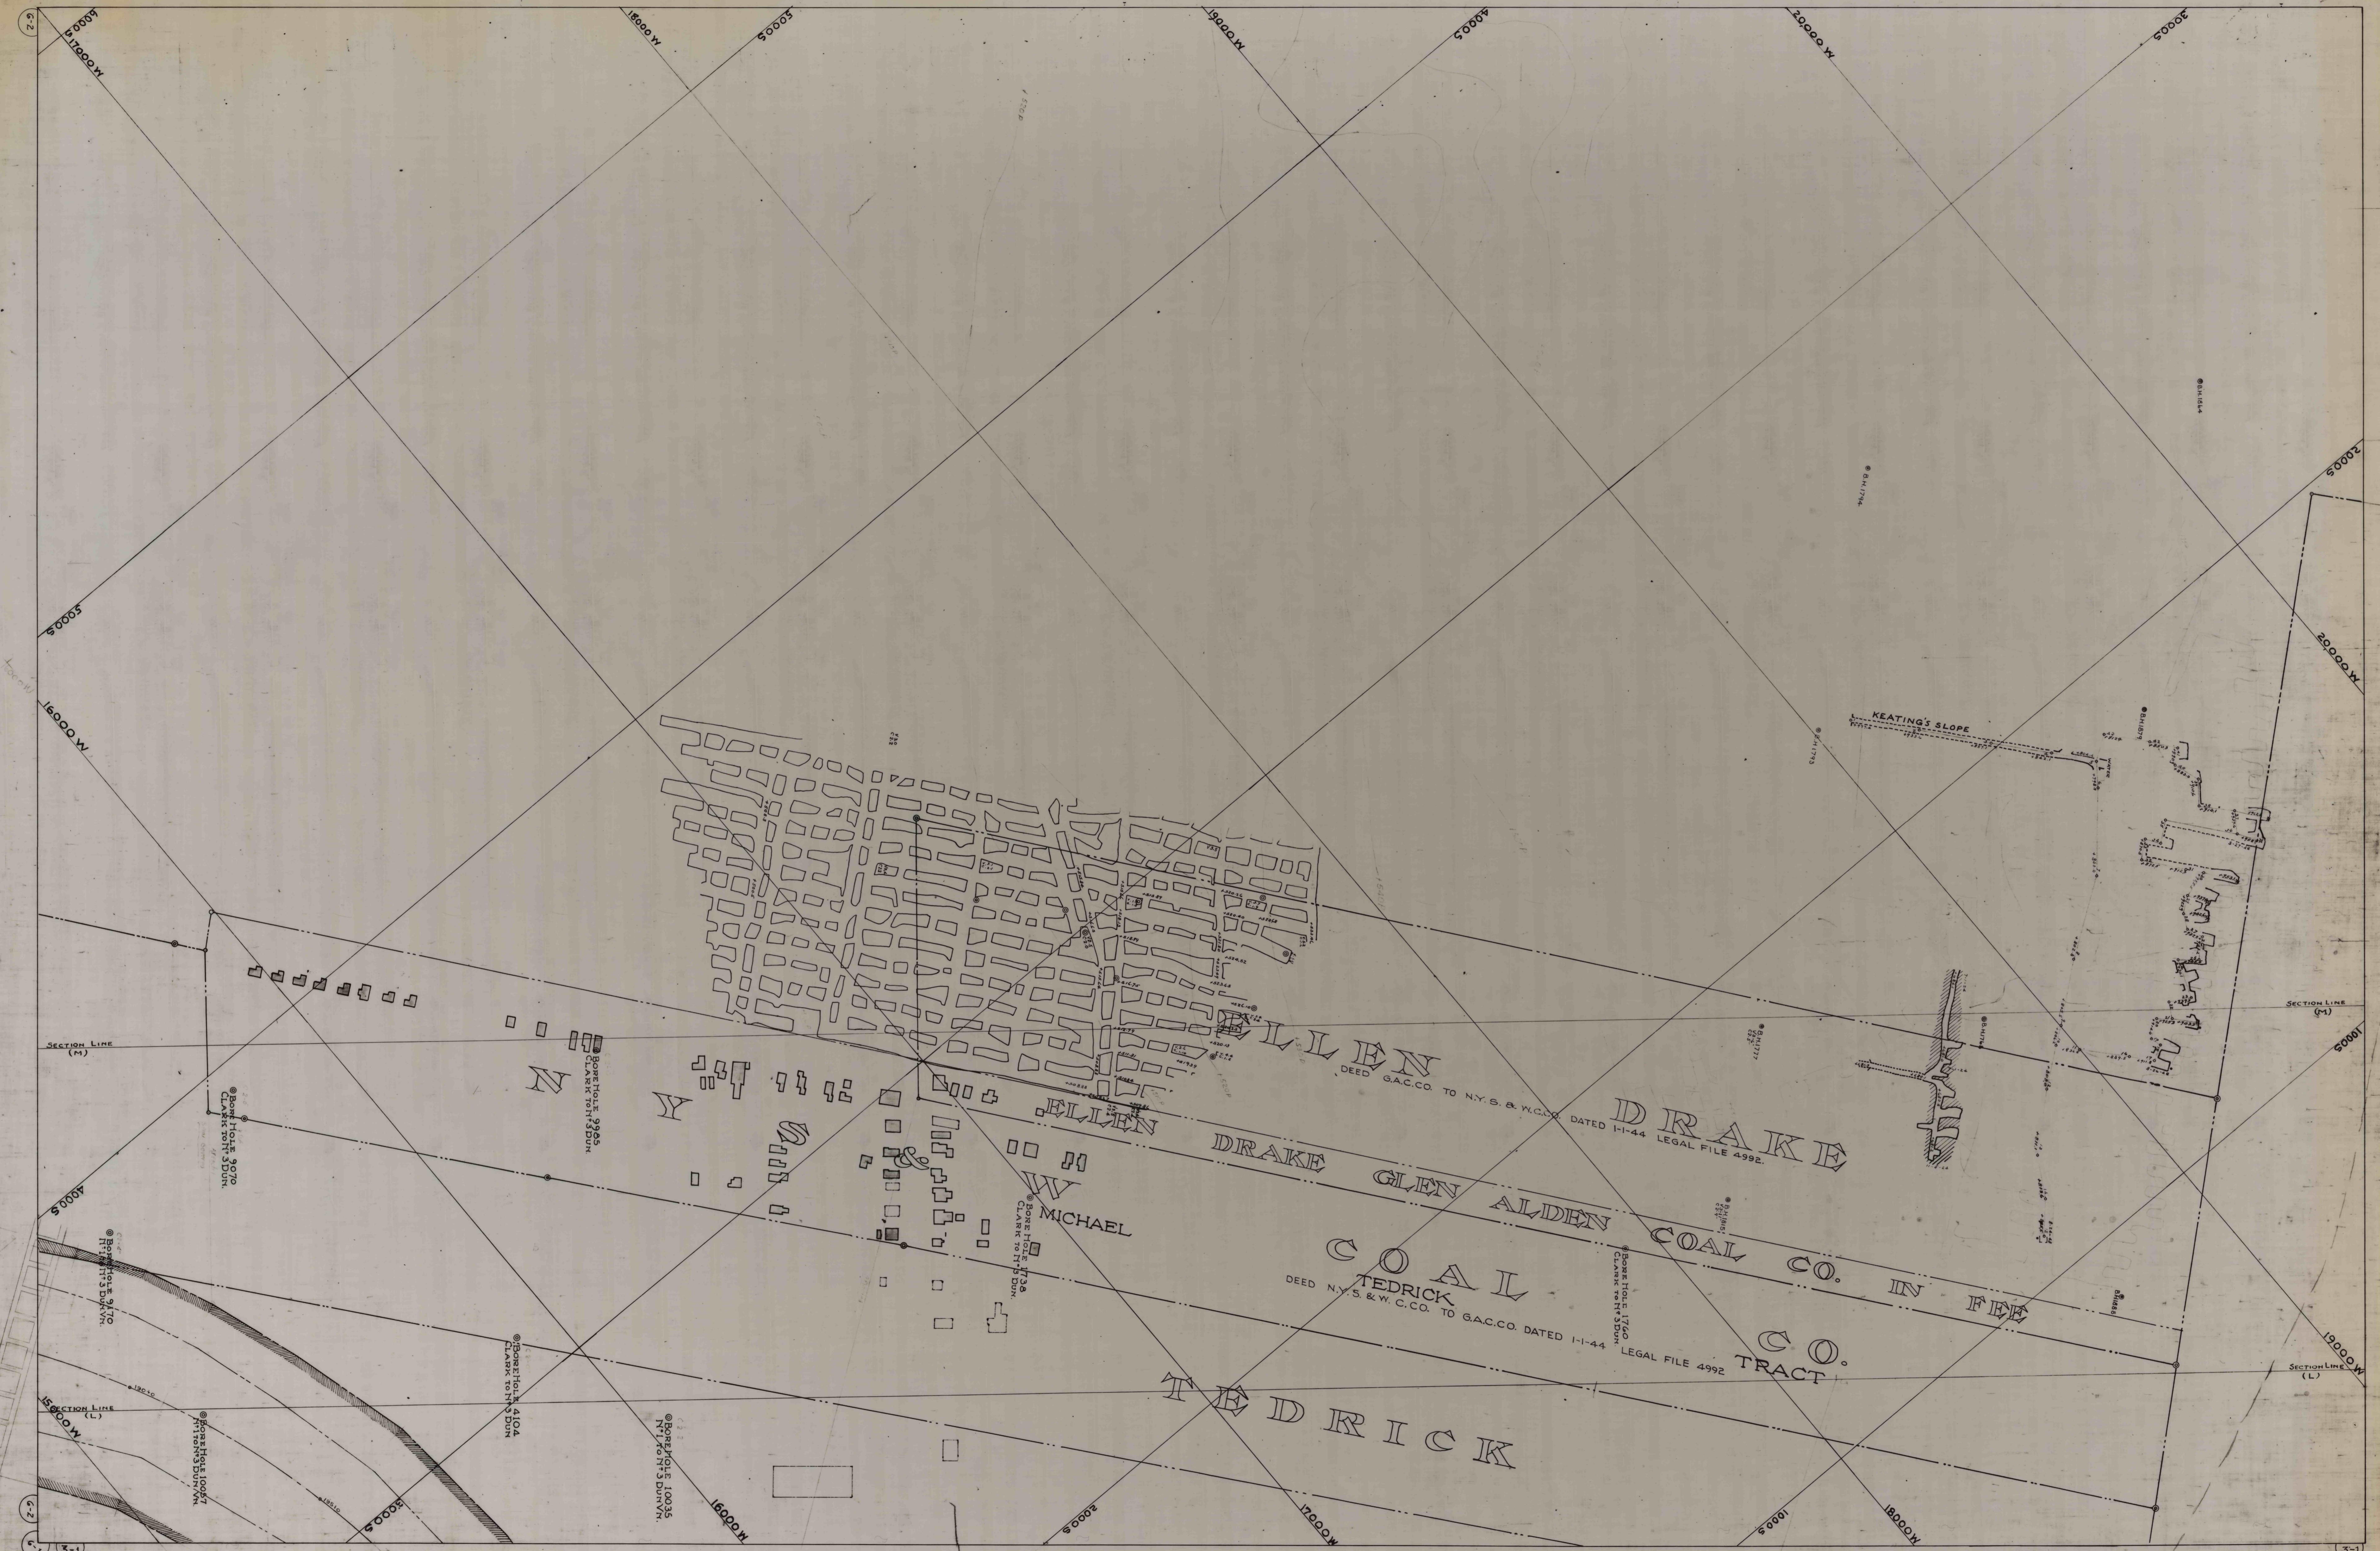



