


SIBLEY SECTION
No 3 DUNMORE VN
SLIDE 3-2

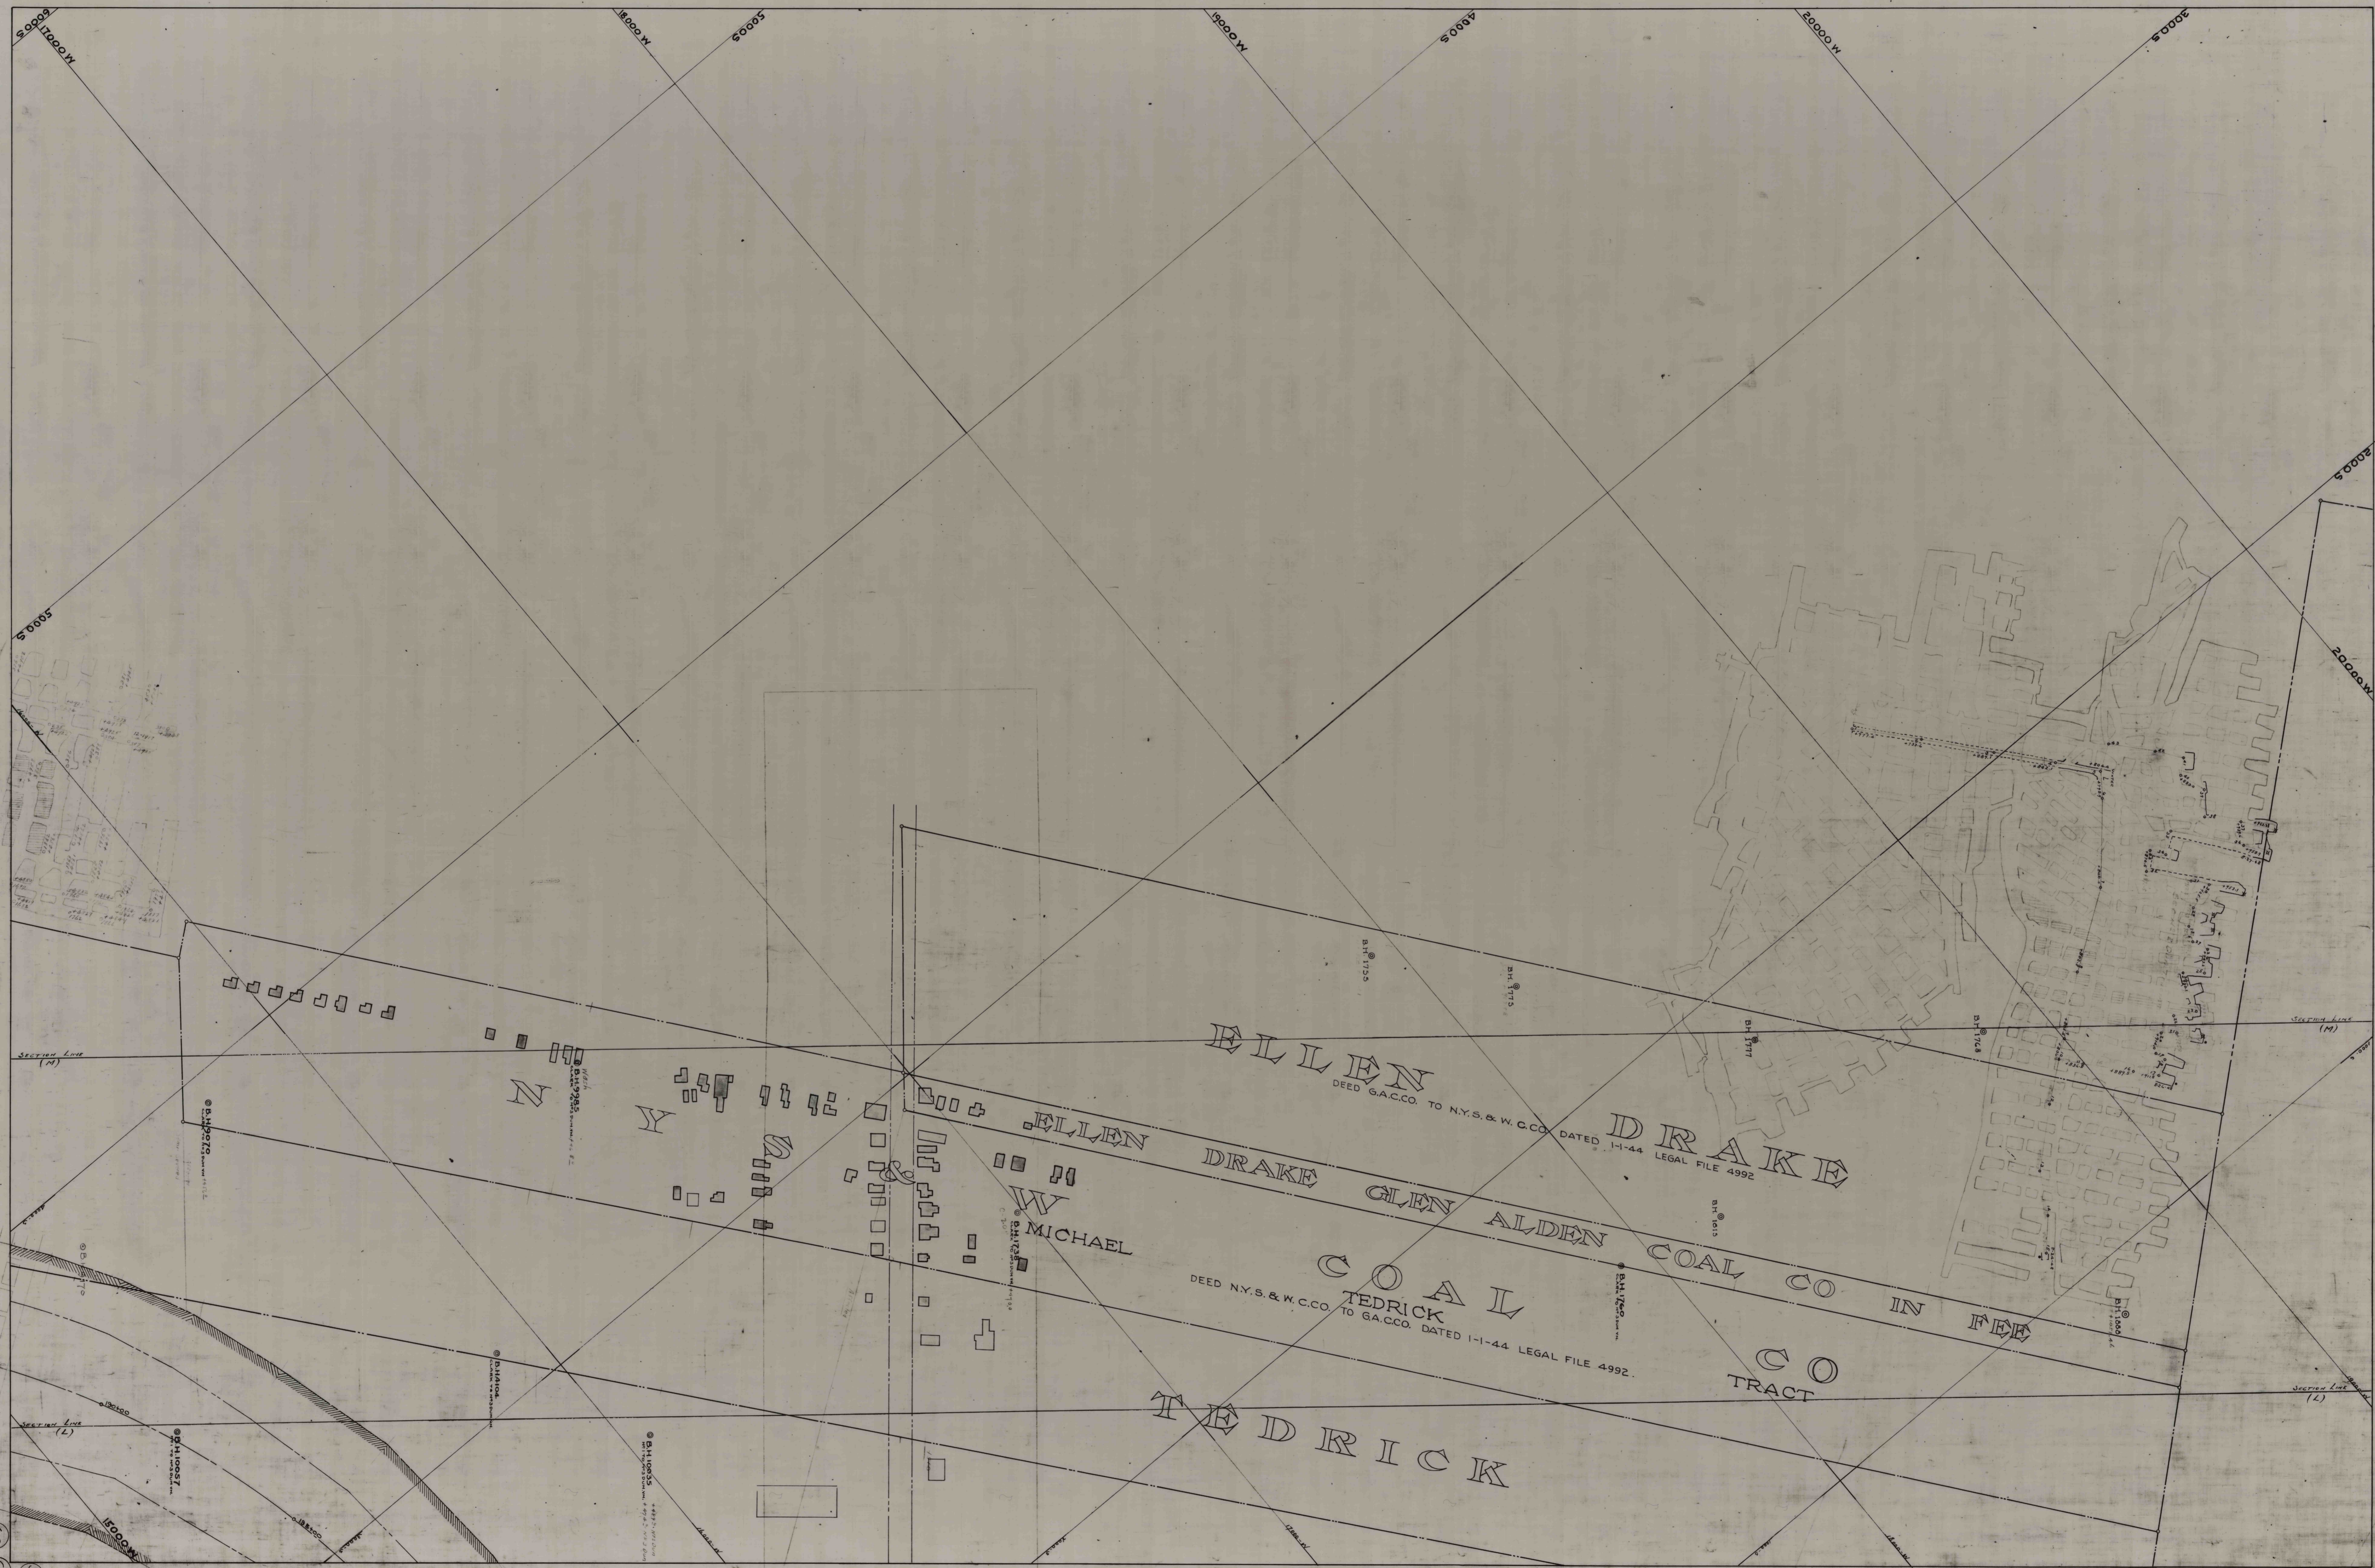

SIBLEY SECTION
No 3 DUNMORE VN
SLIDE 3-2

62
61
51

51