


PYNE SHAFT SECTION
PYNE N°1 DUNMORE VEIN
SLIDE 3-1

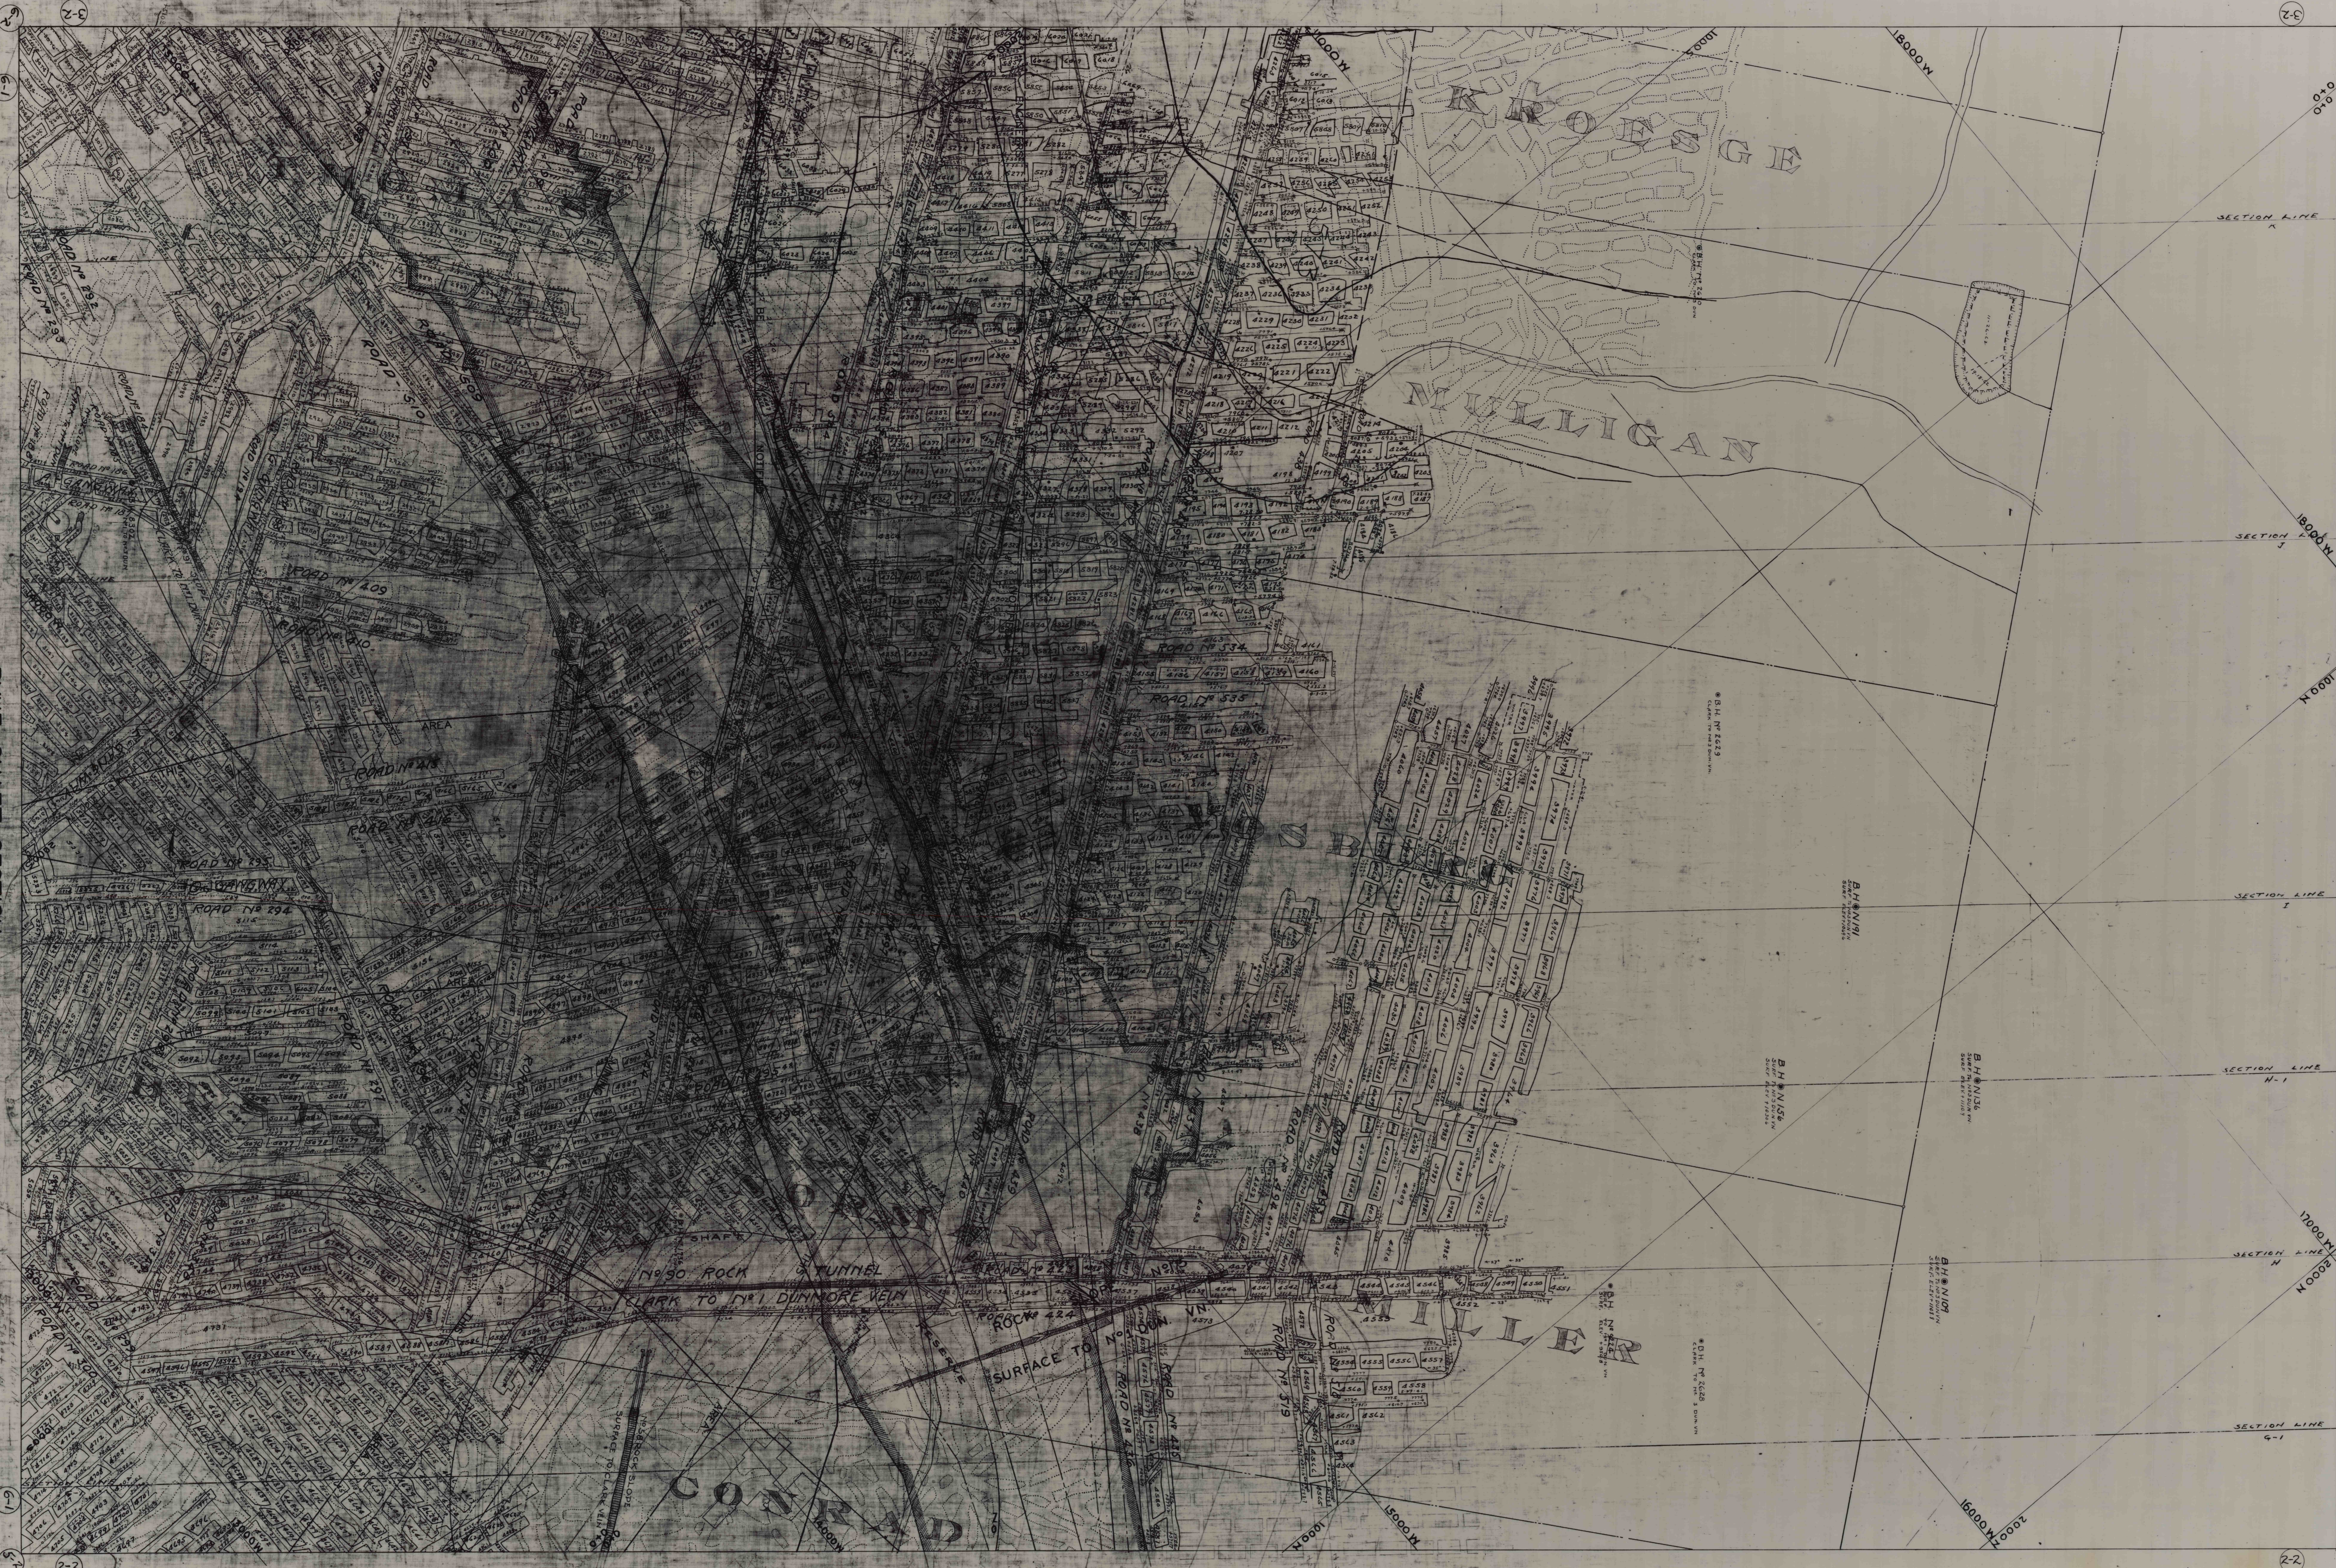

PYNE SHAFT SECTION
PYNE N°1 DUNMORE VEIN
SLIDE 3-1

2-2
6-1
KROENGE
MULLIGAN
DUNMORE
CONRAD
17000 N
SECTION LINE H-1
17000 N
SECTION LINE N
17000 N
SECTION LINE G-1
16000 N
20000 N
2-2
6-1