

P S T E P H E N S



D A N I E L S M I L L E R

G E O R G E F E L L I S

V O N S T O R C H

H E N R Y G R I F F I N

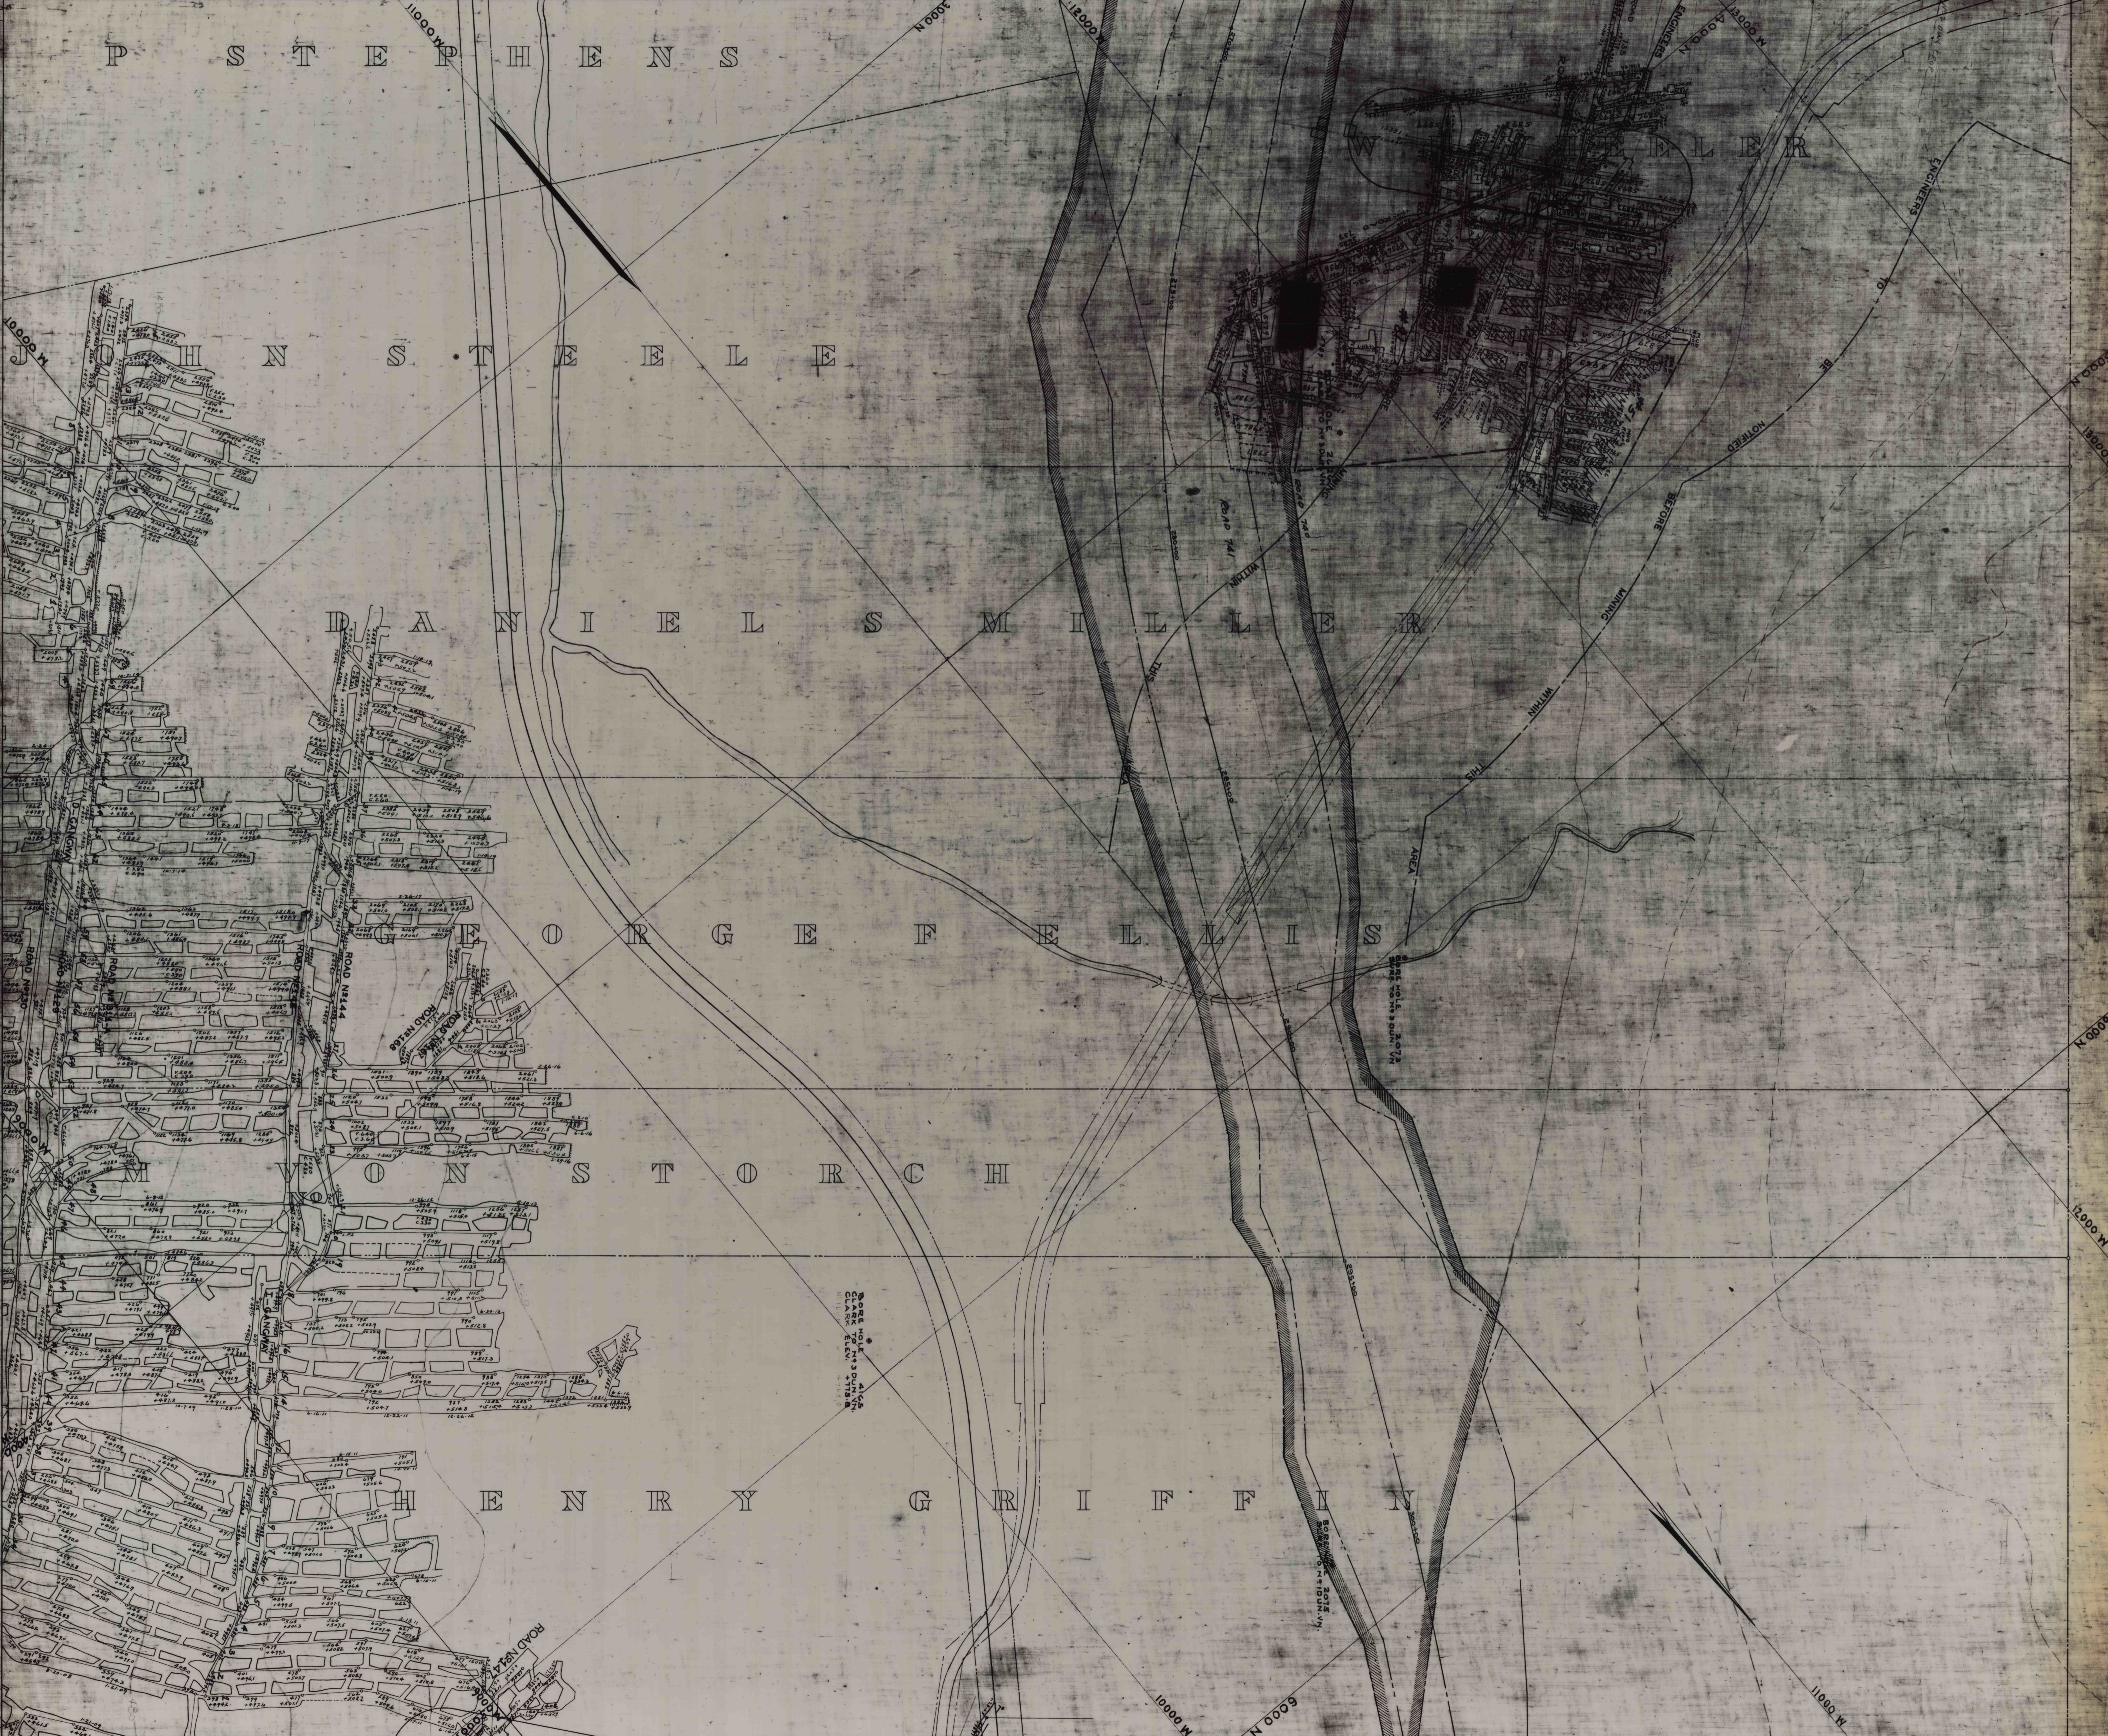


