


CONTINENTAL MOUNTAIN SECTION

SLIDE
TOP No 1
DUNMORE VEIN

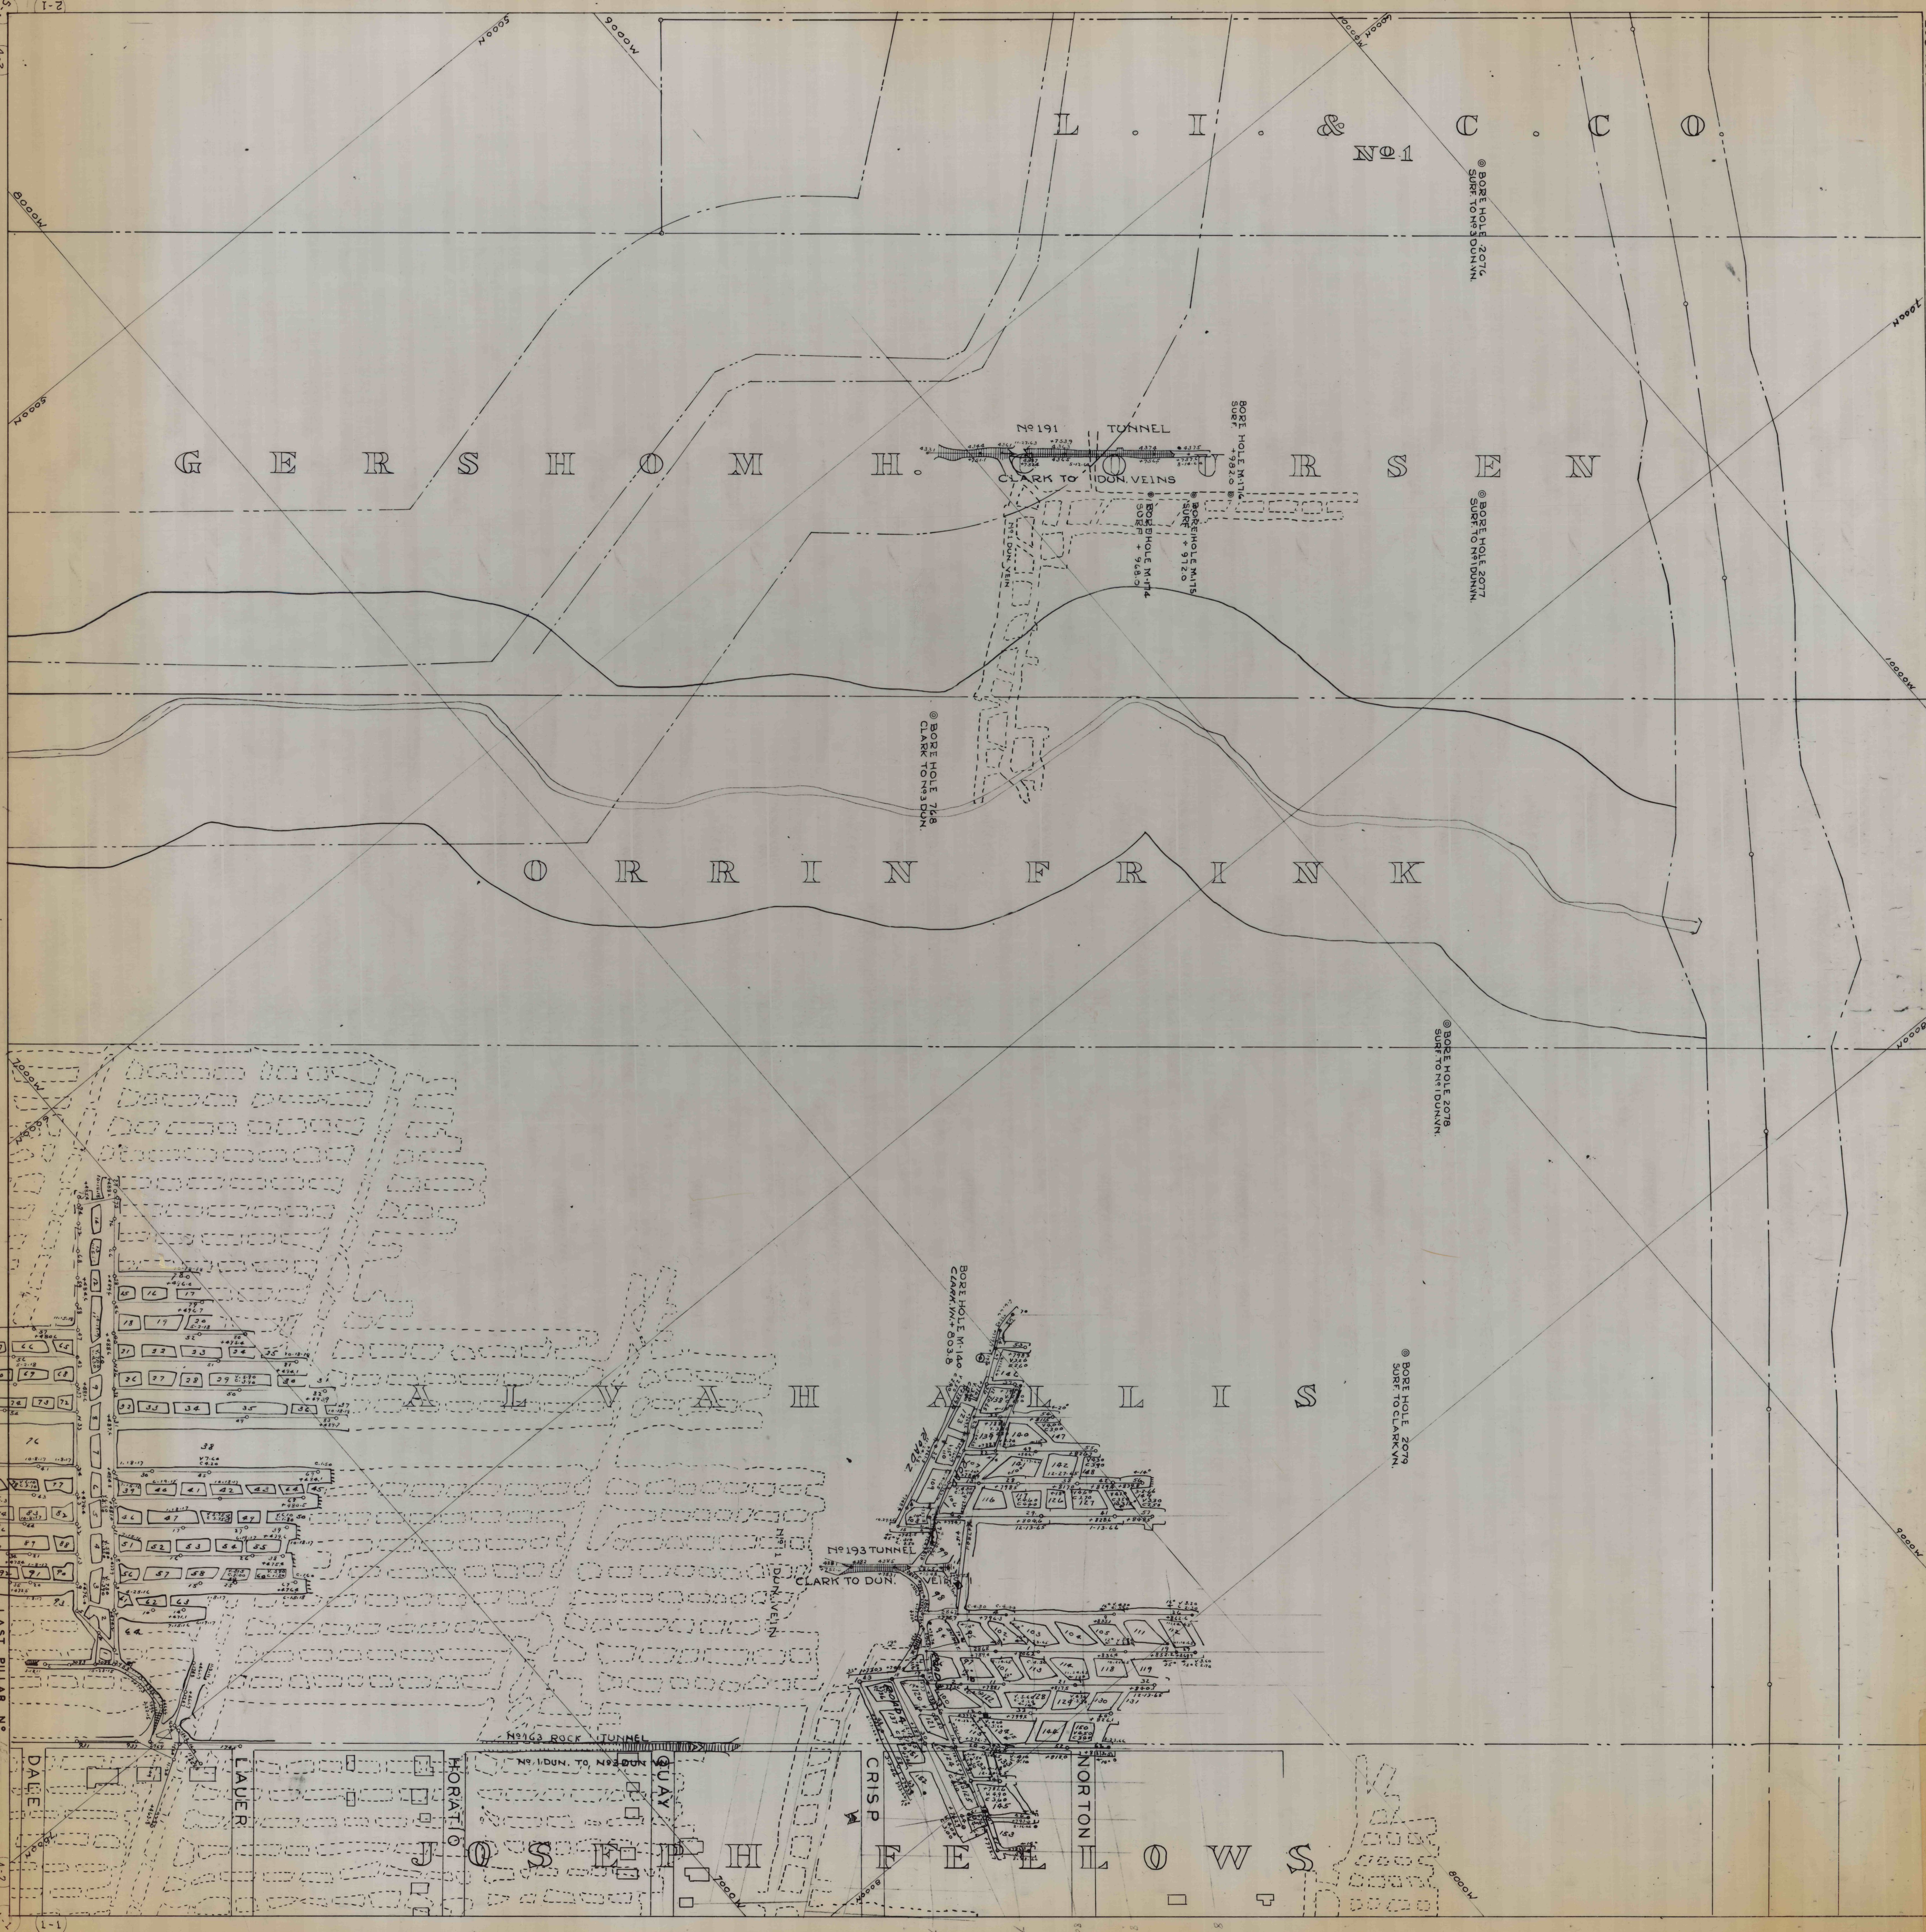

1-2, 4-2, 1-1, 4-2, 1-1