


A L V A H A L L I S

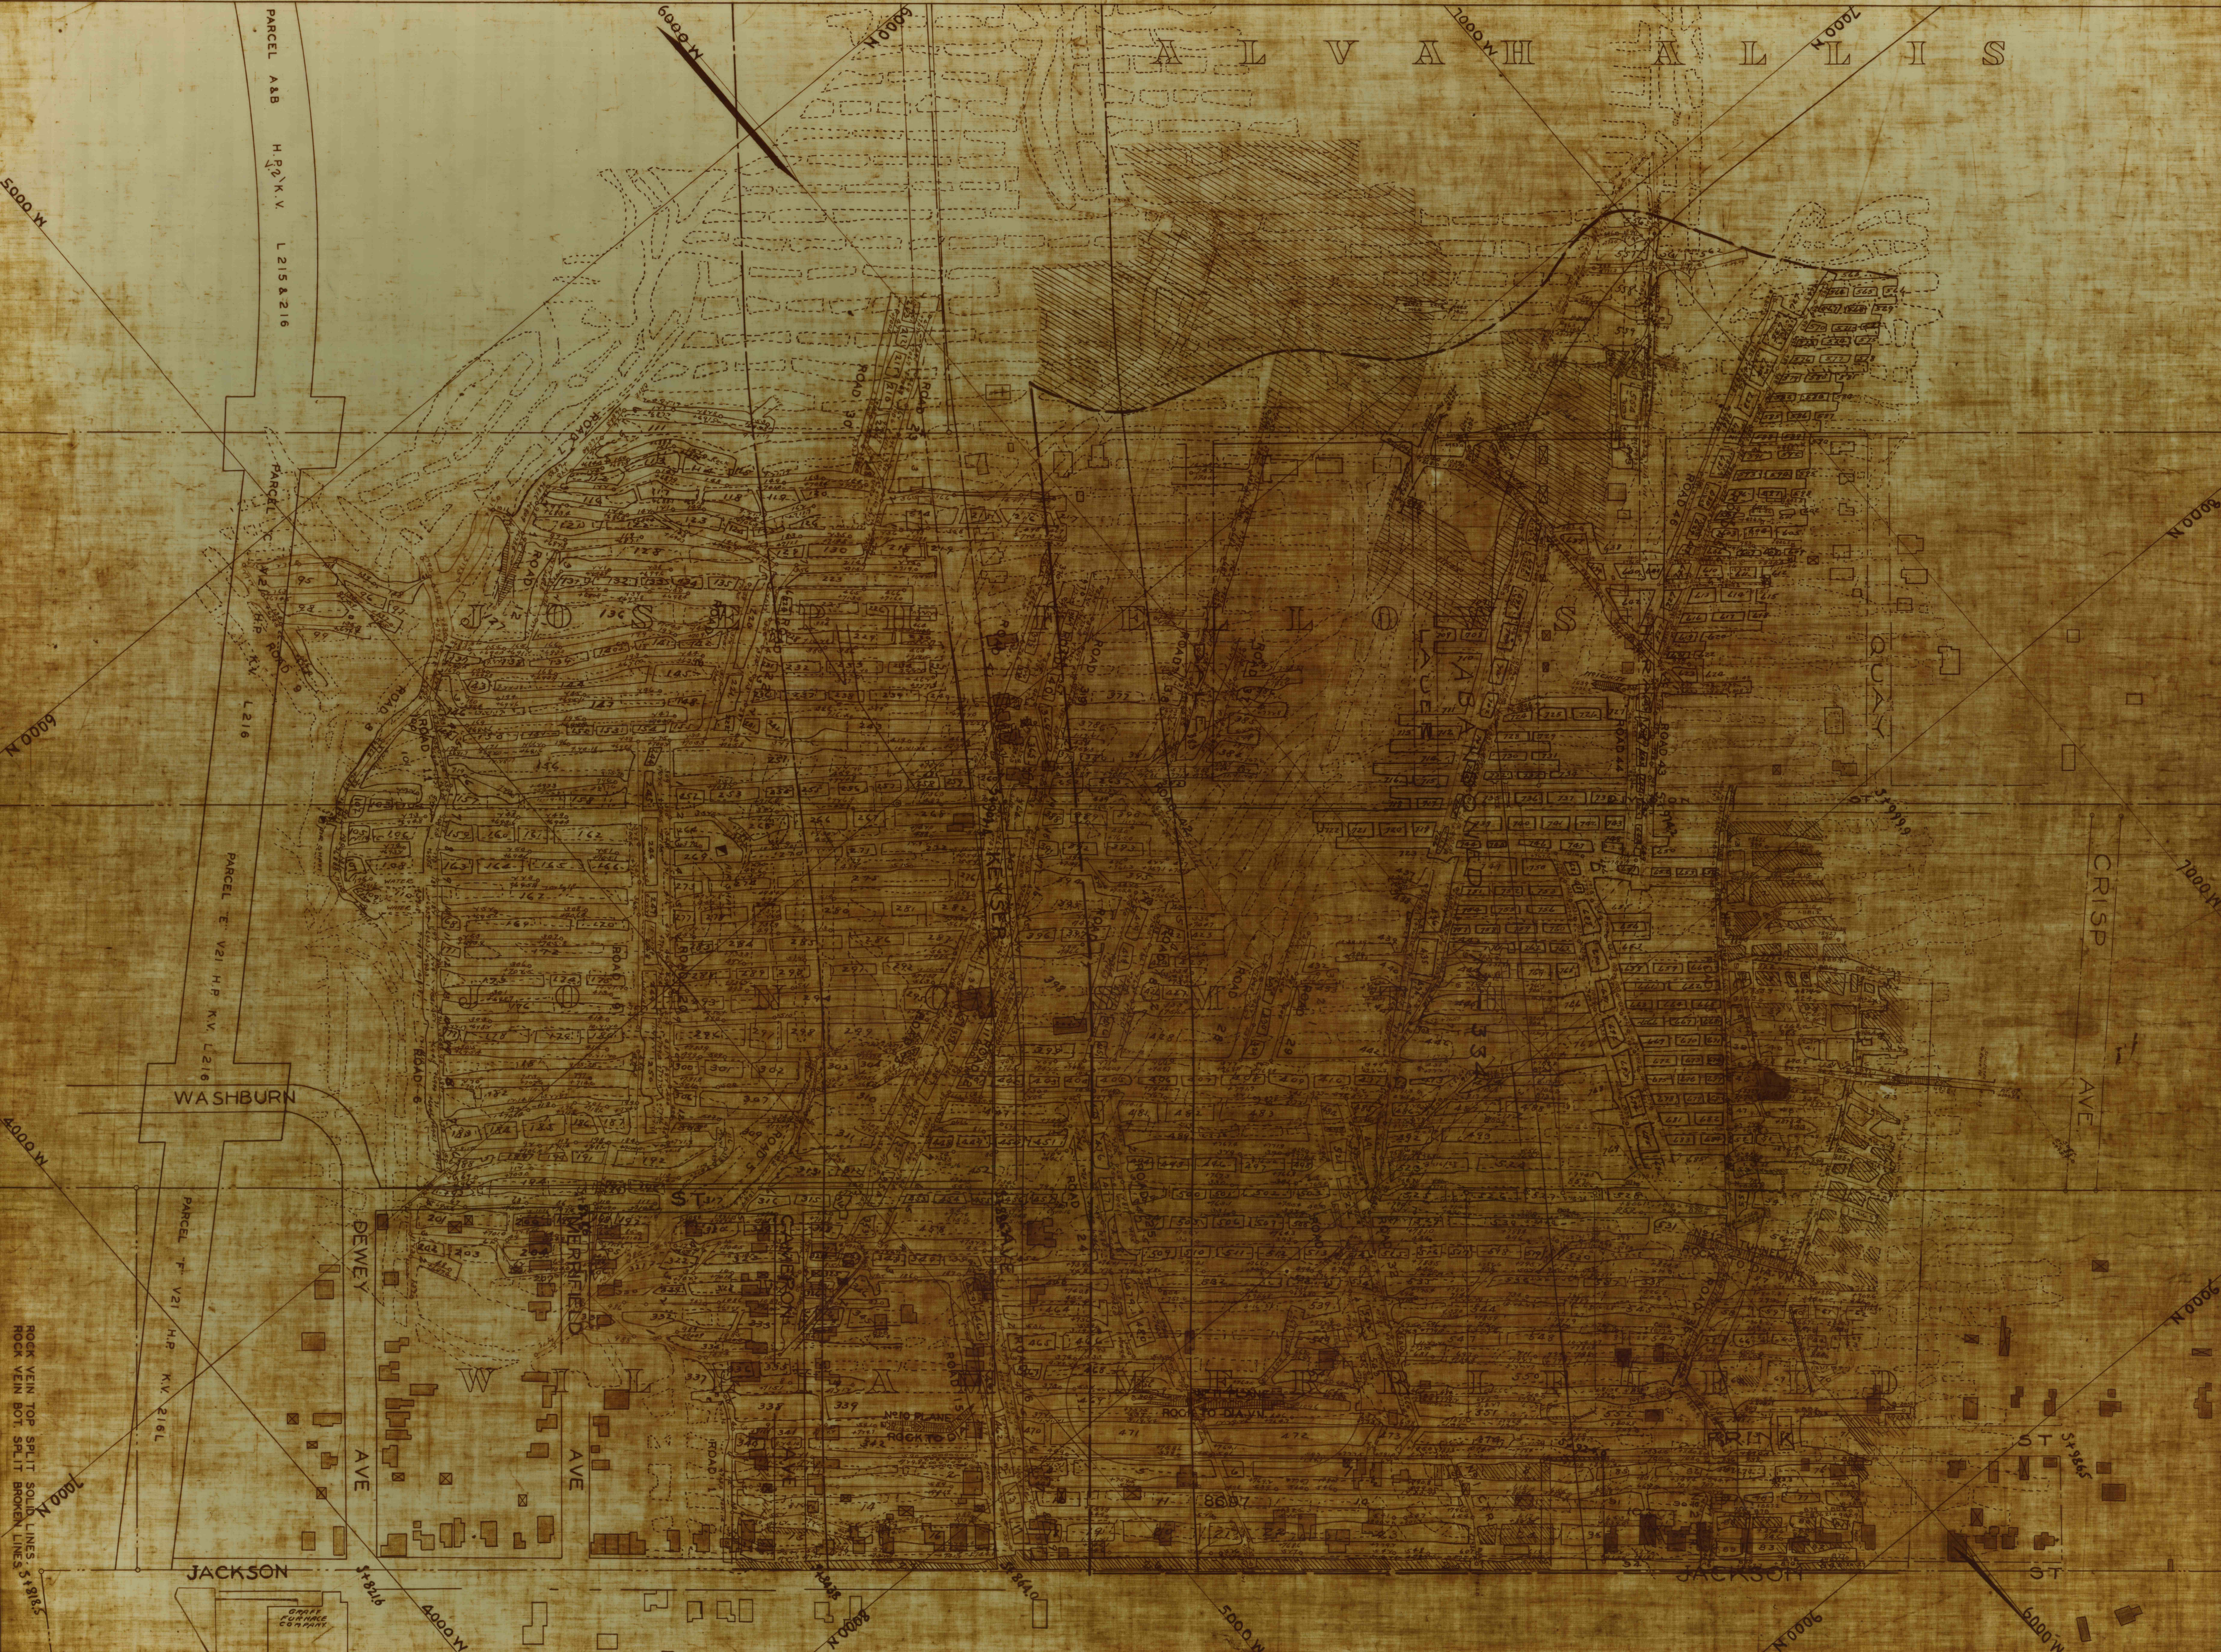

PARCEL A&B H.P. K.V. L 215 & 216

PARCEL C H.P. K.V. L 216

PARCEL E V21 H.P. K.V. L 216

PARCEL F V21 H.P. K.V. L 216

WASHBURN

DEWEY AVE

MERRIFIELD AVE

JACKSON

CRISP AVE

JACKSON

ST 5-195

ST

5000 N

6000 N

4000 N

7000 N

5000 N

6000 N

6000 N

1000 N

7000 N

8000 N

1000 N

9000 N

5000 N

ROCK VEIN TOP SPLIT SOLID LINES S 1918 S  
ROCK VEIN BOT. SPLIT BROKEN LINES

