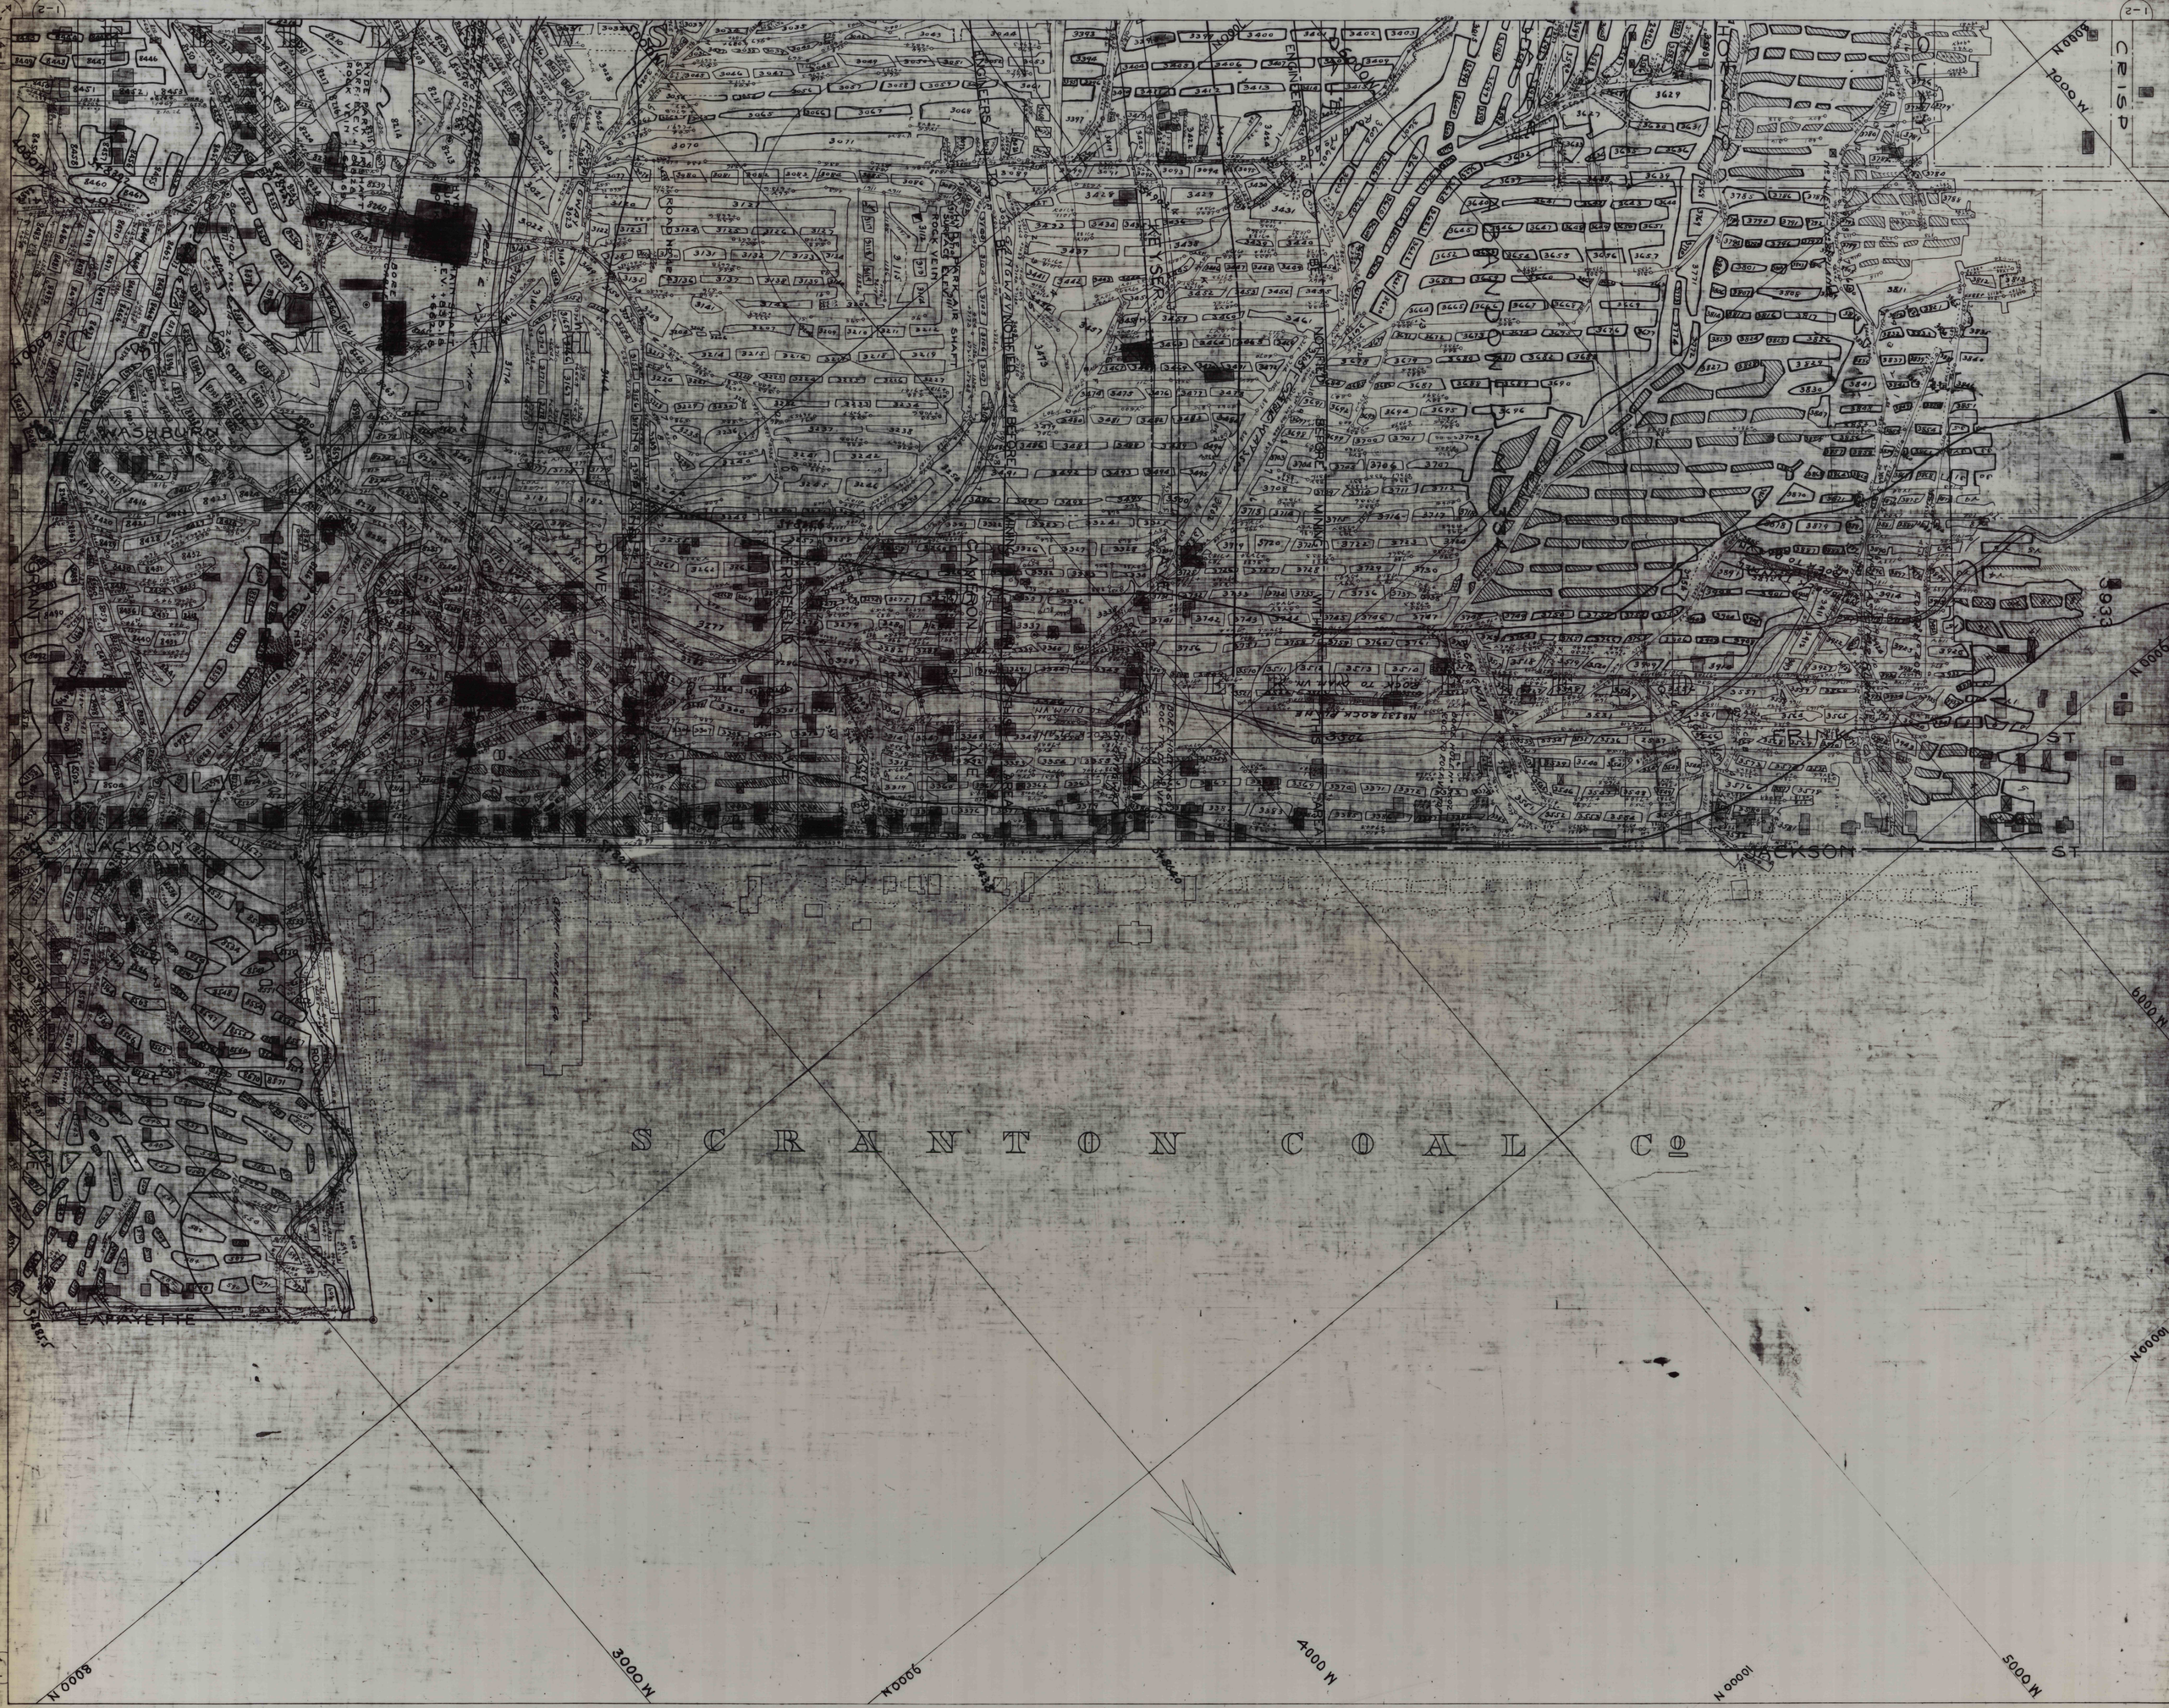

1-2
4-2
4-1
CRISP
8000 N
7000 W
6000 N
WASHBURN
GRANT
JACKSON
LAFAYETTE
PRICE
AVE
ROAD
DEWEY
MERRIFIELD
CAMERON
KEYSER
HYDE PARK AIR SHAFT SURF. ELEV. ROCK VEIN
HYDE PARK AIR SHAFT SURFACE ELEV. ROCK VEIN
MAIN SHAFT
BORE HOLE
ENGINEERS TO BE NOTIFIED BEFORE MINING WITHIN THIS AREA
GANGWAY
ROCK TO DIAM VN
BORE HOLE ROCK TO DIAM VEIN
BORE HOLE ROCK TO ROCK VEIN
FRINK ST
JACKSON ST
3933
St 8276
St 8438
St 8640
St 8855
SCRANTON COAL Co
8000 N
3000 W
9000 N
4000 W
10000 N
5000 W
6000 W
9000 N
10000 N