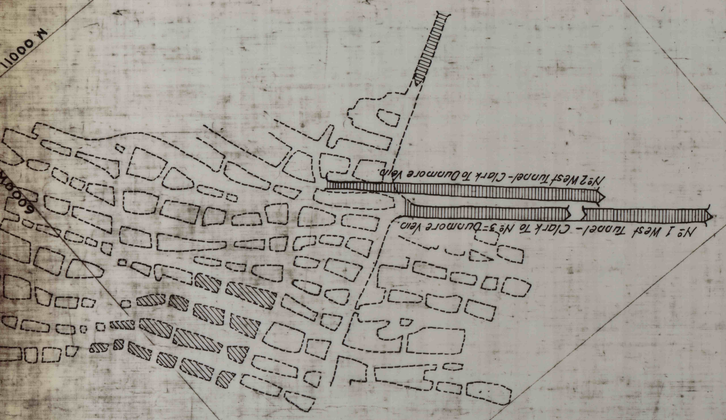
No 2 West Tunnel - Clark To Dunmore Valve
No 1 West Tunnel - Clark To No 3 - Dunmore Valve