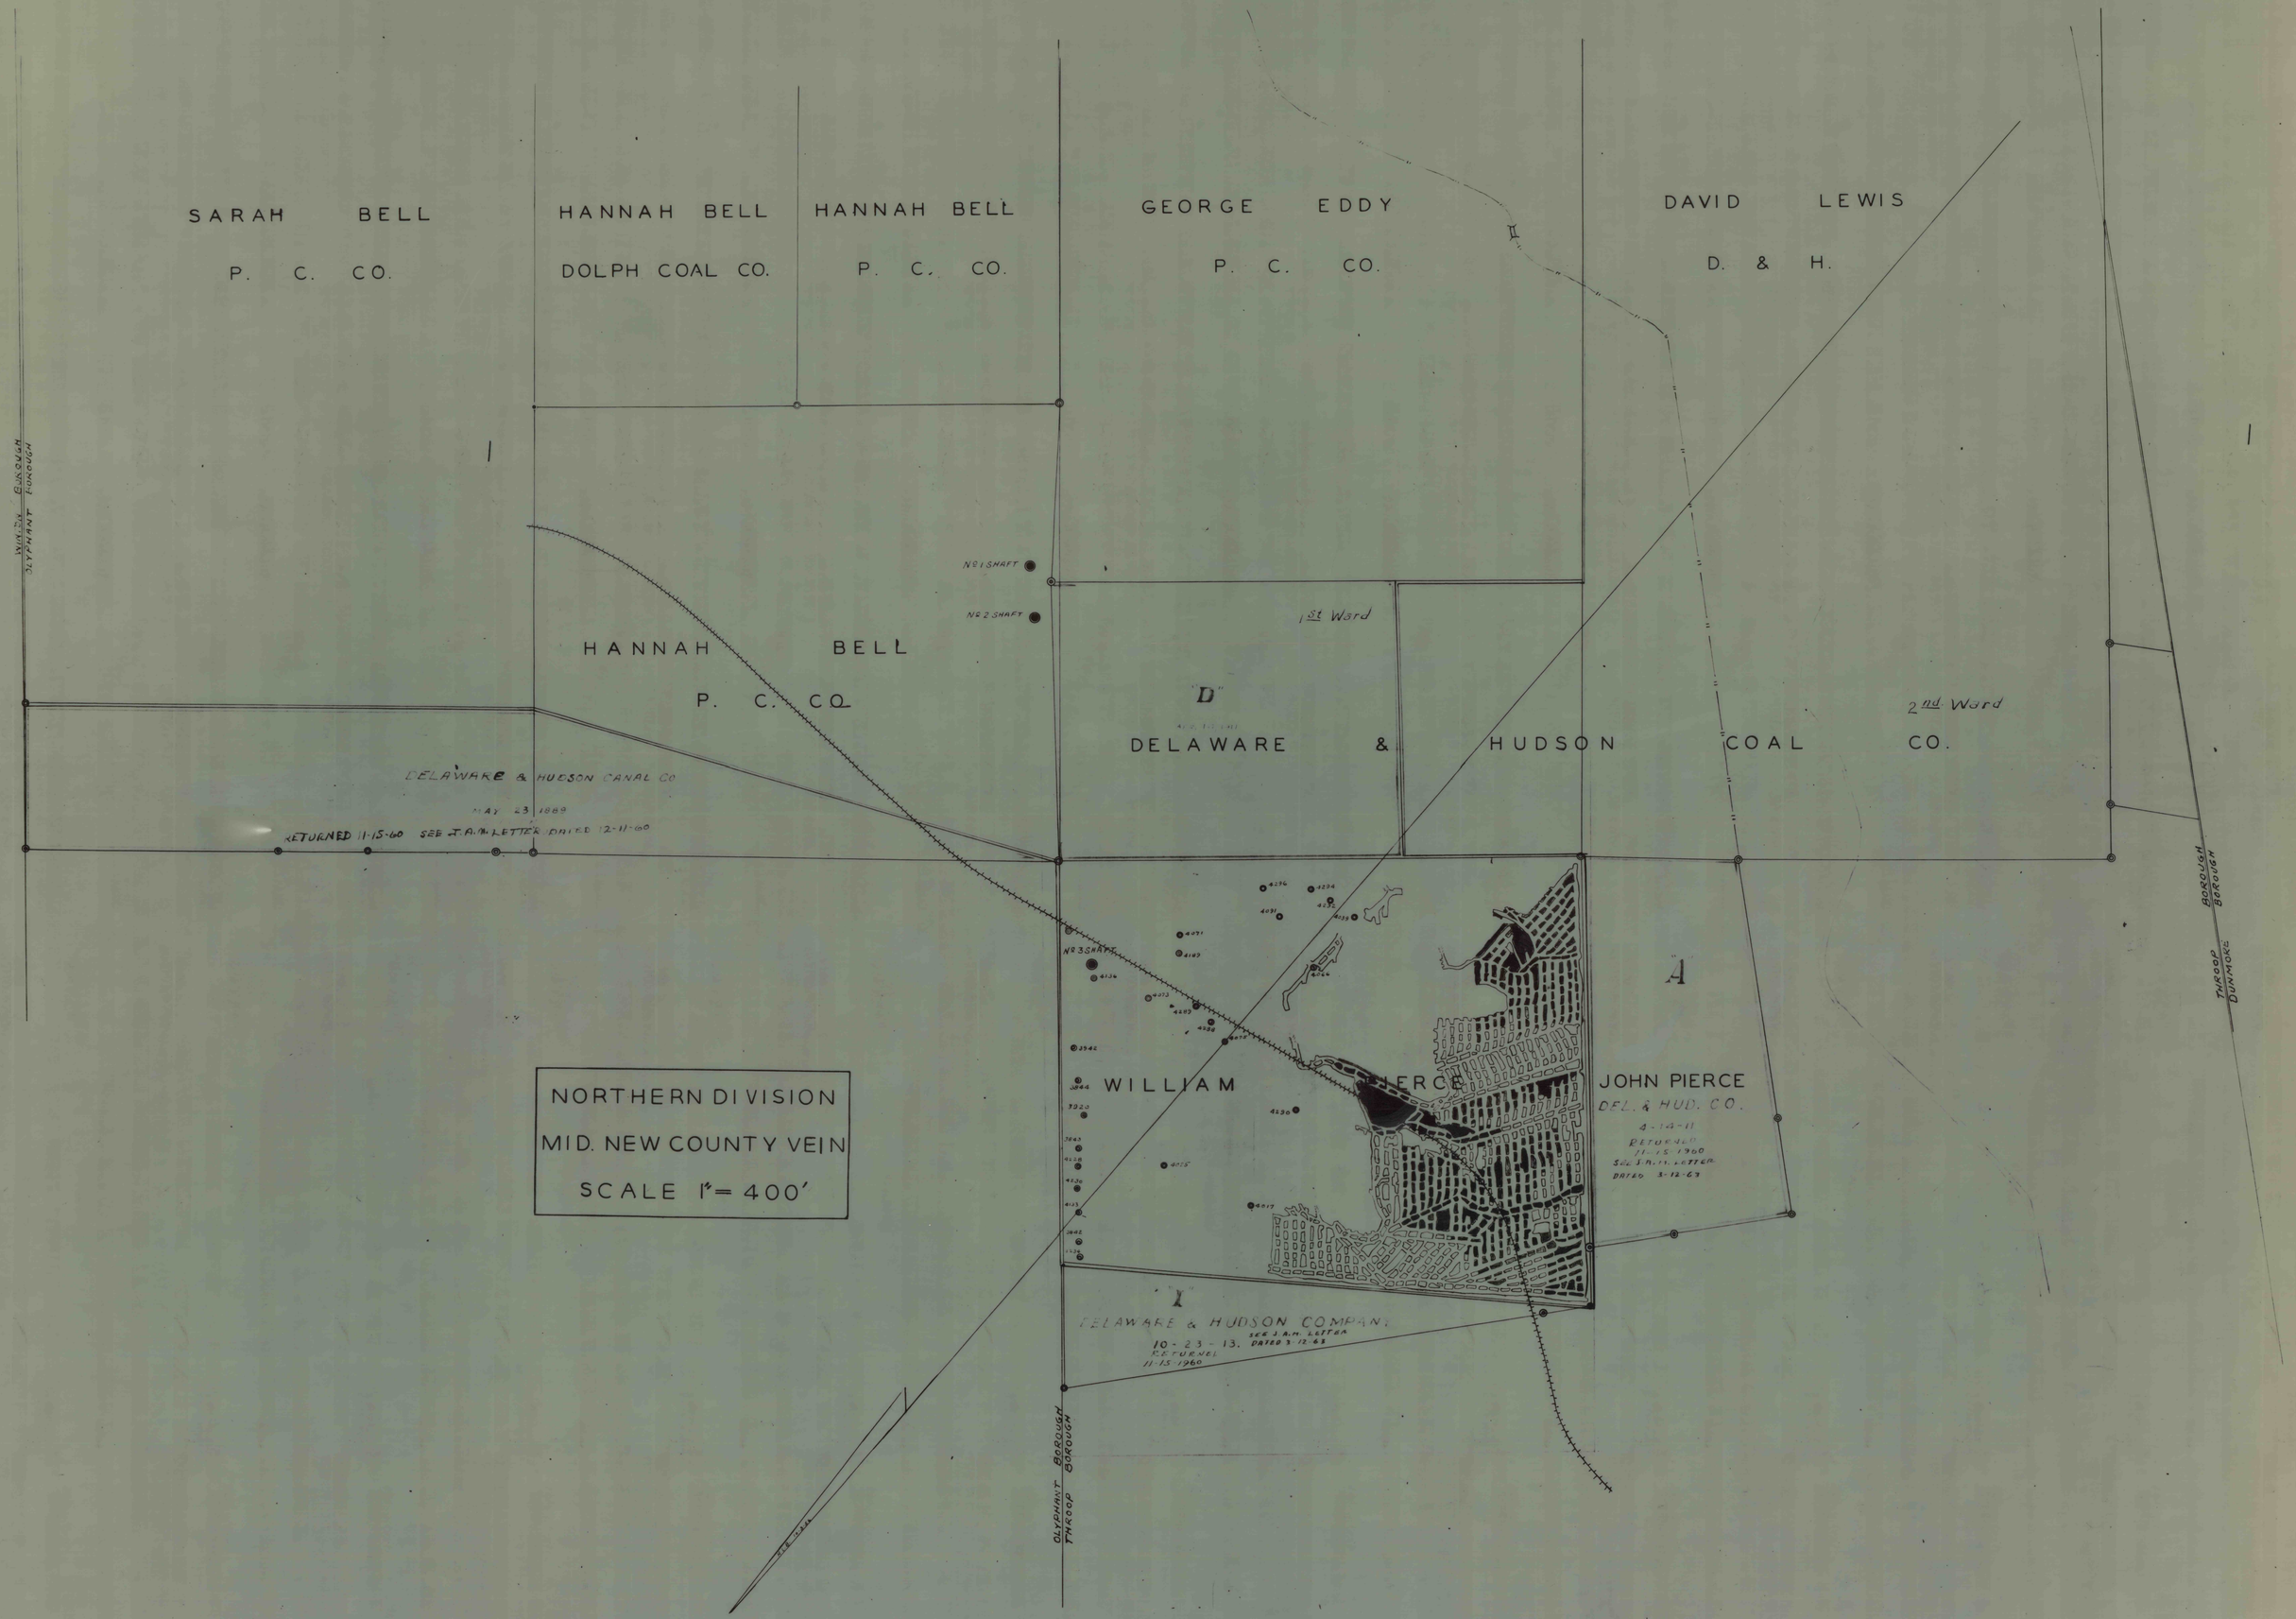
SARAH BELL
P. C. CO.
HANNAH BELL
DOLPH COAL CO.
HANNAH BELL
P. C. CO.
GEORGE EDDY
P. C. CO.
DAVID LEWIS
D. & H.
WINSON BOROUGH
OLYPHANT BOROUGH
No 1 SHAFT
No 2 SHAFT
1st Ward
HANNAH BELL
P. C. CO.
"D"
DELAWARE & HUDSON COAL CO.
2nd Ward
DELAWARE & HUDSON CANAL CO
MAY 23 1889
RETURNED 11-15-60 SEE J.A.M. LETTER DATED 12-11-60
THROOP BOROUGH
DUNMORE BOROUGH
No 3 SHAFT
"A"
WILLIAM PIERCE
JOHN PIERCE
DEL. & HUD. CO.
4-14-11
RETURNED
11-15-1960
SEE J.A.M. LETTER
DATED 3-12-63
NORTHERN DIVISION
MID. NEW COUNTY VEIN
SCALE 1" = 400'
"I"
DELAWARE & HUDSON COMPANY
10-23-13.
SEE J.A.M. LETTER
DATED 3-12-63
RETURNED
11-15-1960
OLYPHANT BOROUGH
THROOP BOROUGH