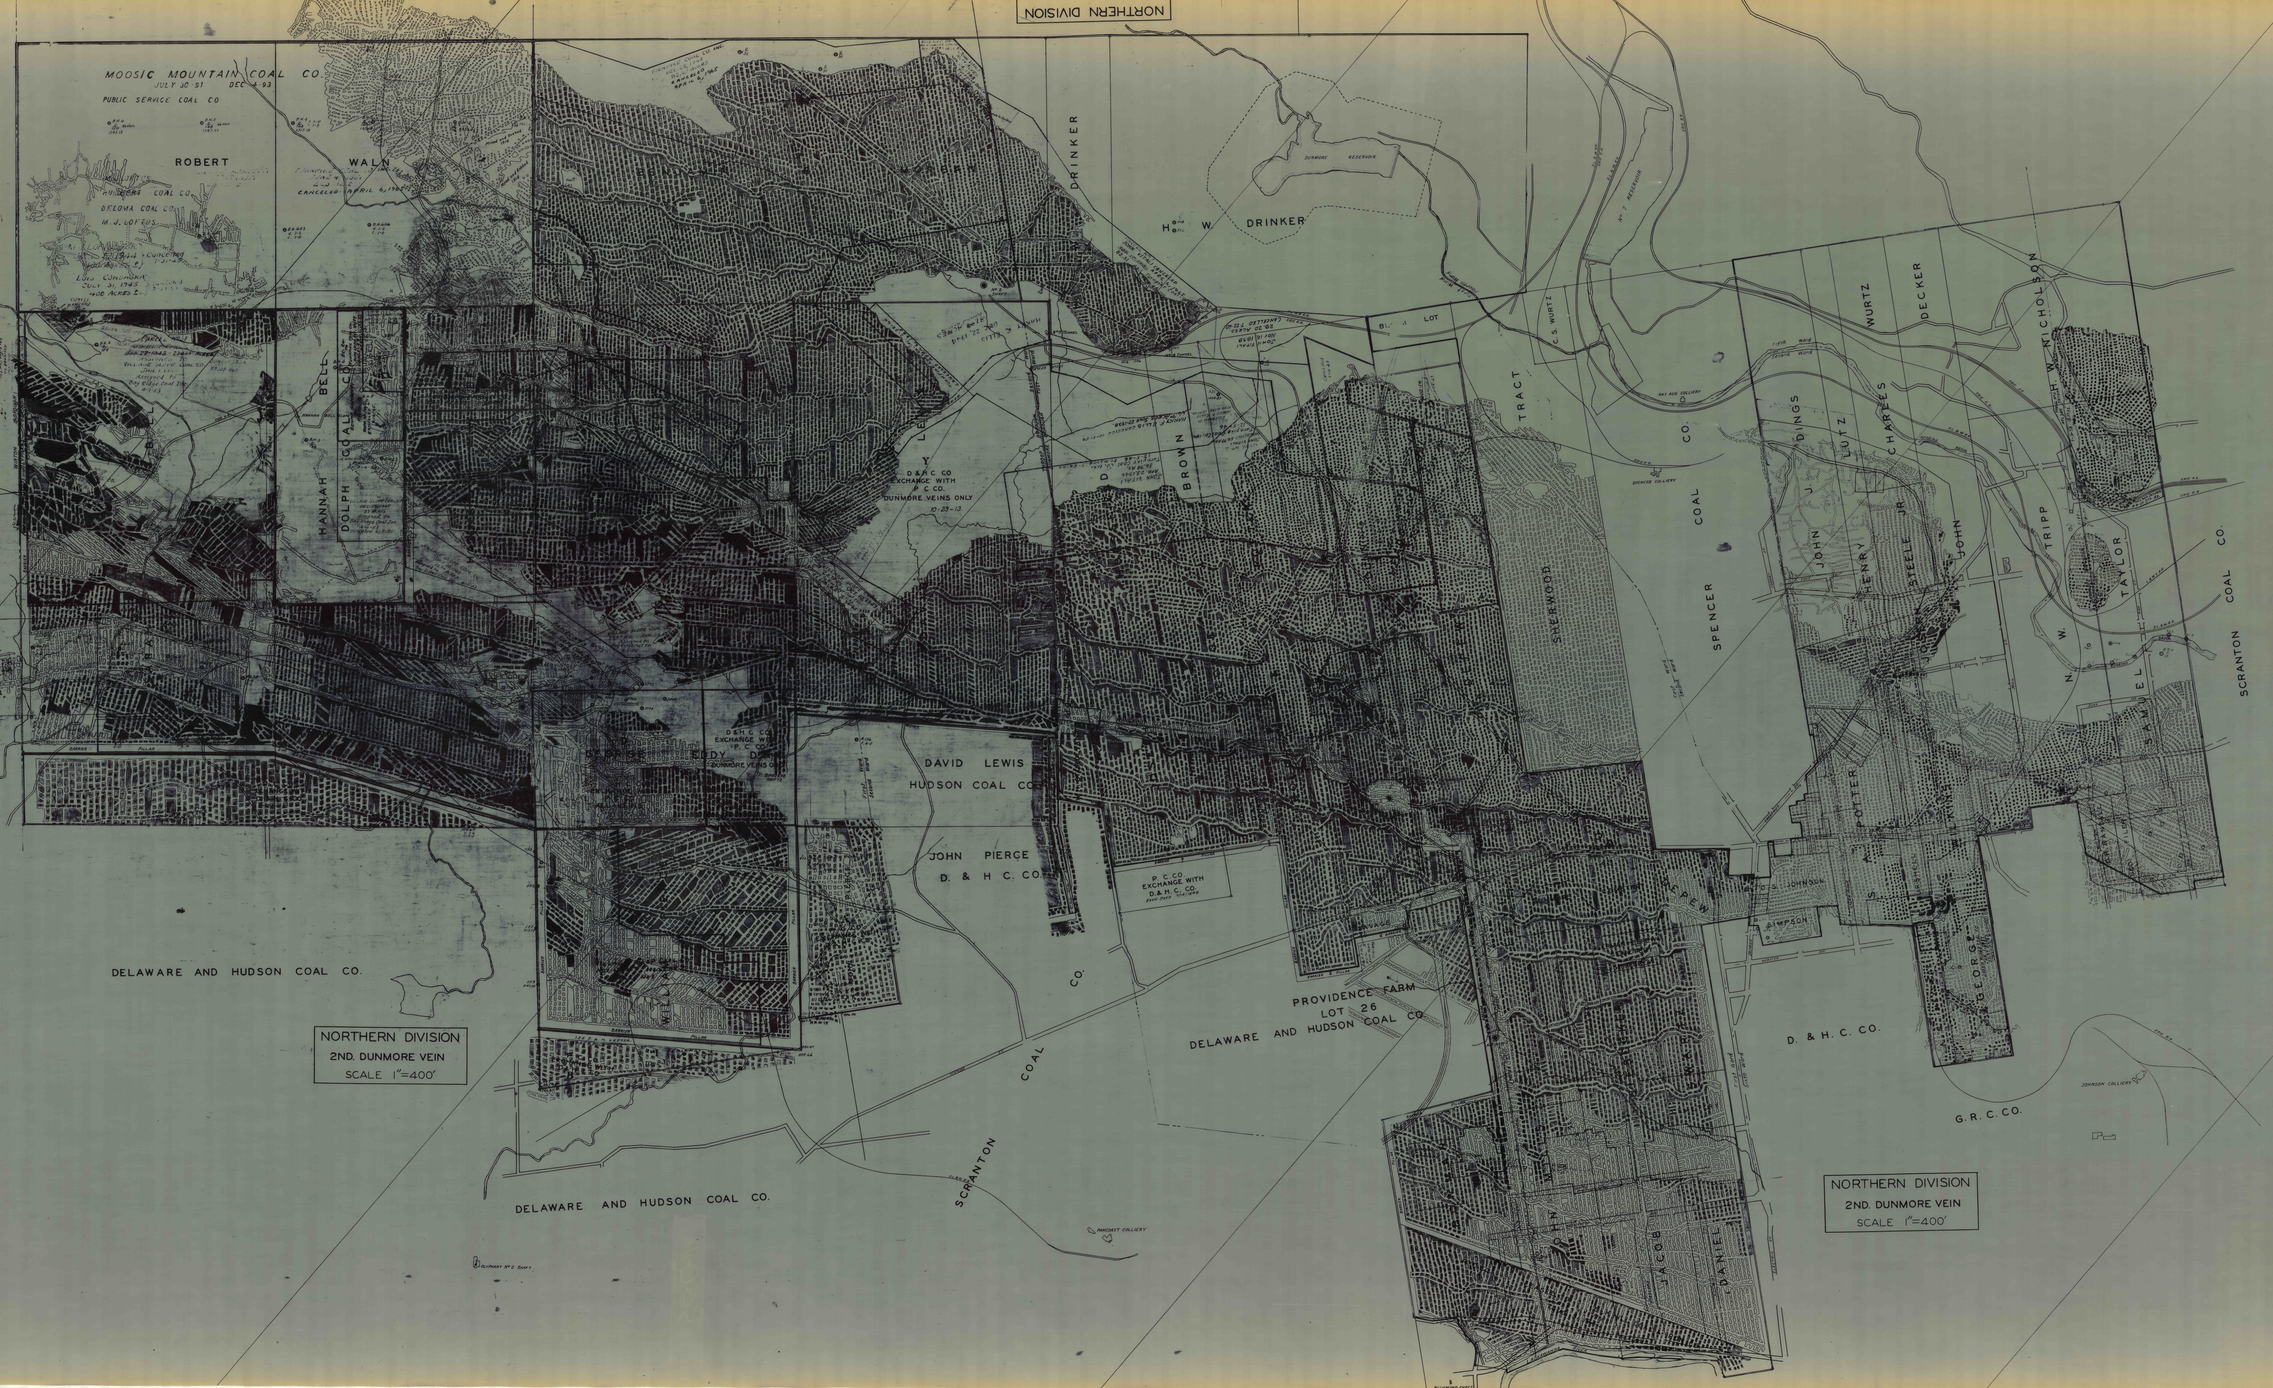
NORTHERN DIVISION
MOOSIC MOUNTAIN COAL CO.
JULY 30-51 DEC 4-93
PUBLIC SERVICE COAL CO
ROBERT
WALN
STERRICK CREEK COAL CO
HANNAH
DOLPH
BELL
COAL CO
H. W. DRINKER
DRINKER
D&H C CO
EXCHANGE WITH
P C CO
DUNMORE VEINS ONLY
10-23-12
BROWN
TRACT
SHERWOOD
SPENCER
COAL
CO.
DAVID LEWIS
HUDSON COAL CO
JOHN PIERCE
D. & H. C. CO.
P. C. CO
EXCHANGE WITH
D.&H. C. CO.
PROVIDENCE FARM
LOT 26
DELAWARE AND HUDSON COAL CO.
DELAWARE AND HUDSON COAL CO.
SCRANTON
COAL
CO.
DELAWARE AND HUDSON COAL CO.
NORTHERN DIVISION
2ND. DUNMORE VEIN
SCALE 1"=400'
WURTZ
DECKER
NICHOLSON
JOHN
LUTZ
CHAPPES
STEELE JR
TRIPP
TAYLOR
POTTER
GREGORY
D. & H. C. CO.
G. R. C. CO.
SCRANTON COAL CO.
NORTHERN DIVISION
2ND. DUNMORE VEIN
SCALE 1"=400'