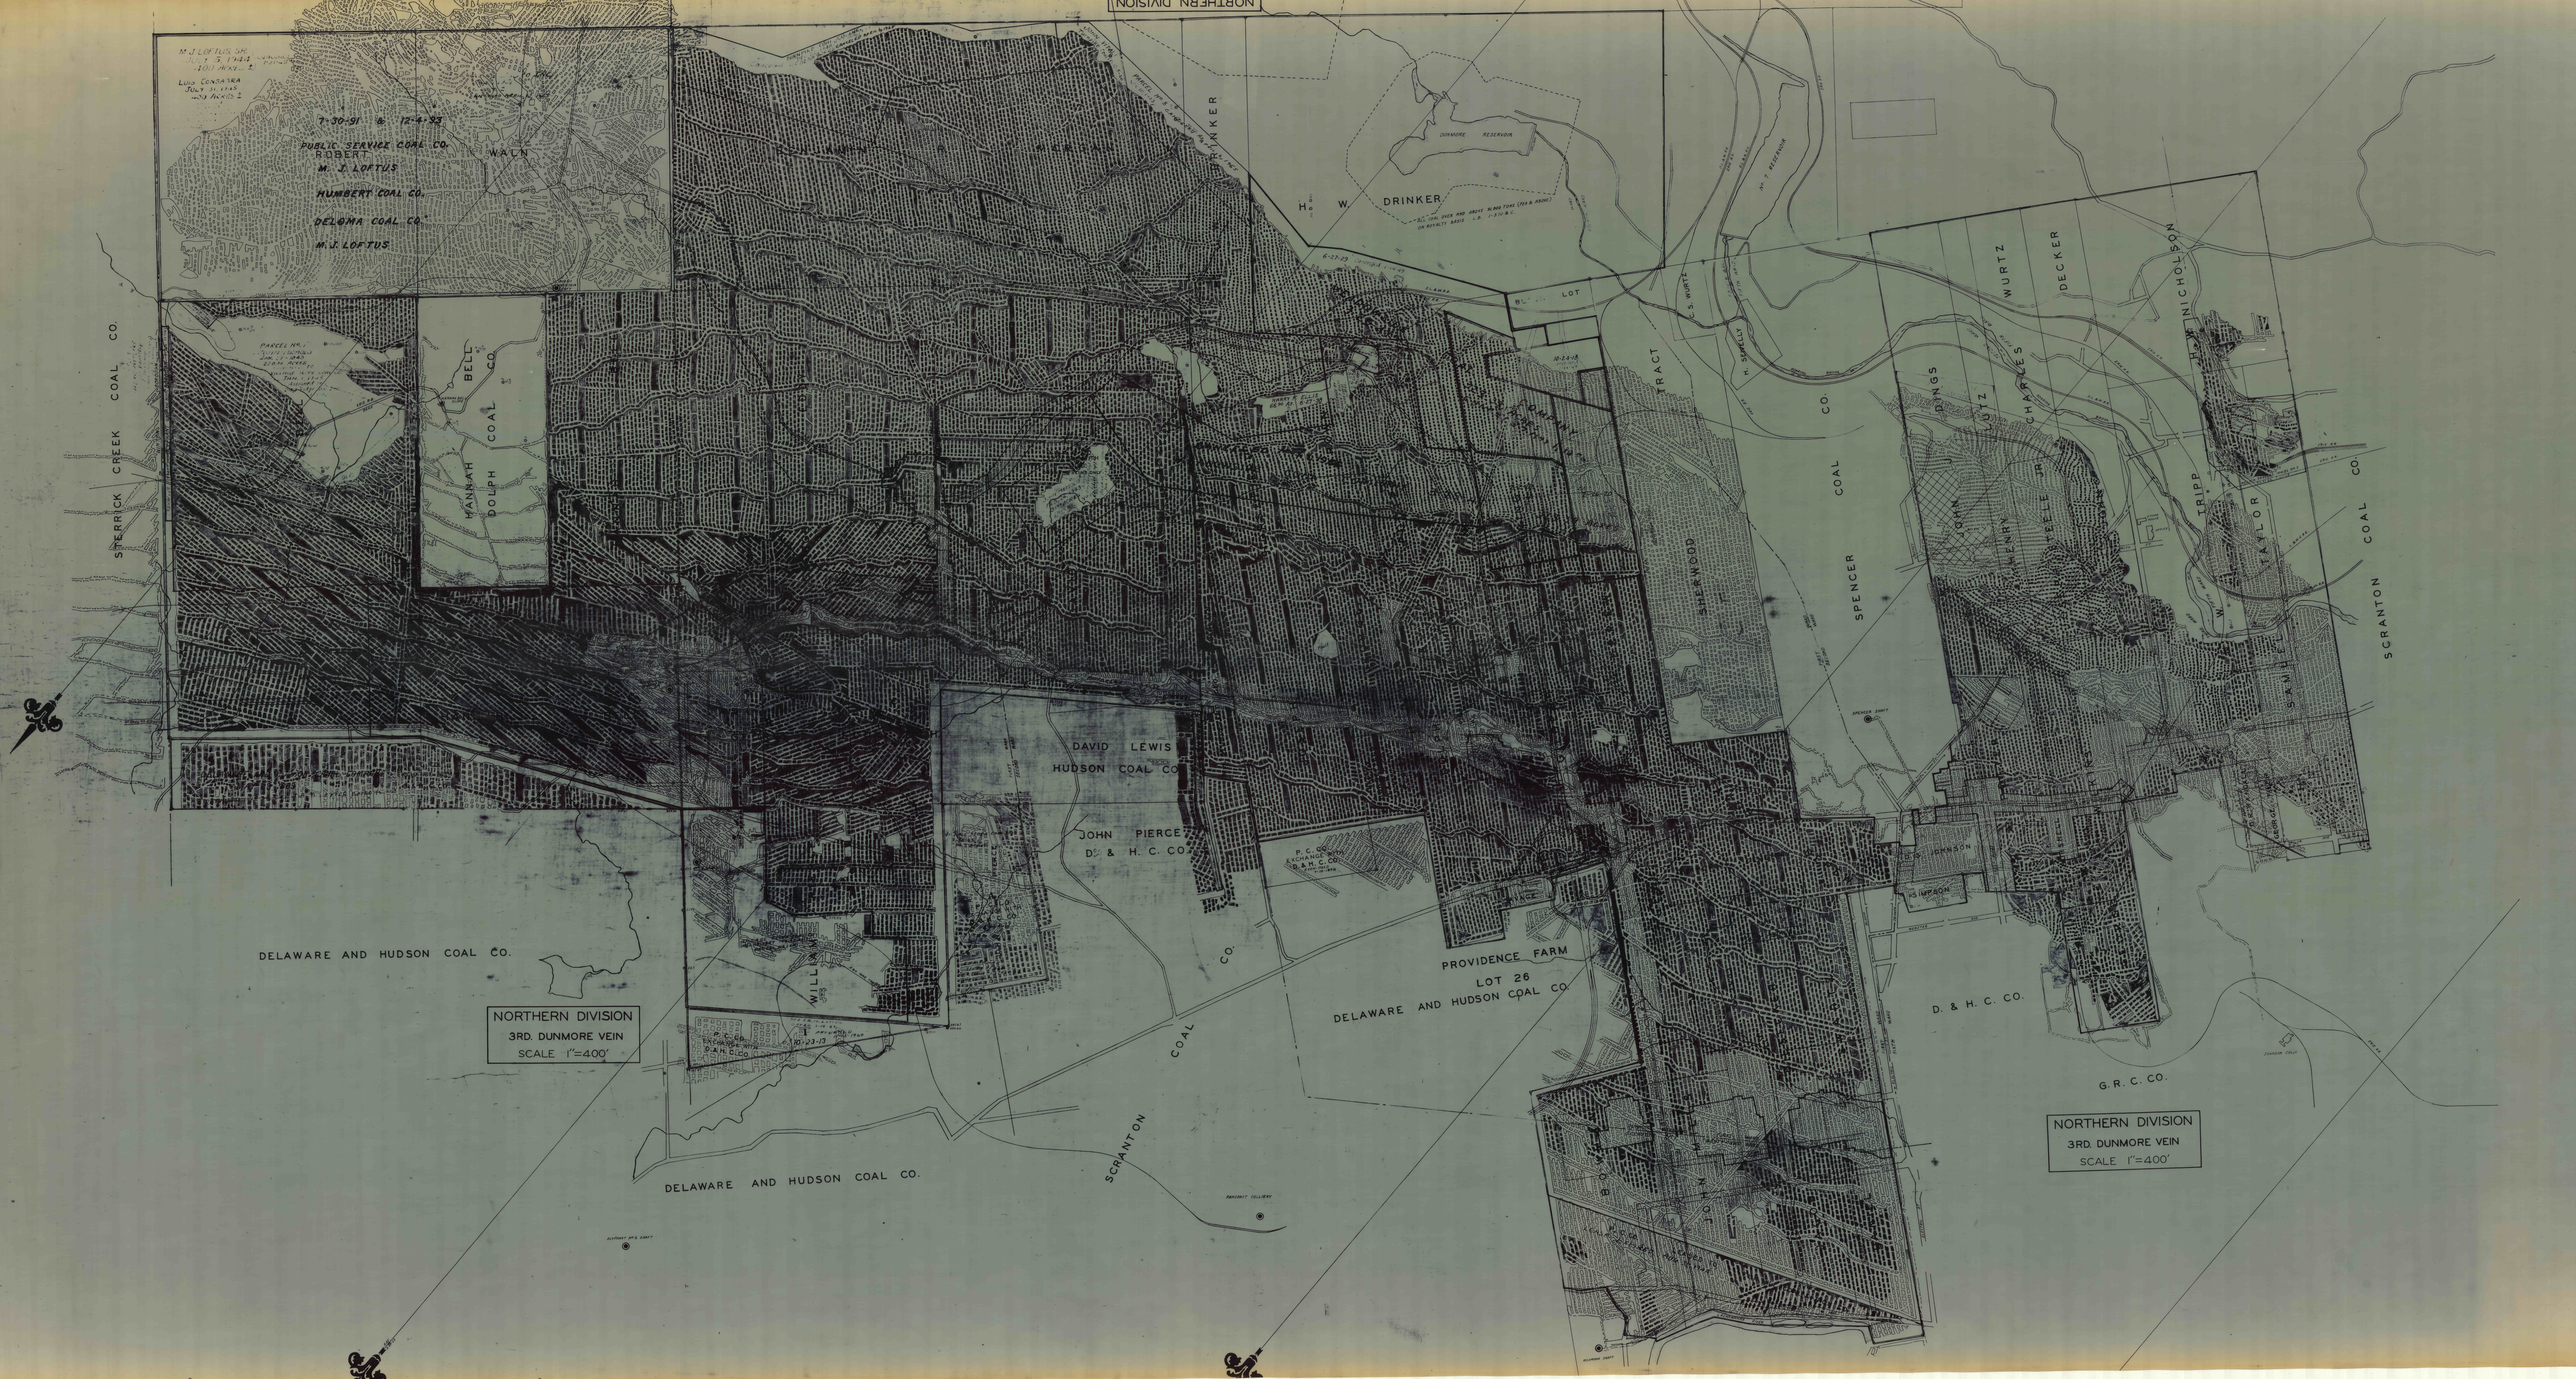
NORTHERN DIVISION
7-30-91 & 12-4-93
PUBLIC SERVICE COAL CO.
ROBERT WALN
M. J. LOFTUS
HUMBERT COAL CO.
DELOMA COAL CO.
M. J. LOFTUS
H. W. DRINKER
DRINKER
STERRICK CREEK COAL CO.
BELL
HANNAH DOLPH COAL CO.
SHERWOOD TRACT
SPENCER COAL CO.
WURTZ
DECKER
NICHOLSON
TRIPP
TAYLOR
SCRANTON COAL CO.
DAVID LEWIS
HUDSON COAL CO.
JOHN PIERCE
D. & H. C. CO.
DELAWARE AND HUDSON COAL CO.
NORTHERN DIVISION
3RD. DUNMORE VEIN
SCALE 1"=400'
PROVIDENCE FARM
LOT 26
DELAWARE AND HUDSON COAL CO.
SCRANTON COAL CO.
D. & H. C. CO.
G. R. C. CO.
NORTHERN DIVISION
3RD. DUNMORE VEIN
SCALE 1"=400'
DELAWARE AND HUDSON COAL CO.