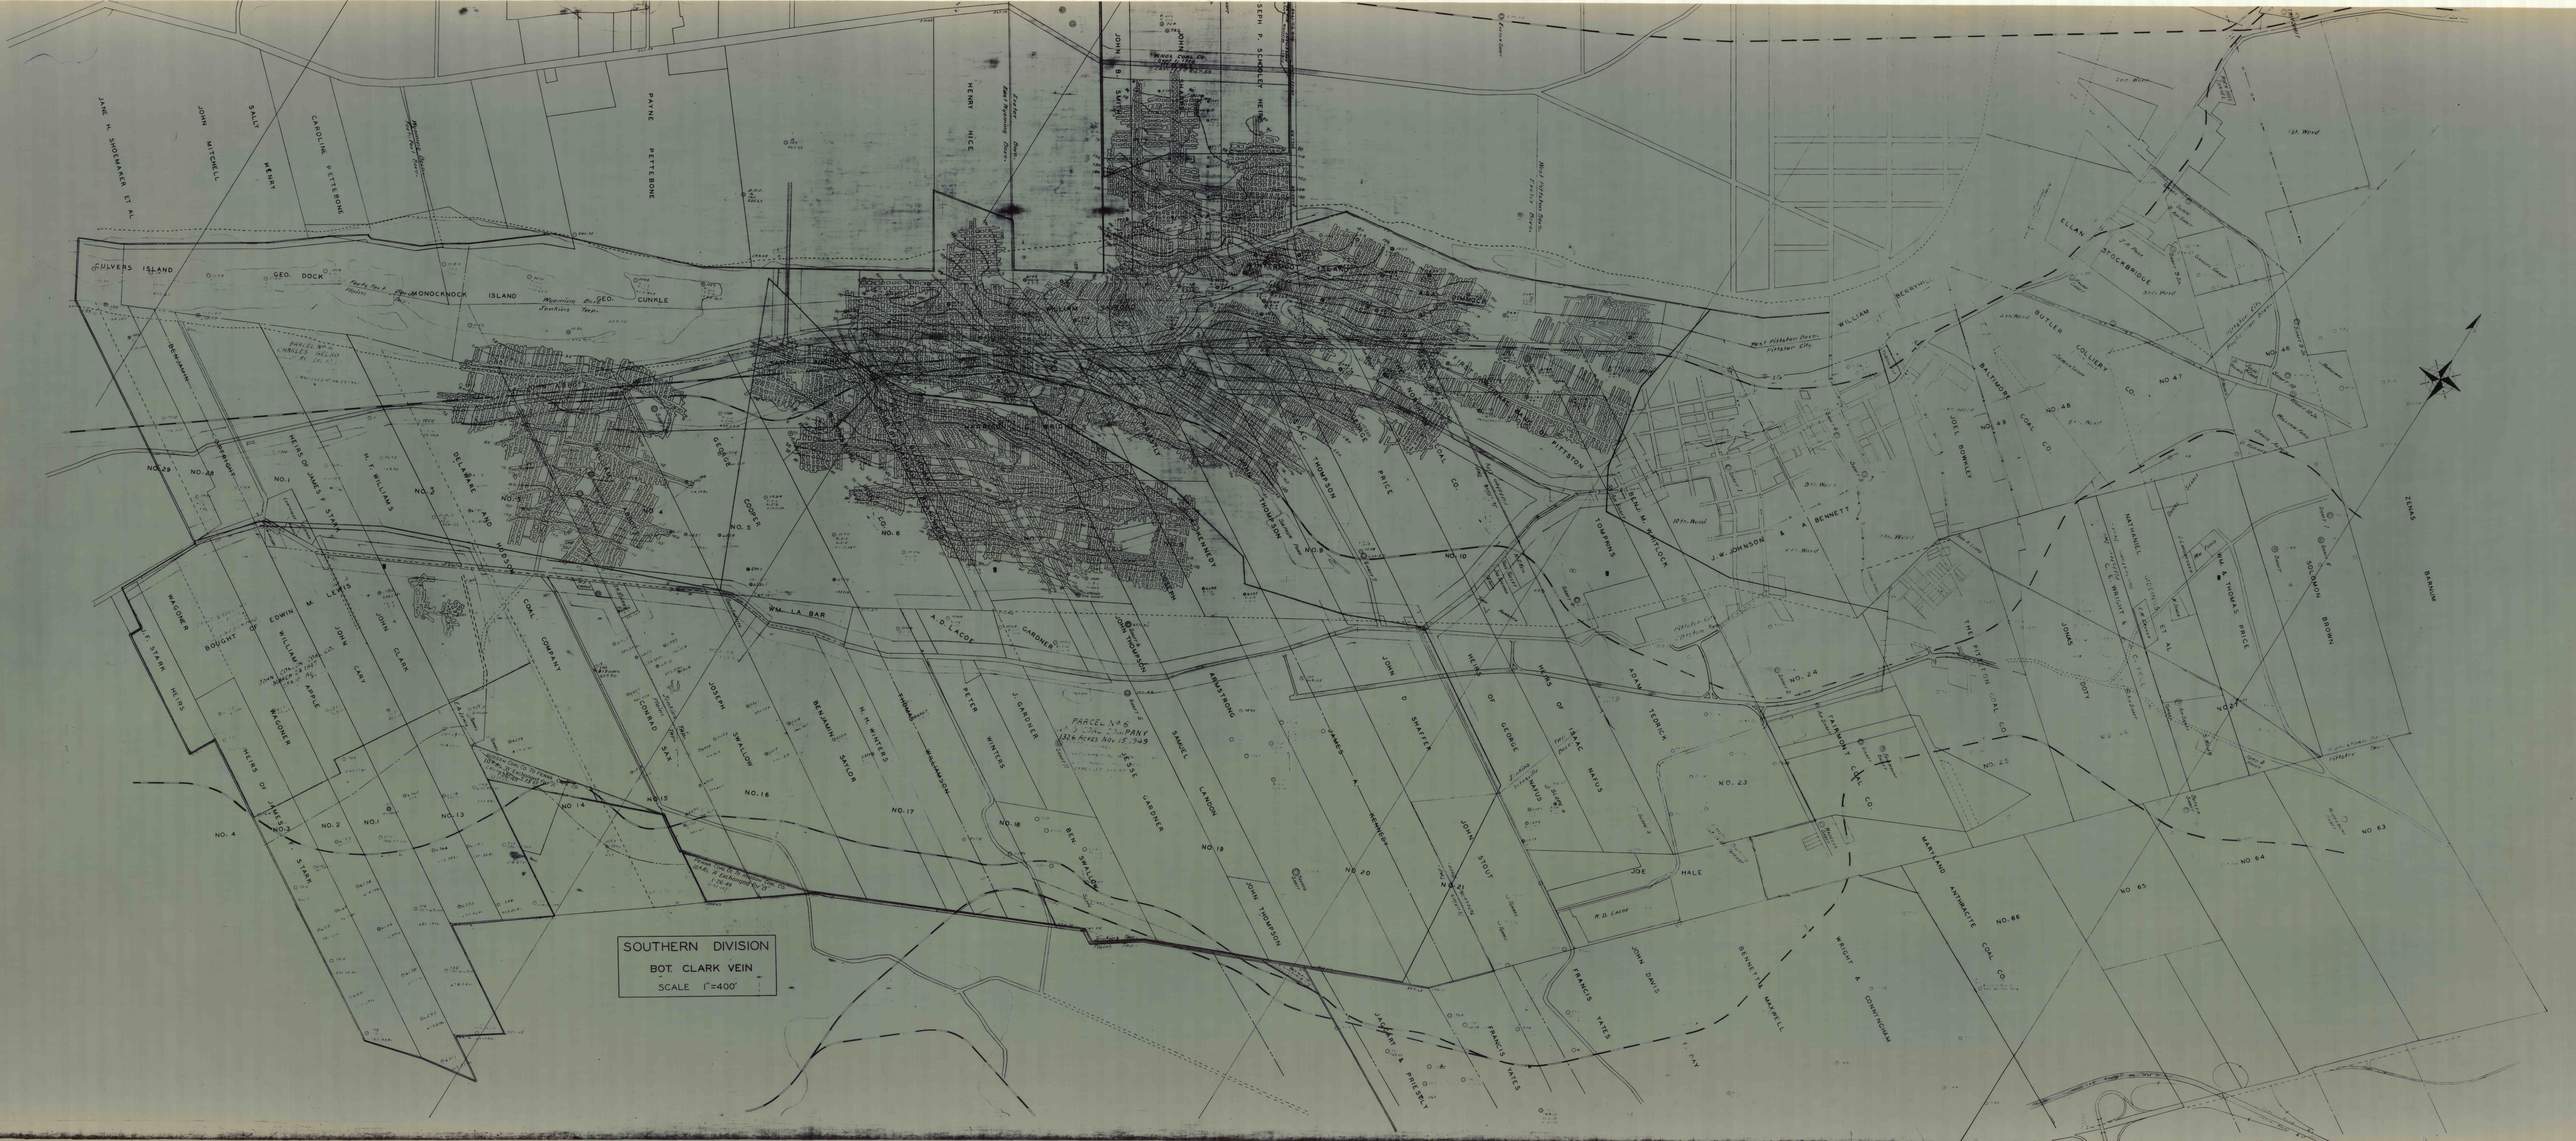
SOUTHERN DIVISION
BOT. CLARK VEIN
SCALE 1"=400'
JANE H. SHOEMAKER ET AL
JOHN MITCHELL
SALLY HENRY
CAROLINE PETTEBONE
PAYNE PETTEBONE
HENRY HICE
GULVERS ISLAND
GEO. DOCK
MONOCKNOCK ISLAND
GEO. CUNKLE
WM. LA BAR
A. D. LACOE
GARDNER
ARMSTRONG
SAMUEL LANDON
JOHN THOMPSON
JOHN STOUT
FRANCIS YATES
JOHN DAVIS
BENJAMIN MAXWELL
WRIGHT & CUNNINGHAM
MARYLAND ANTHRACITE COAL CO.
JOE HALE
ADAM TERRICK
ISAAC HAYES
HEIRS OF GEORGE HAYES
JOHN D. SHAFER
JAMES A. HENNESS
PETER WINTERS
J. GARDNER
BEN. SWALLOW
JOSEPH SWALLOW
BENJAMIN SAYLOR
H. H. WINTERS
CONRAD SAX
WAGONER
BOUGHT
EDWIN H. LEE
JOHN CLARK
JOHN CAYT
WILLIAM S. APPLE
HEIRS OF JAMES F. STARR
H. F. WILLIAMS
DELAWARE AND HUDSON COAL COMPANY
GEORGE COOPER
WM. THOMPSON
JOHN THOMPSON
PRICE
THOMPSON
PITTSTON
WILLIAM MERTHIL
ELLAN STOCKBRIDGE
BUTLER COLLIERY CO.
BALTIMORE COAL CO.
JOEL ROWLEY
J. W. JOHNSON & A. BENNETT
THOMAS PRICE
SOLOMON BROWN
JONAS BARNUM
JONAS DOTY
NATHANIEL
THE PITTSTON COAL CO.
PARCEL No 6
PITTSTON COAL COMPANY
