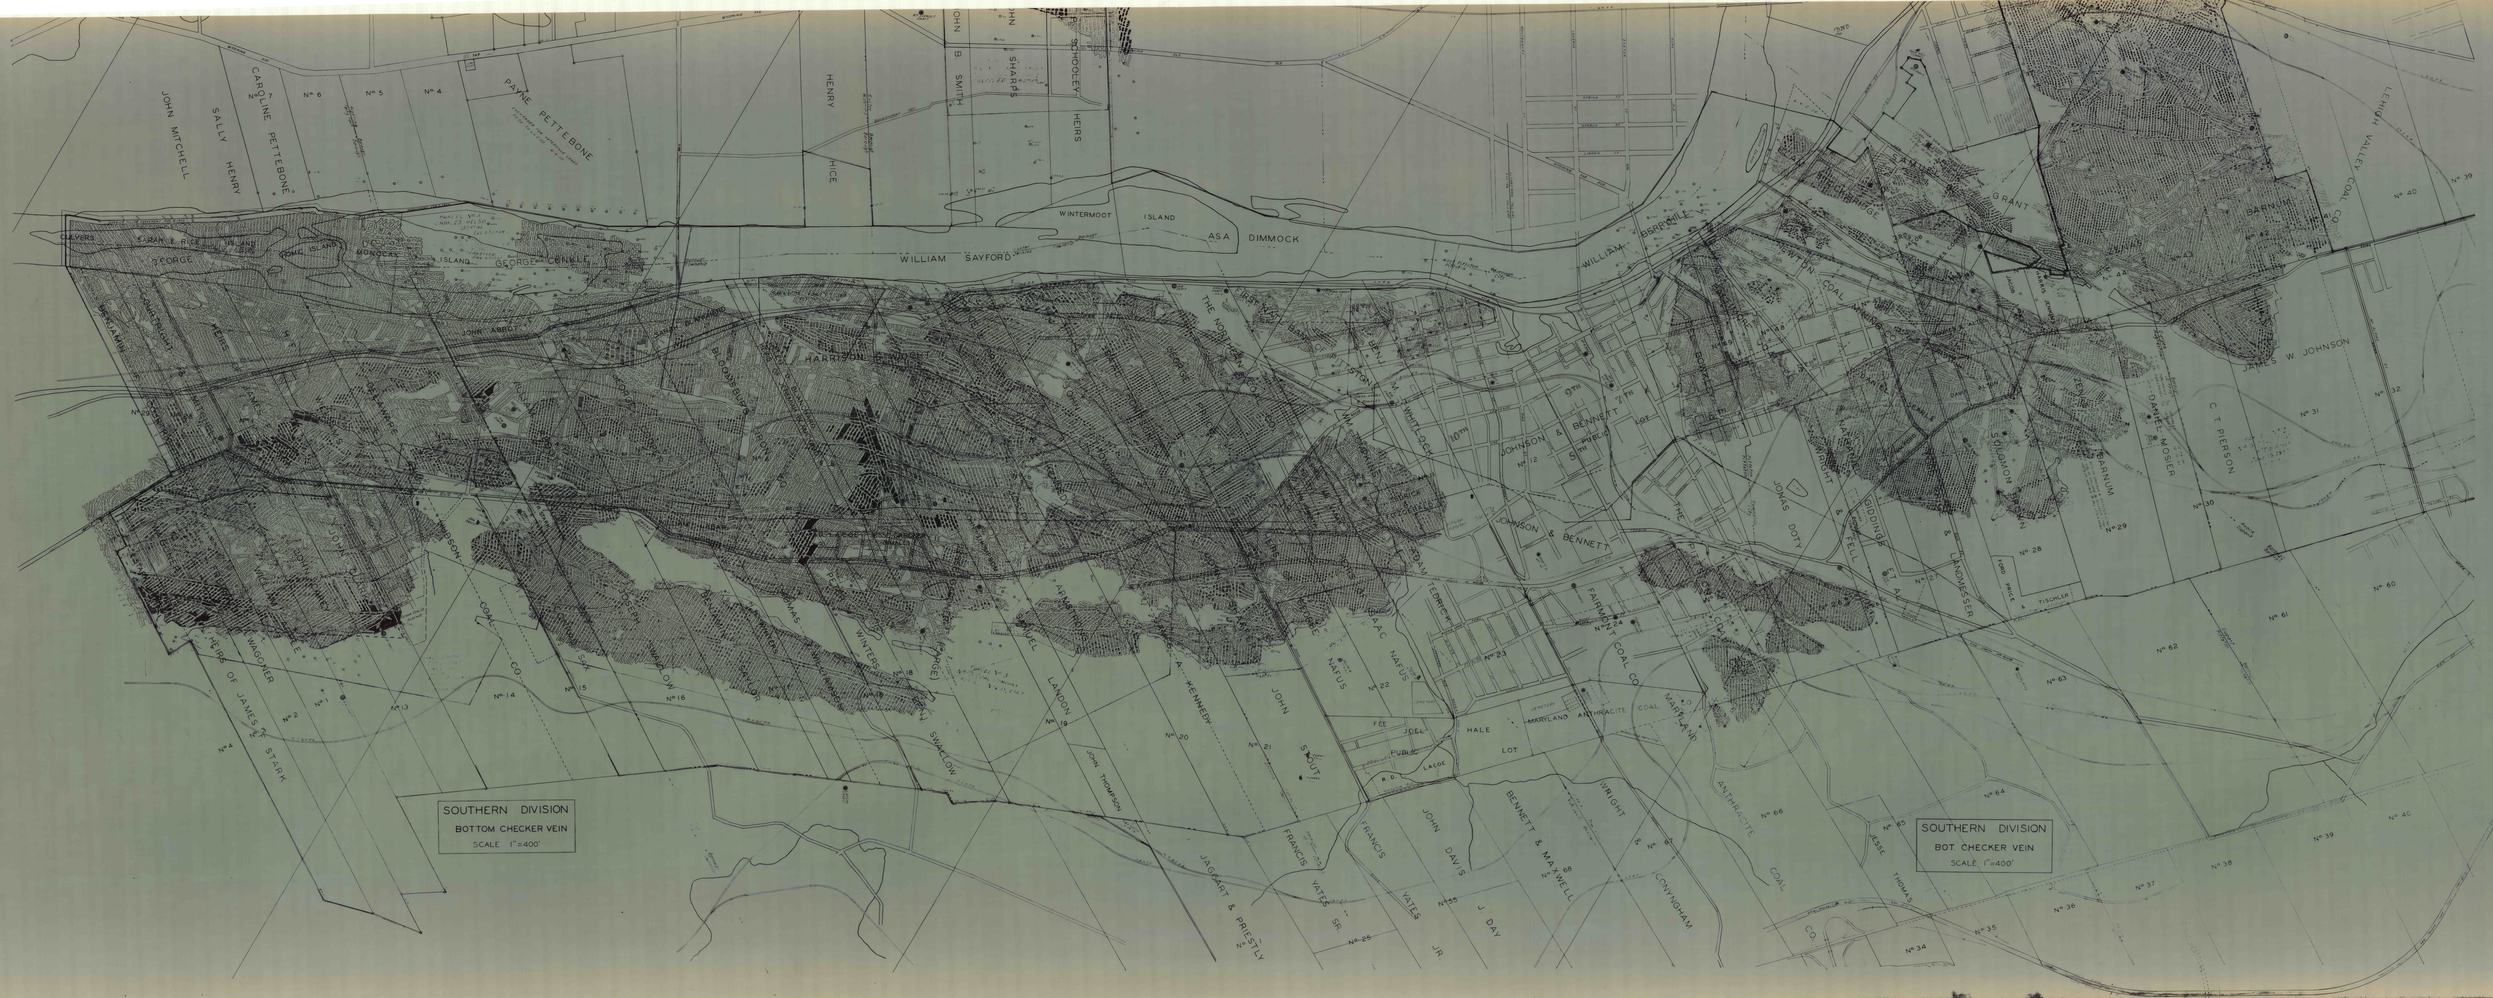
SOUTHERN DIVISION
BOTTOM CHECKER VEIN
SCALE 1"=400'
SOUTHERN DIVISION
BOT. CHECKER VEIN
SCALE 1"=400'
WILLIAM SAYFORD
ASA DIMMOCK
WINTERMOOT ISLAND
HARRISON
JOHNSON & BENNETT
FAIRMONT COAL CO
MARYLAND ANTHRACITE COAL CO
JAMES W JOHNSON
C T PIERSON
DANIEL MOSER
JOHN MITCHELL
SALLY HENRY
CAROLINE PETTEBONE
PAYNE PETTEBONE
HENRY HICE
JOHN B SMITH
SHARPE SCHOOLEY HEIRS
JOHN THOMPSON
JOHN DAVIS
BENNETT & MAXWELL
JAGGEART & PRIESTLY
FRANCIS YATES SR.
FRANCIS YATES JR
J DAY
JONNYNGHAM
WRIGHT
ANTHRACITE COAL CO
JESSE THOMAS
LEHIGH VALLEY COAL CO
GRANT
BARNUM
WILLIAM BERNVILLE
THE NORTHERN COAL MINING CO
JOHN WHITLOCK
JOHN SCOTT
JOEL LANDON
JOEL PUBLIC LANDS
HALE LOT
FEE
SWALLOW
WINTERS
MASS
ALEXANDER
ROBERT LARGE
SARAH RICE
GEORGE
MONOCACY ISLAND
GEORGE CENELL
JAMES STARK
WAGGONER
HEIRS OF JAMES M STARK
ABBOTT
PROSSER
THOMPSON
COAL CO
No 1
No 2
