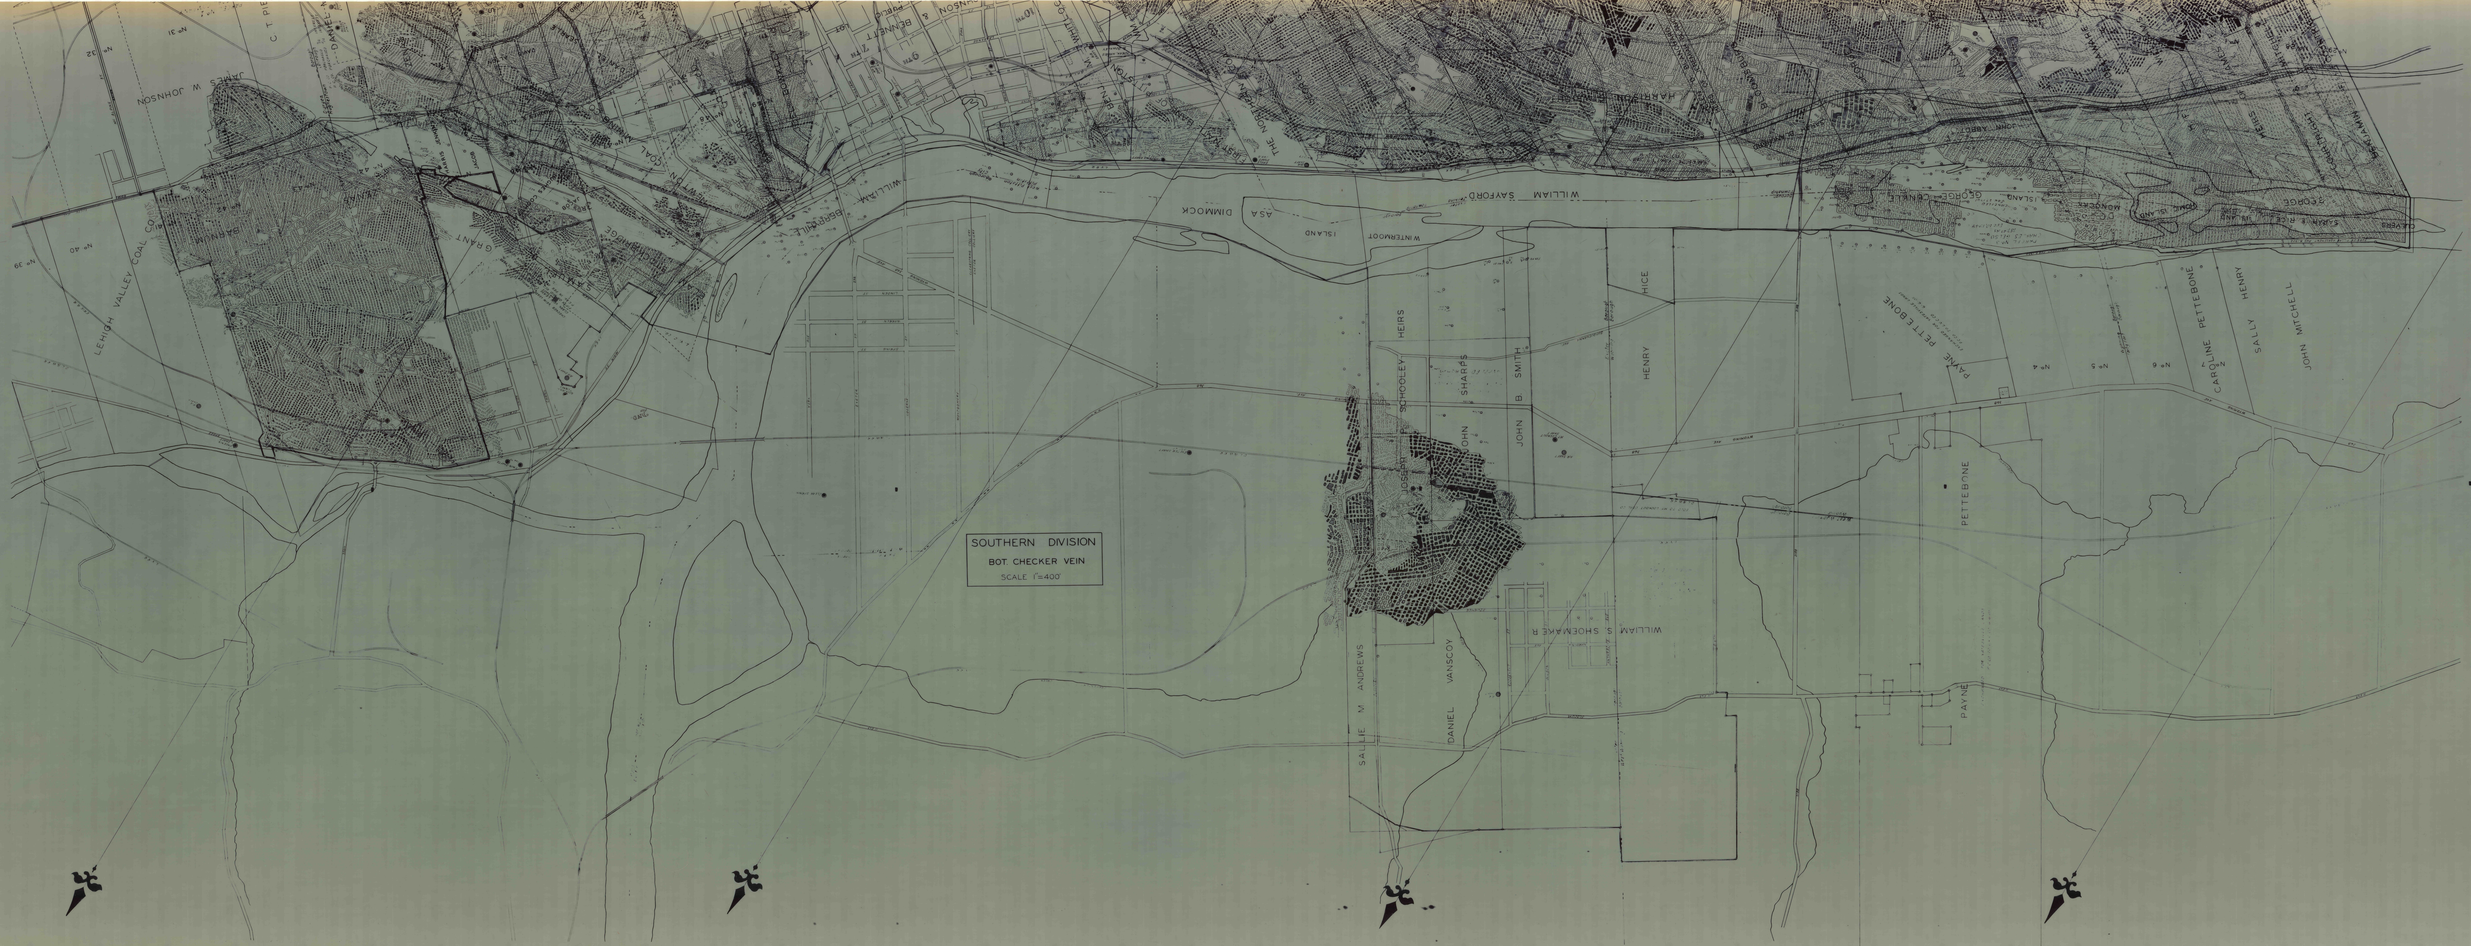
SOUTHERN DIVISION
BOT. CHECKER VEIN
SCALE 1"=400'
LEHIGH VALLEY COAL CO.
JAMES W. JOHNSON
WILLIAM SAYFORD
ASA DIMMOCK
WINTERMOOT ISLAND
HENRY HICE
JOHN B. SMITH
JOHN SHARPS
SCHOOLEY HEIRS
PAYNE PETTEBONE
CAROLINE PETTEBONE
SALLY HENRY
JOHN MITCHELL
PETTEBONE
PAYNE
WILLIAM S. SHOEMAKER
DANIEL VANSCOY
SALLIE M. ANDREWS