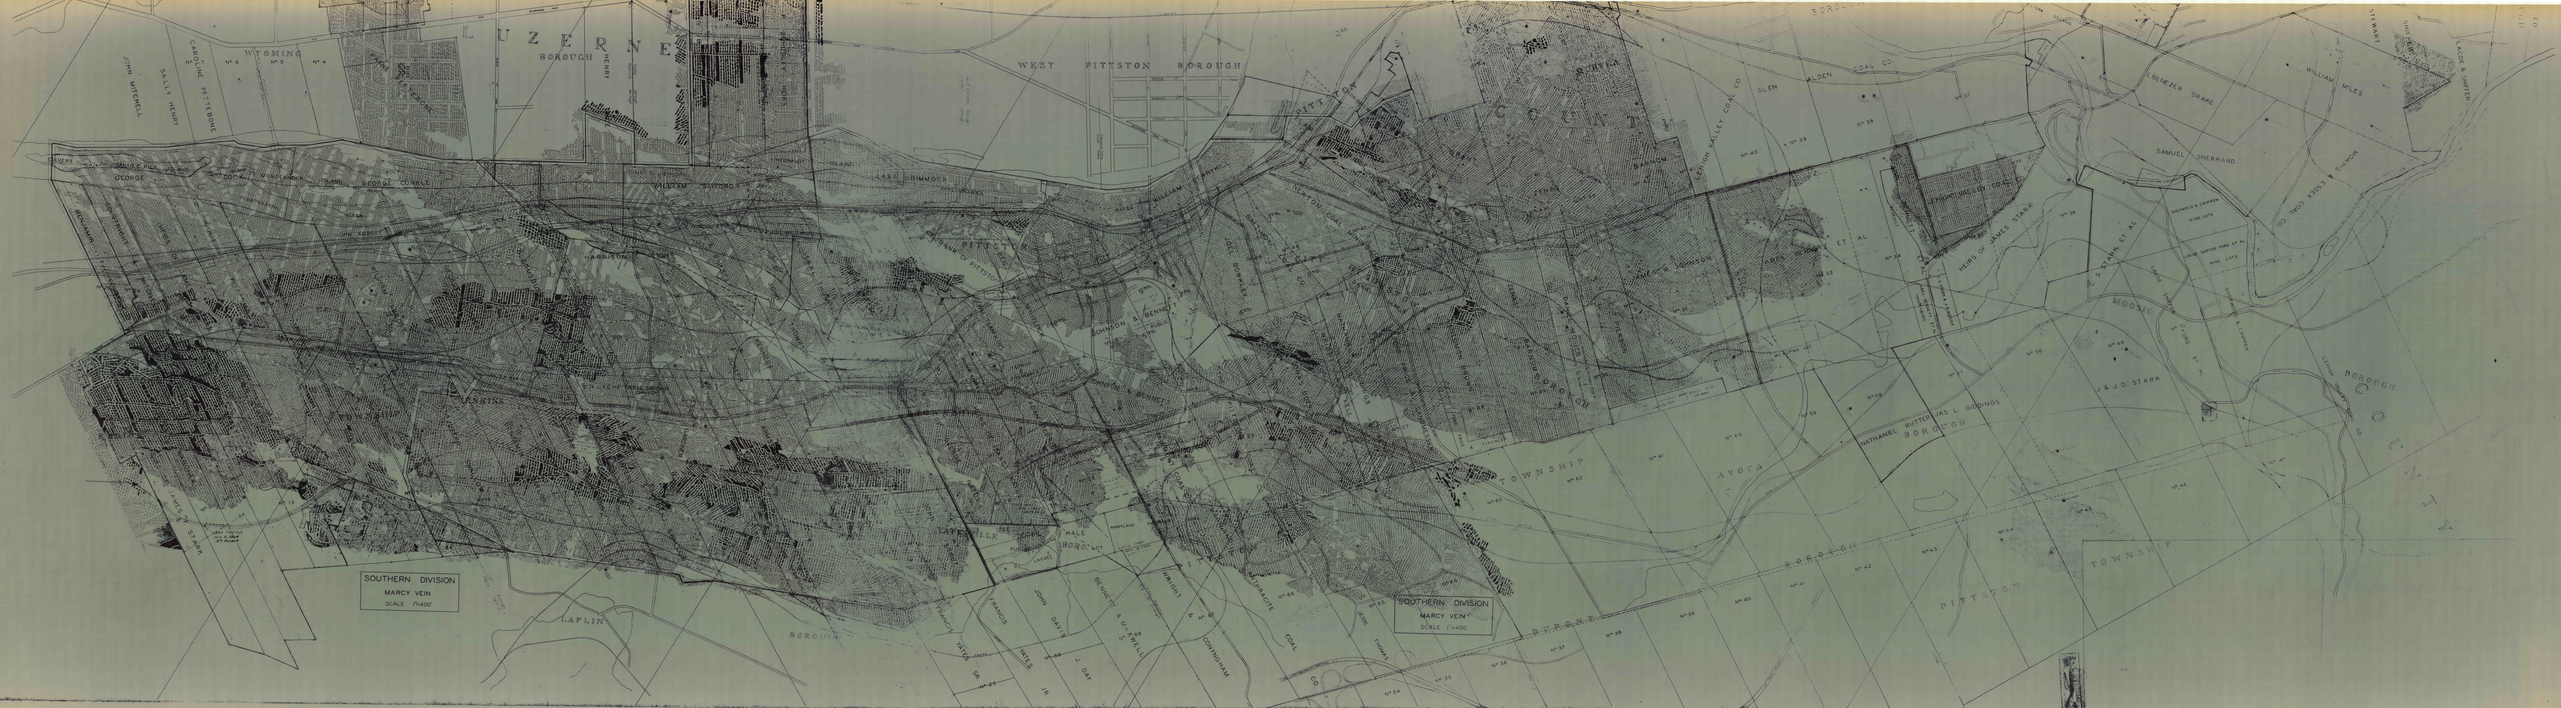
SOUTHERN DIVISION
MARCY VEIN
SCALE 1"=400'
SOUTHERN DIVISION
MARCY VEIN
SCALE 1"=400'
LUZERNE
BOROUGH
WYOMING
WEST PITTSTON BOROUGH
PITTSTON
BOROUGH
PITTSTON
TOWNSHIP
AVOCA
BOROUGH
MOOSIC
MOUNTAINS
LAFLIN
BOROUGH
JENKINS
TOWNSHIP
JOHN MITCHELL
SALLY HENRY
CAROLINE PETTEBONE
HENRY
GEORGE
GEORGE CONKLE
JAMES DIMMICK
JOHN BENNETT
JOHN DAVIS
