



J. B. SMITH TO PENNSYLVANIA COAL CO.
MAR. 31, 1883
P. C. CO. TO DEL. & HUD. CANAL CO.
MAY 23, 1883

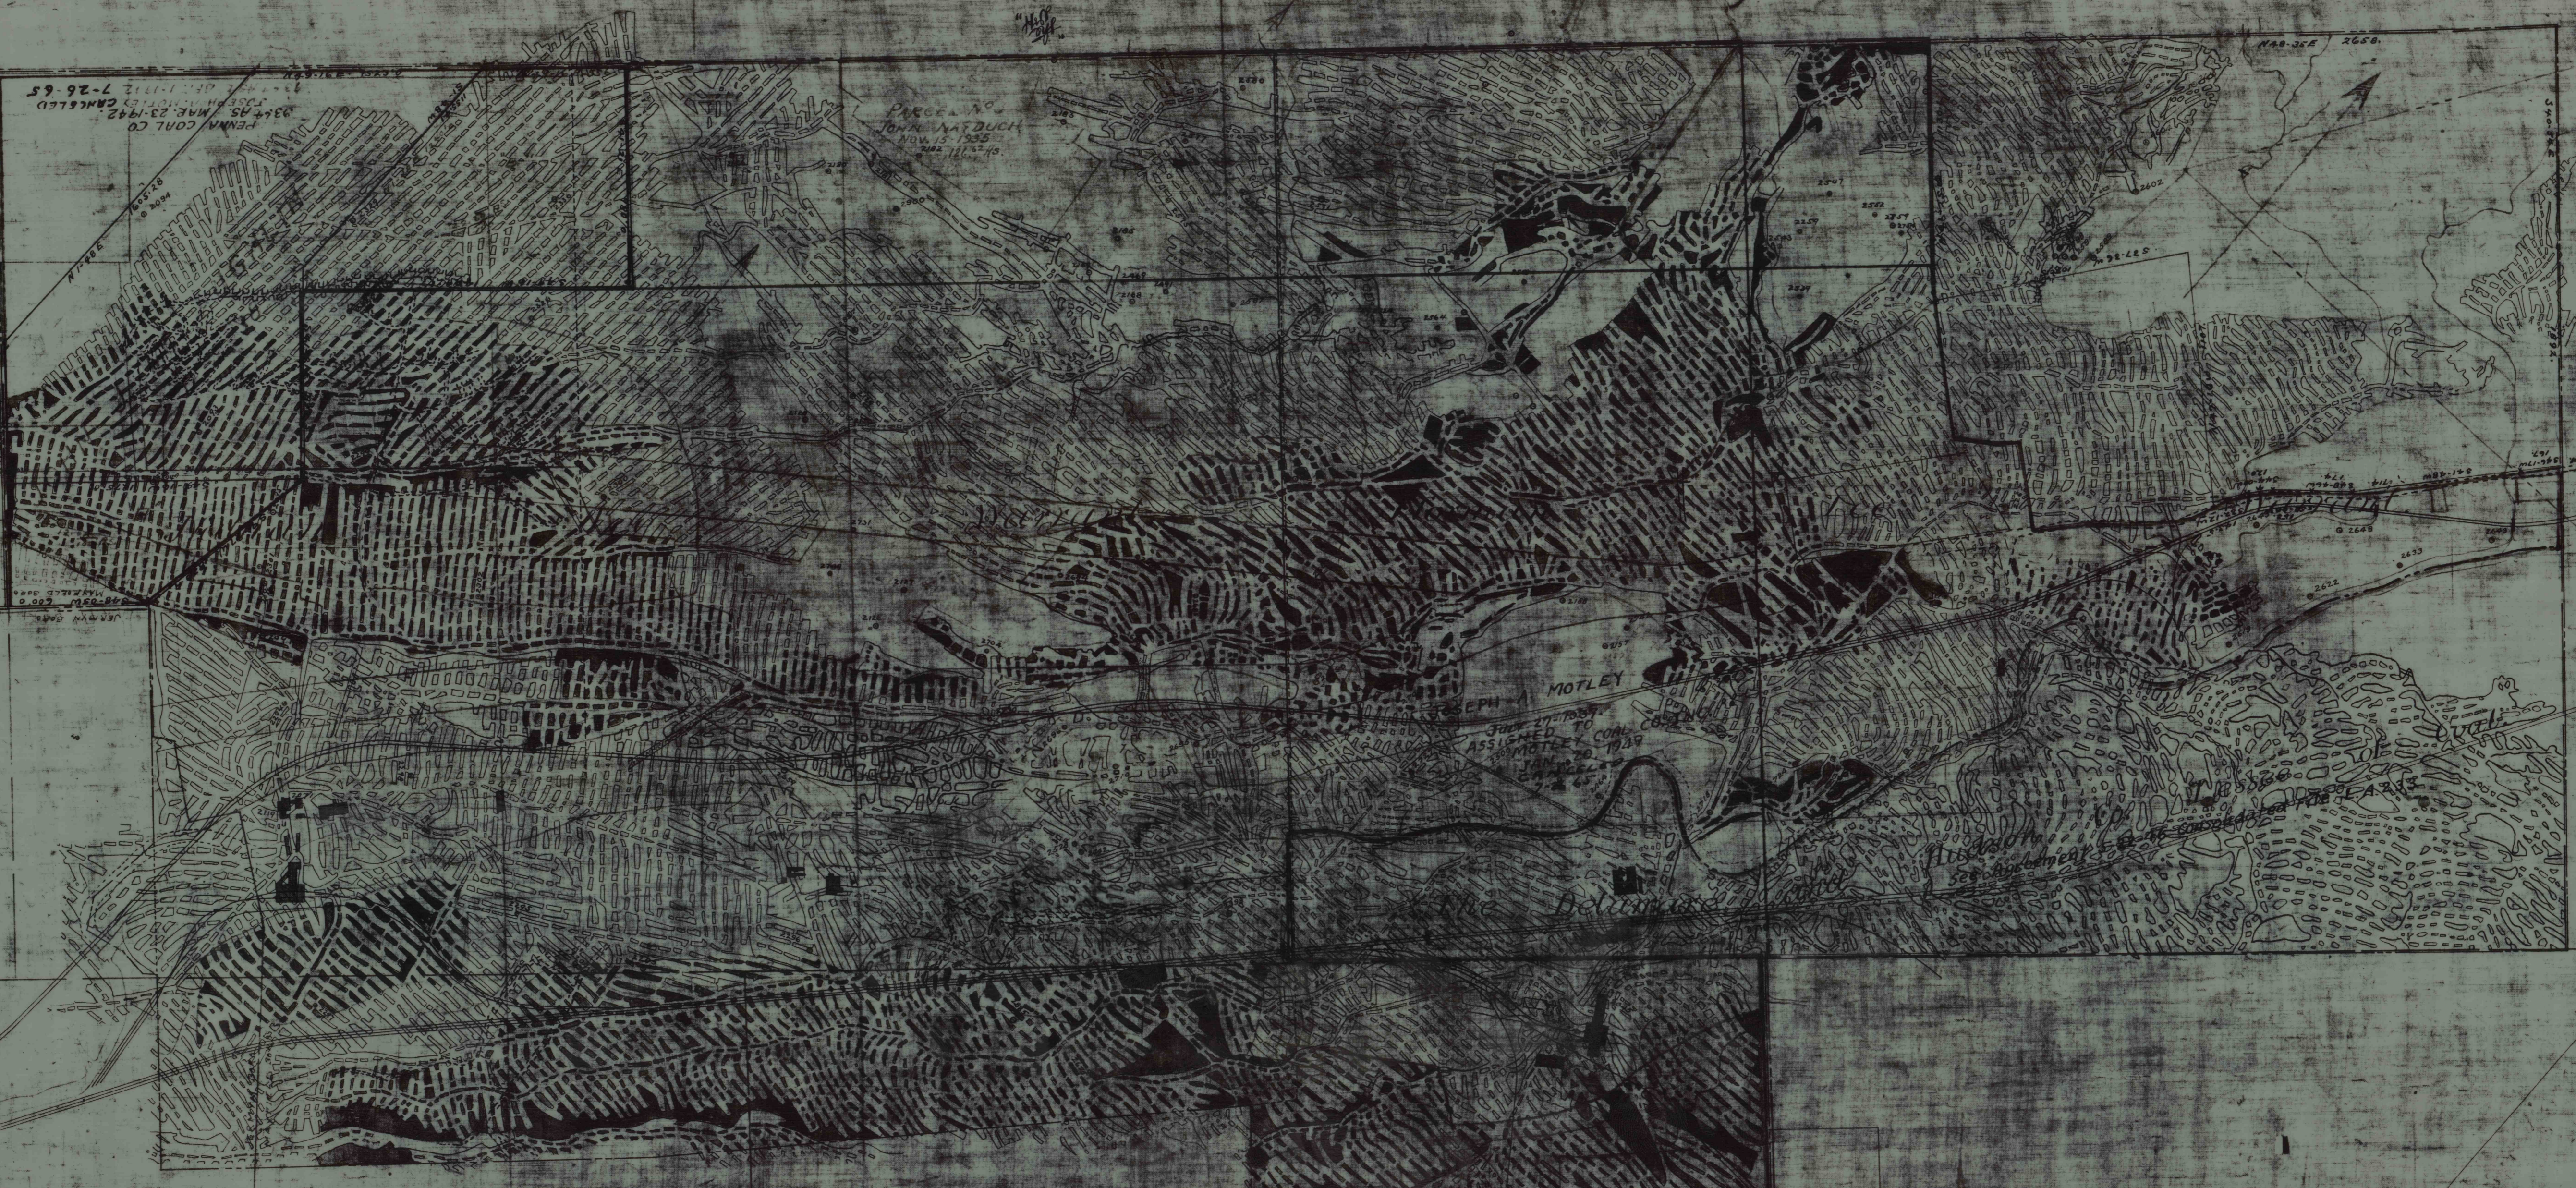

MAYFIELD
CLARK WEIN
SCALE 1"=400'

Peter Rider Warrant James Rider Warrant Samuel Rider Warrant

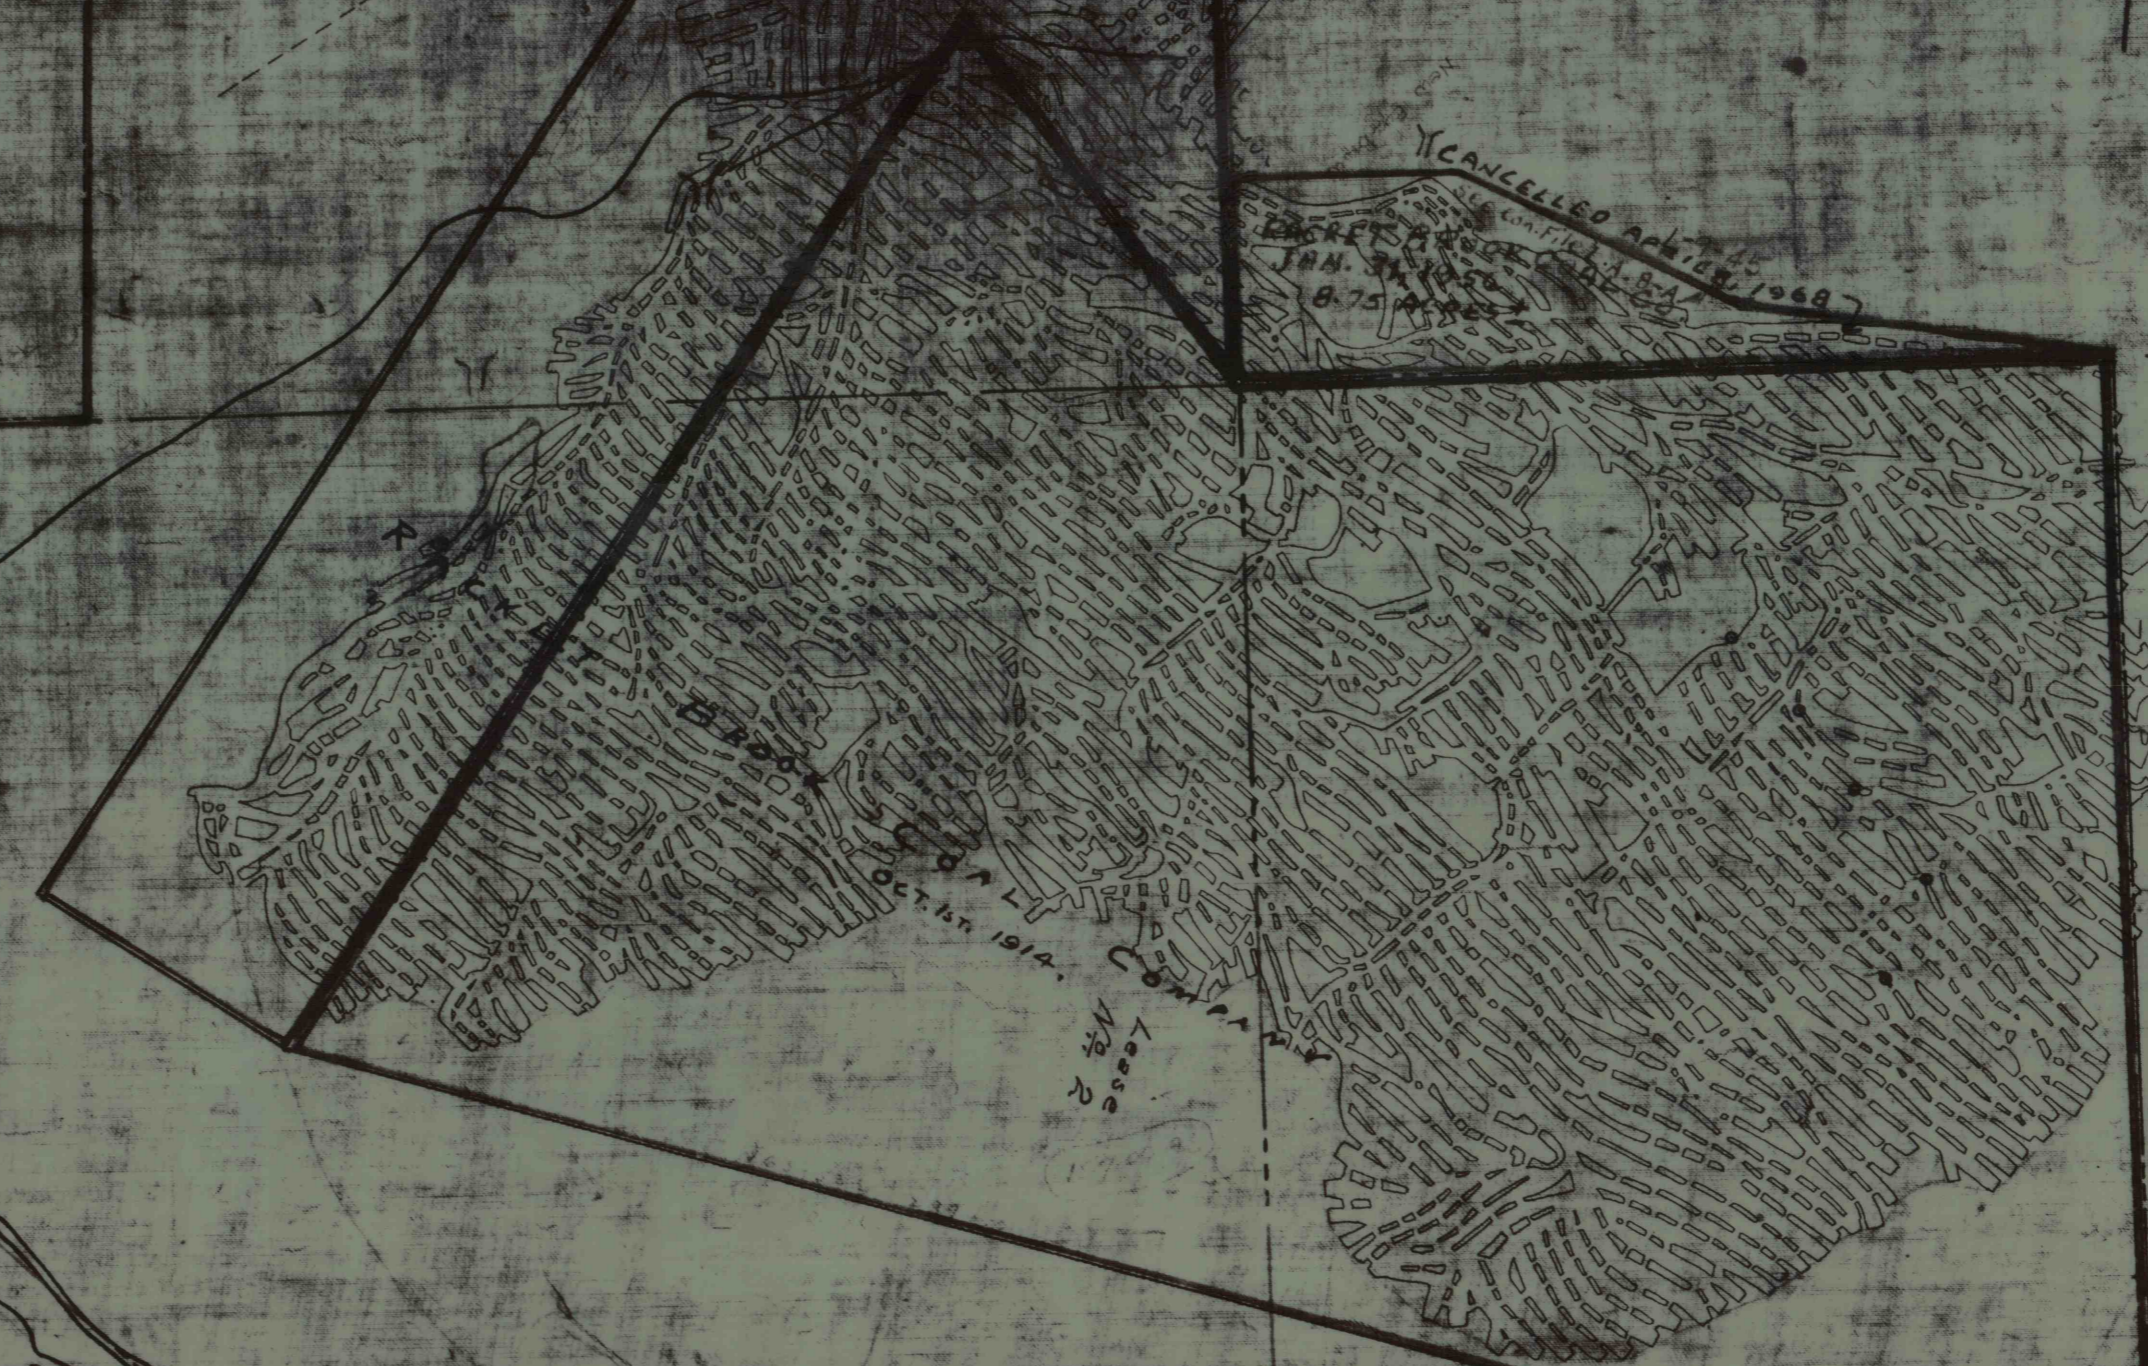

Benjamin Ryan Warrant
RACKET BROOK COAL CO.
JULY 15, 1882
5167 MS 2

John Clark Warrant Elizabeth Clark Warrant