


LACKAWANNA

CO

SUSQUEHANNA

WAYNE

CO.

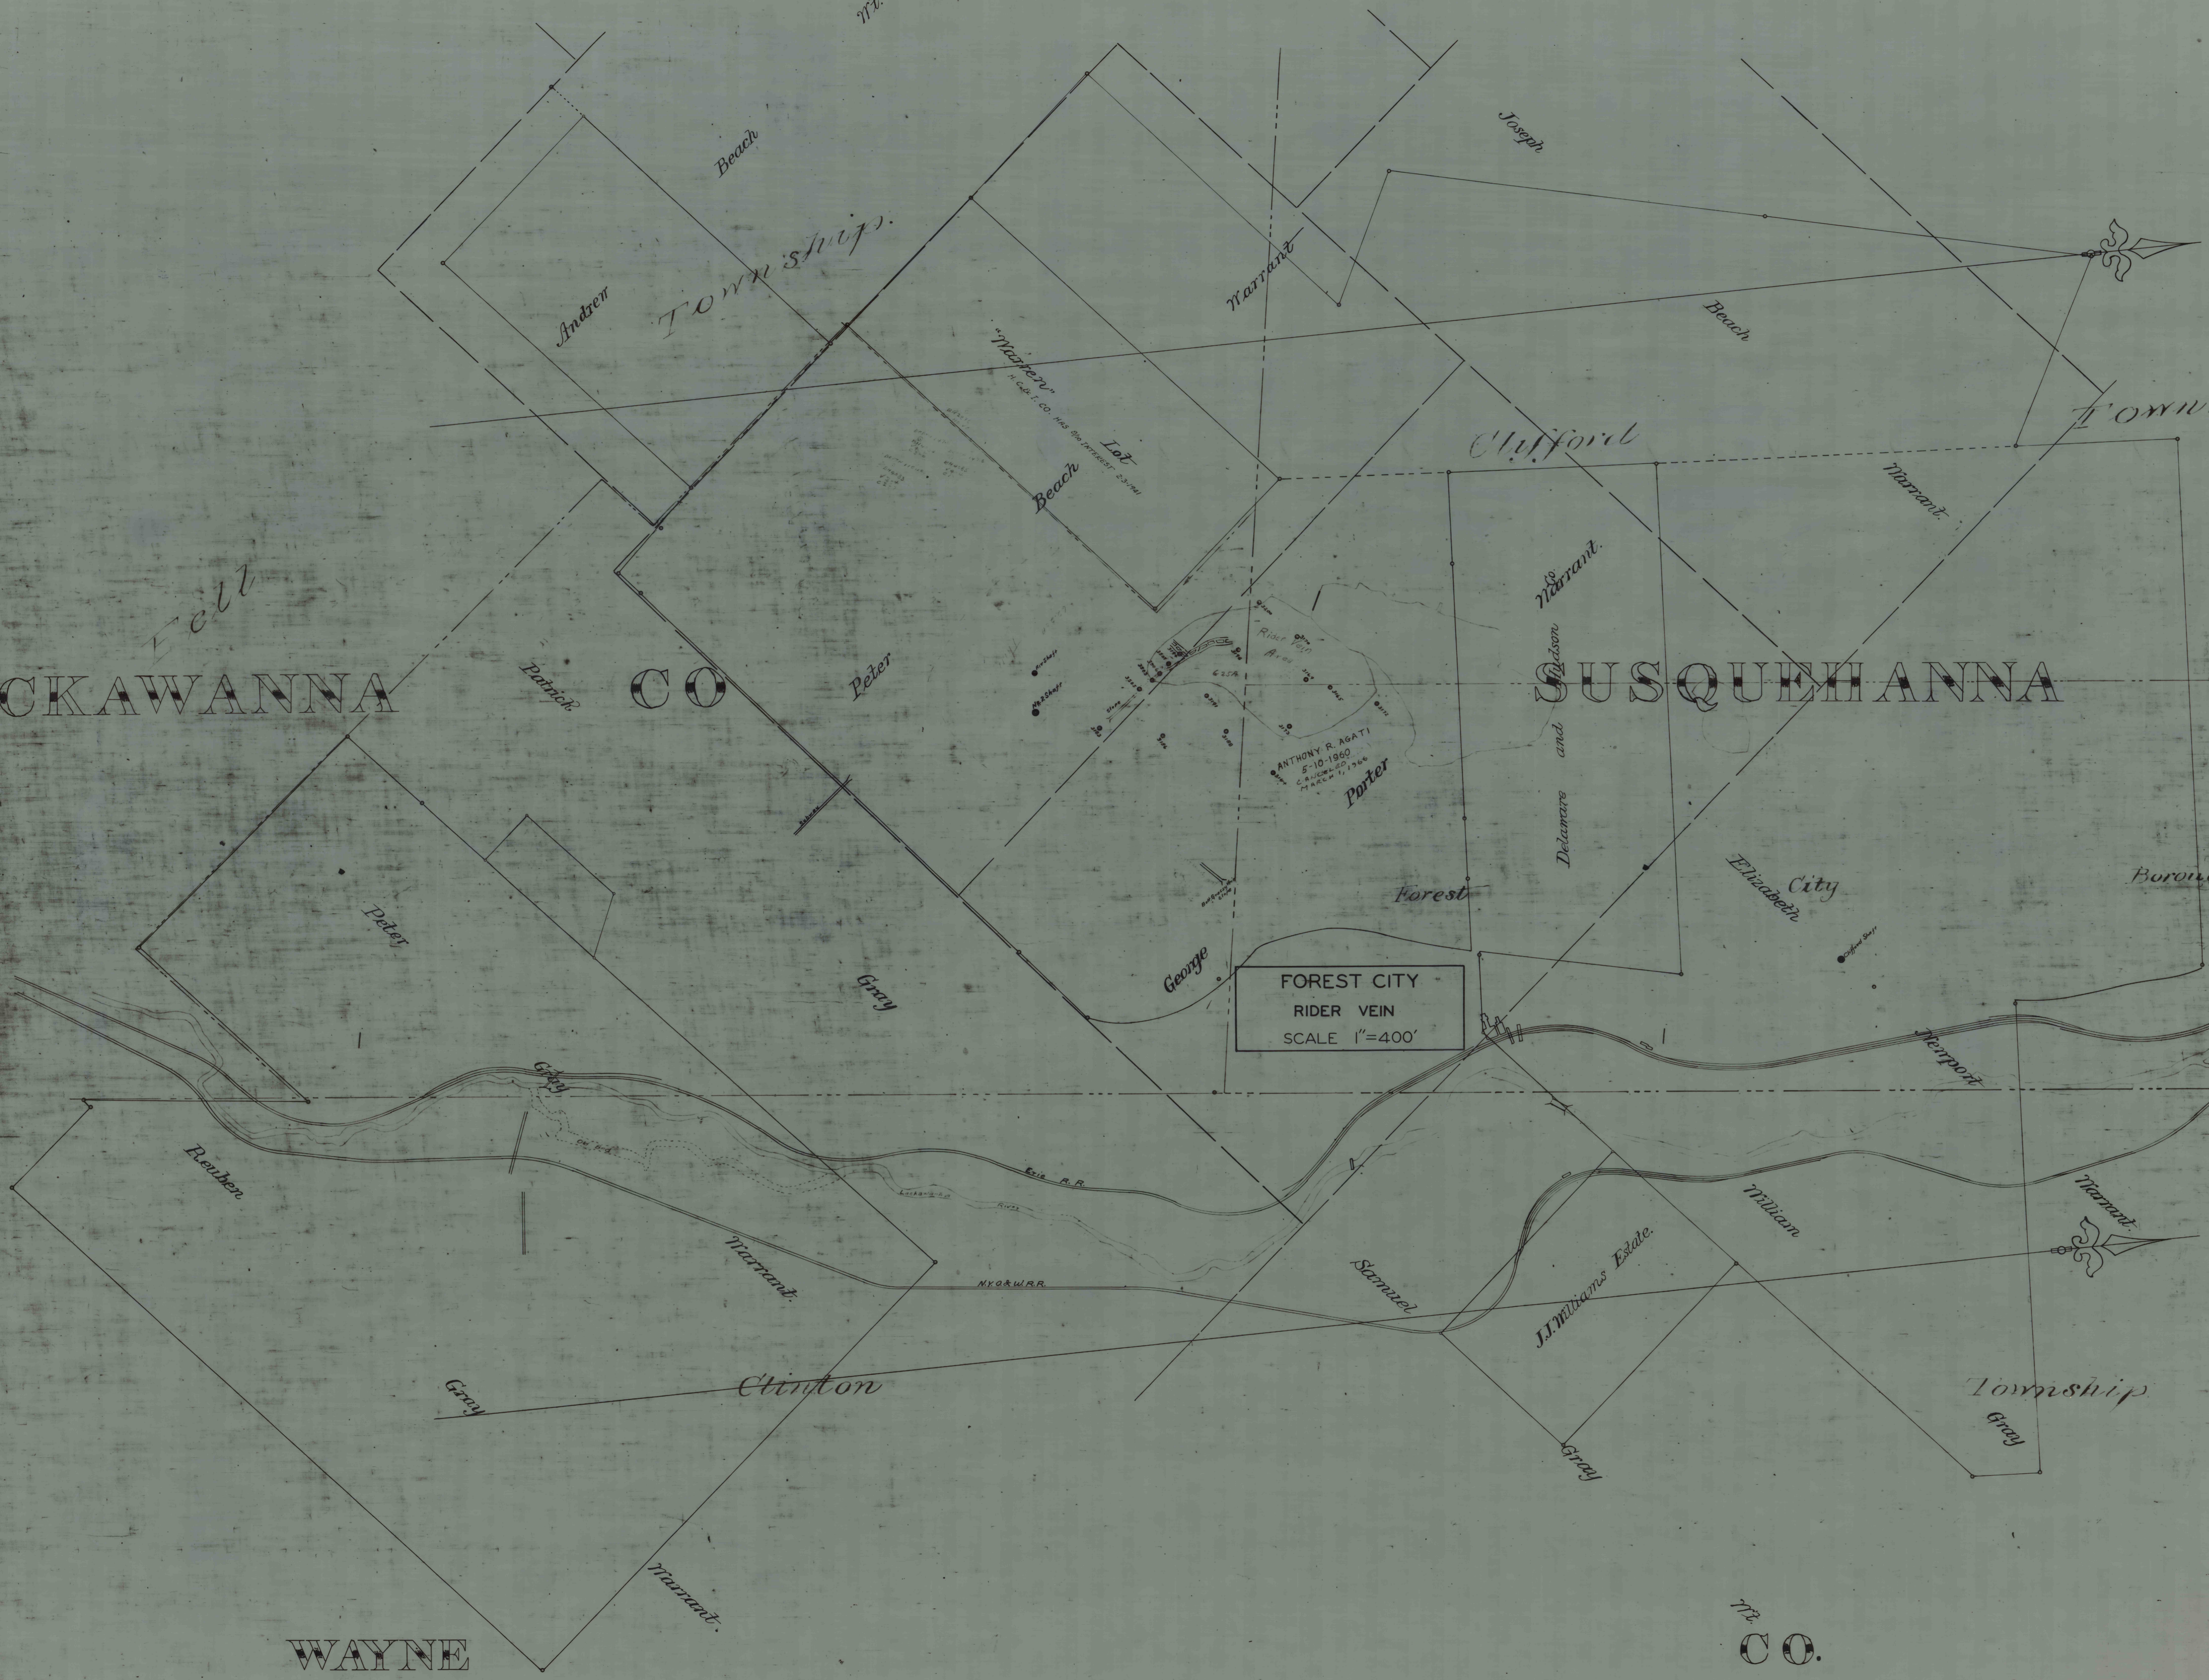

FOREST CITY
 RIDER VEIN
 SCALE 1"=400'

ANTHONY R. AGATI
 5-10-1960
 C. 41662-20 1366

Andren Township

Clifford


Felt

Patrick

Peter

Marrant

Delaware and Gibson

Elizabeth City

Borough

Peter

Gray

George

Forest

Harport

Reuben

Marrant

NY & W.V. R.R.

Stamuel

J.J. Williams Estate


Marrant

Gray

Clinton

Township

Marrant

Gray

M