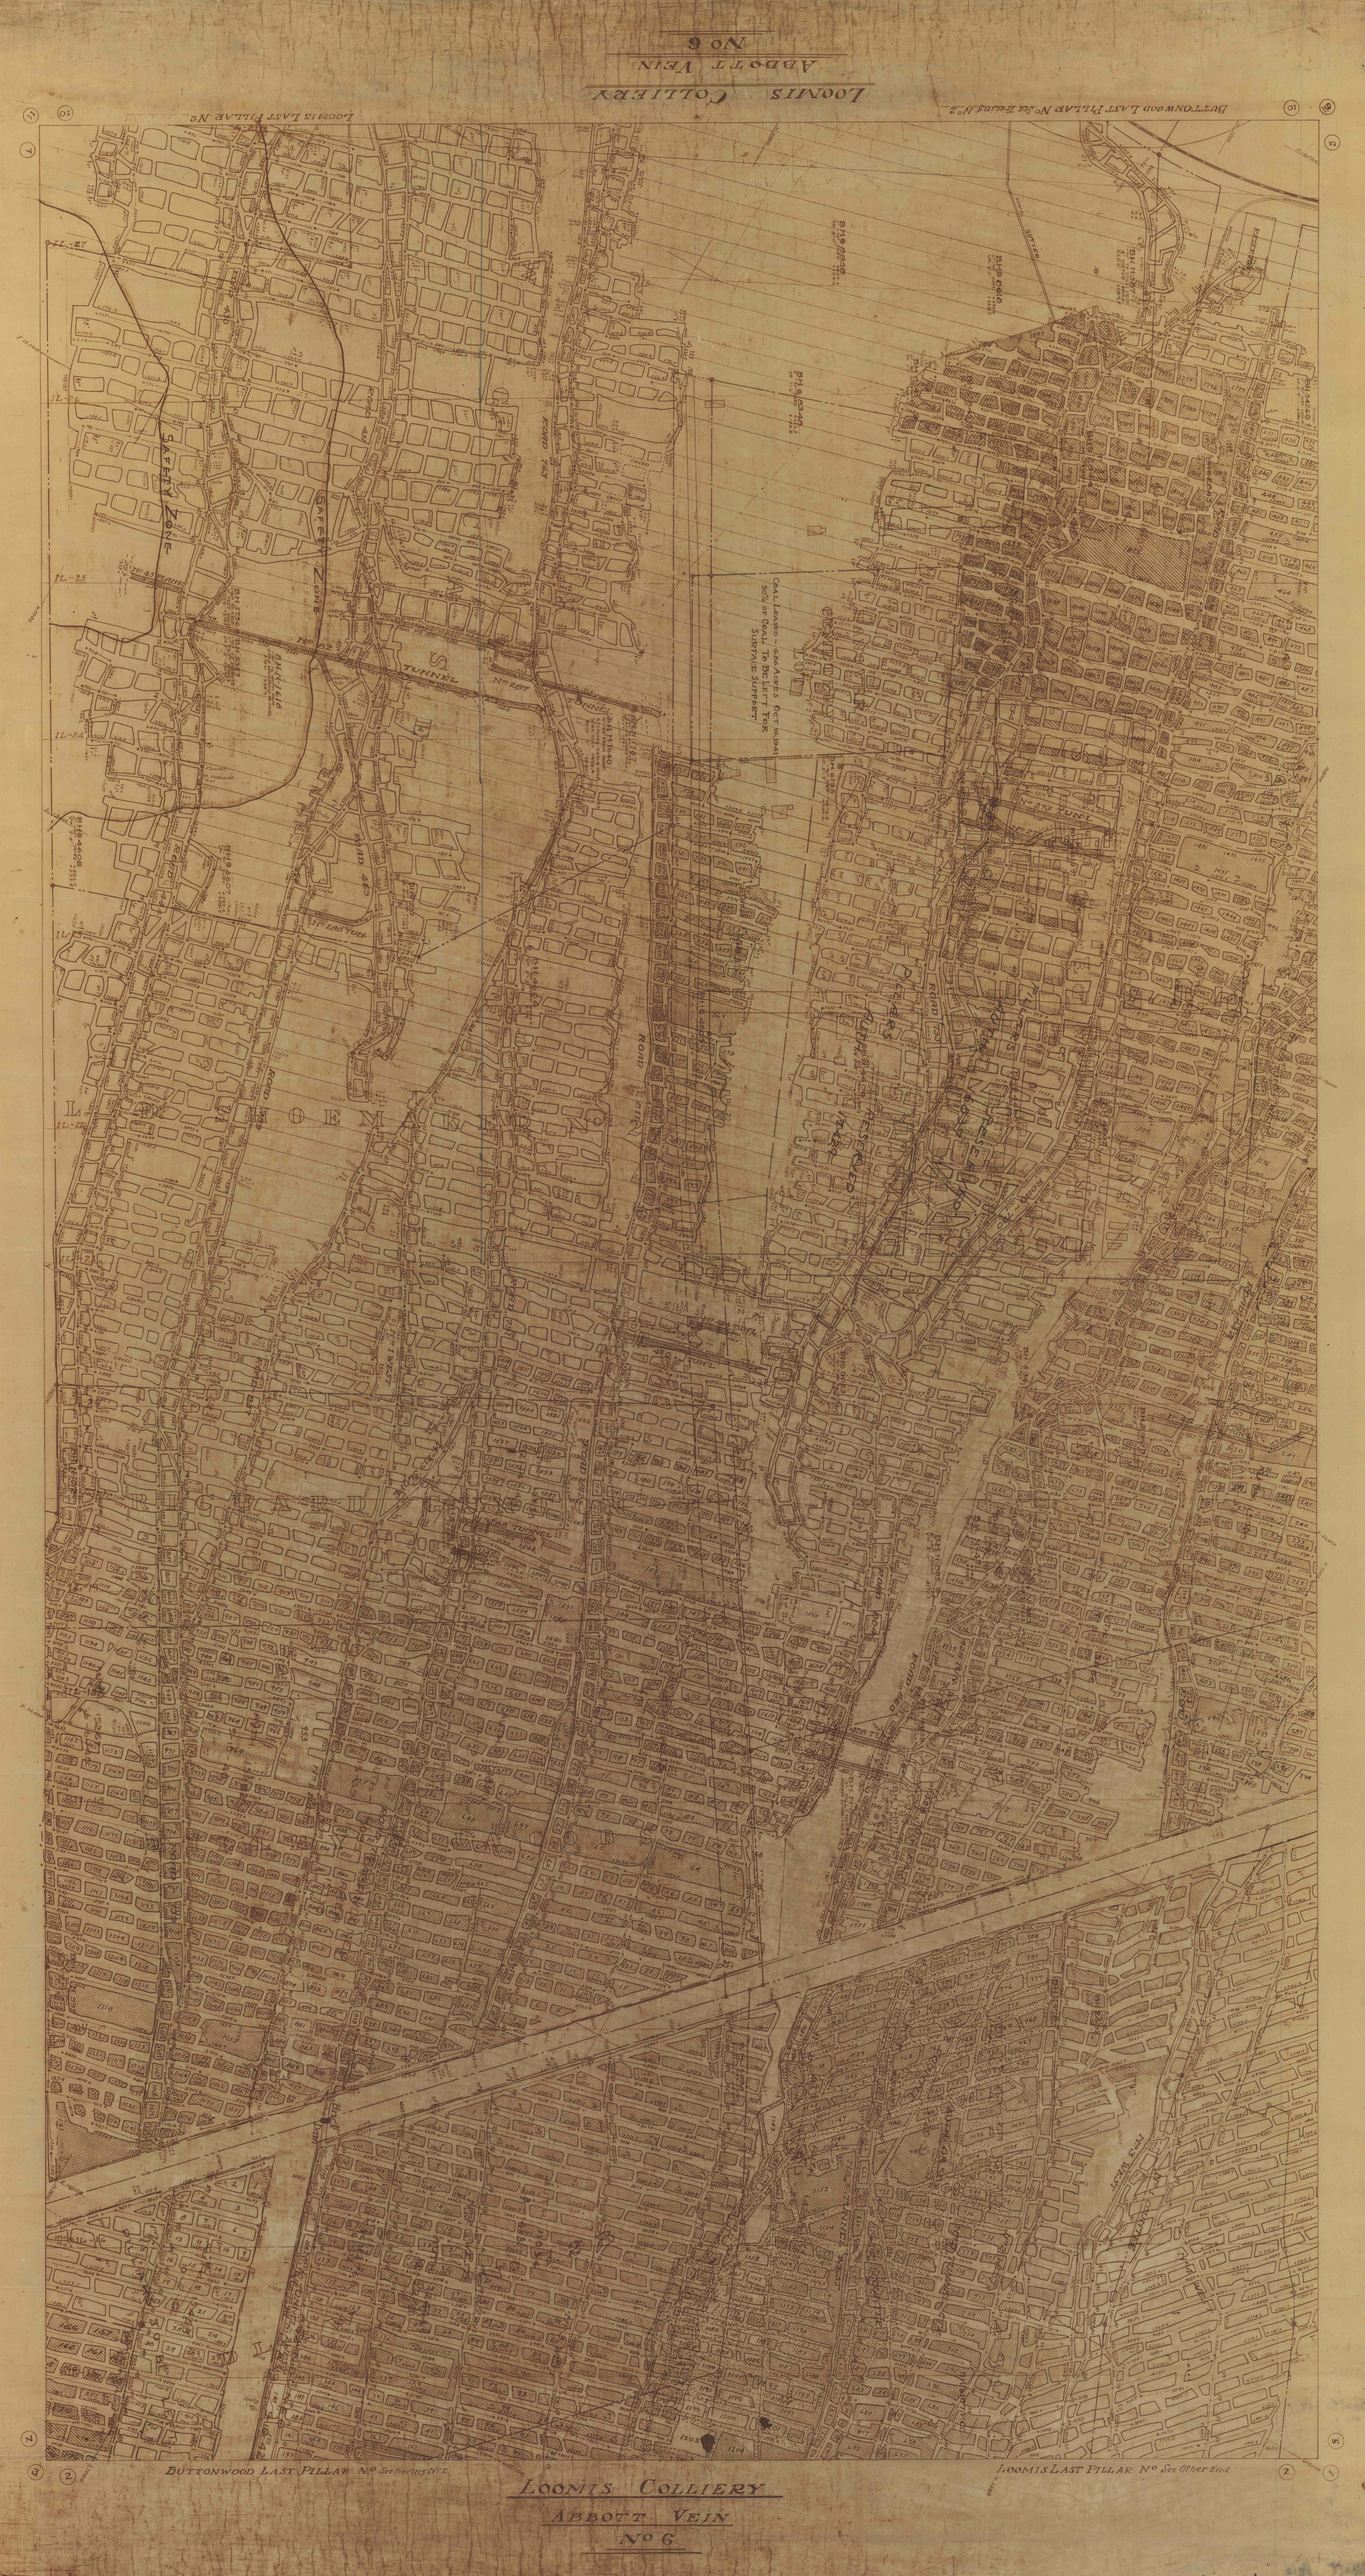
LOOMIS COLLIERY
ABBOTT VEIN
No 6
LOOMIS LAST PILLAR No
BUTTONWOOD LAST PILLAR No See Facing No 2
SAFETY ZONE
TUNNEL
ROAD
BUTTONWOOD LAST PILLAR No See Facing No 2
LOOMIS LAST PILLAR No See Other End
LOOMIS COLLIERY
ABBOTT VEIN
No 6