


LOOMIS COLLIERY
BALTIMORE VEIN
NO 6

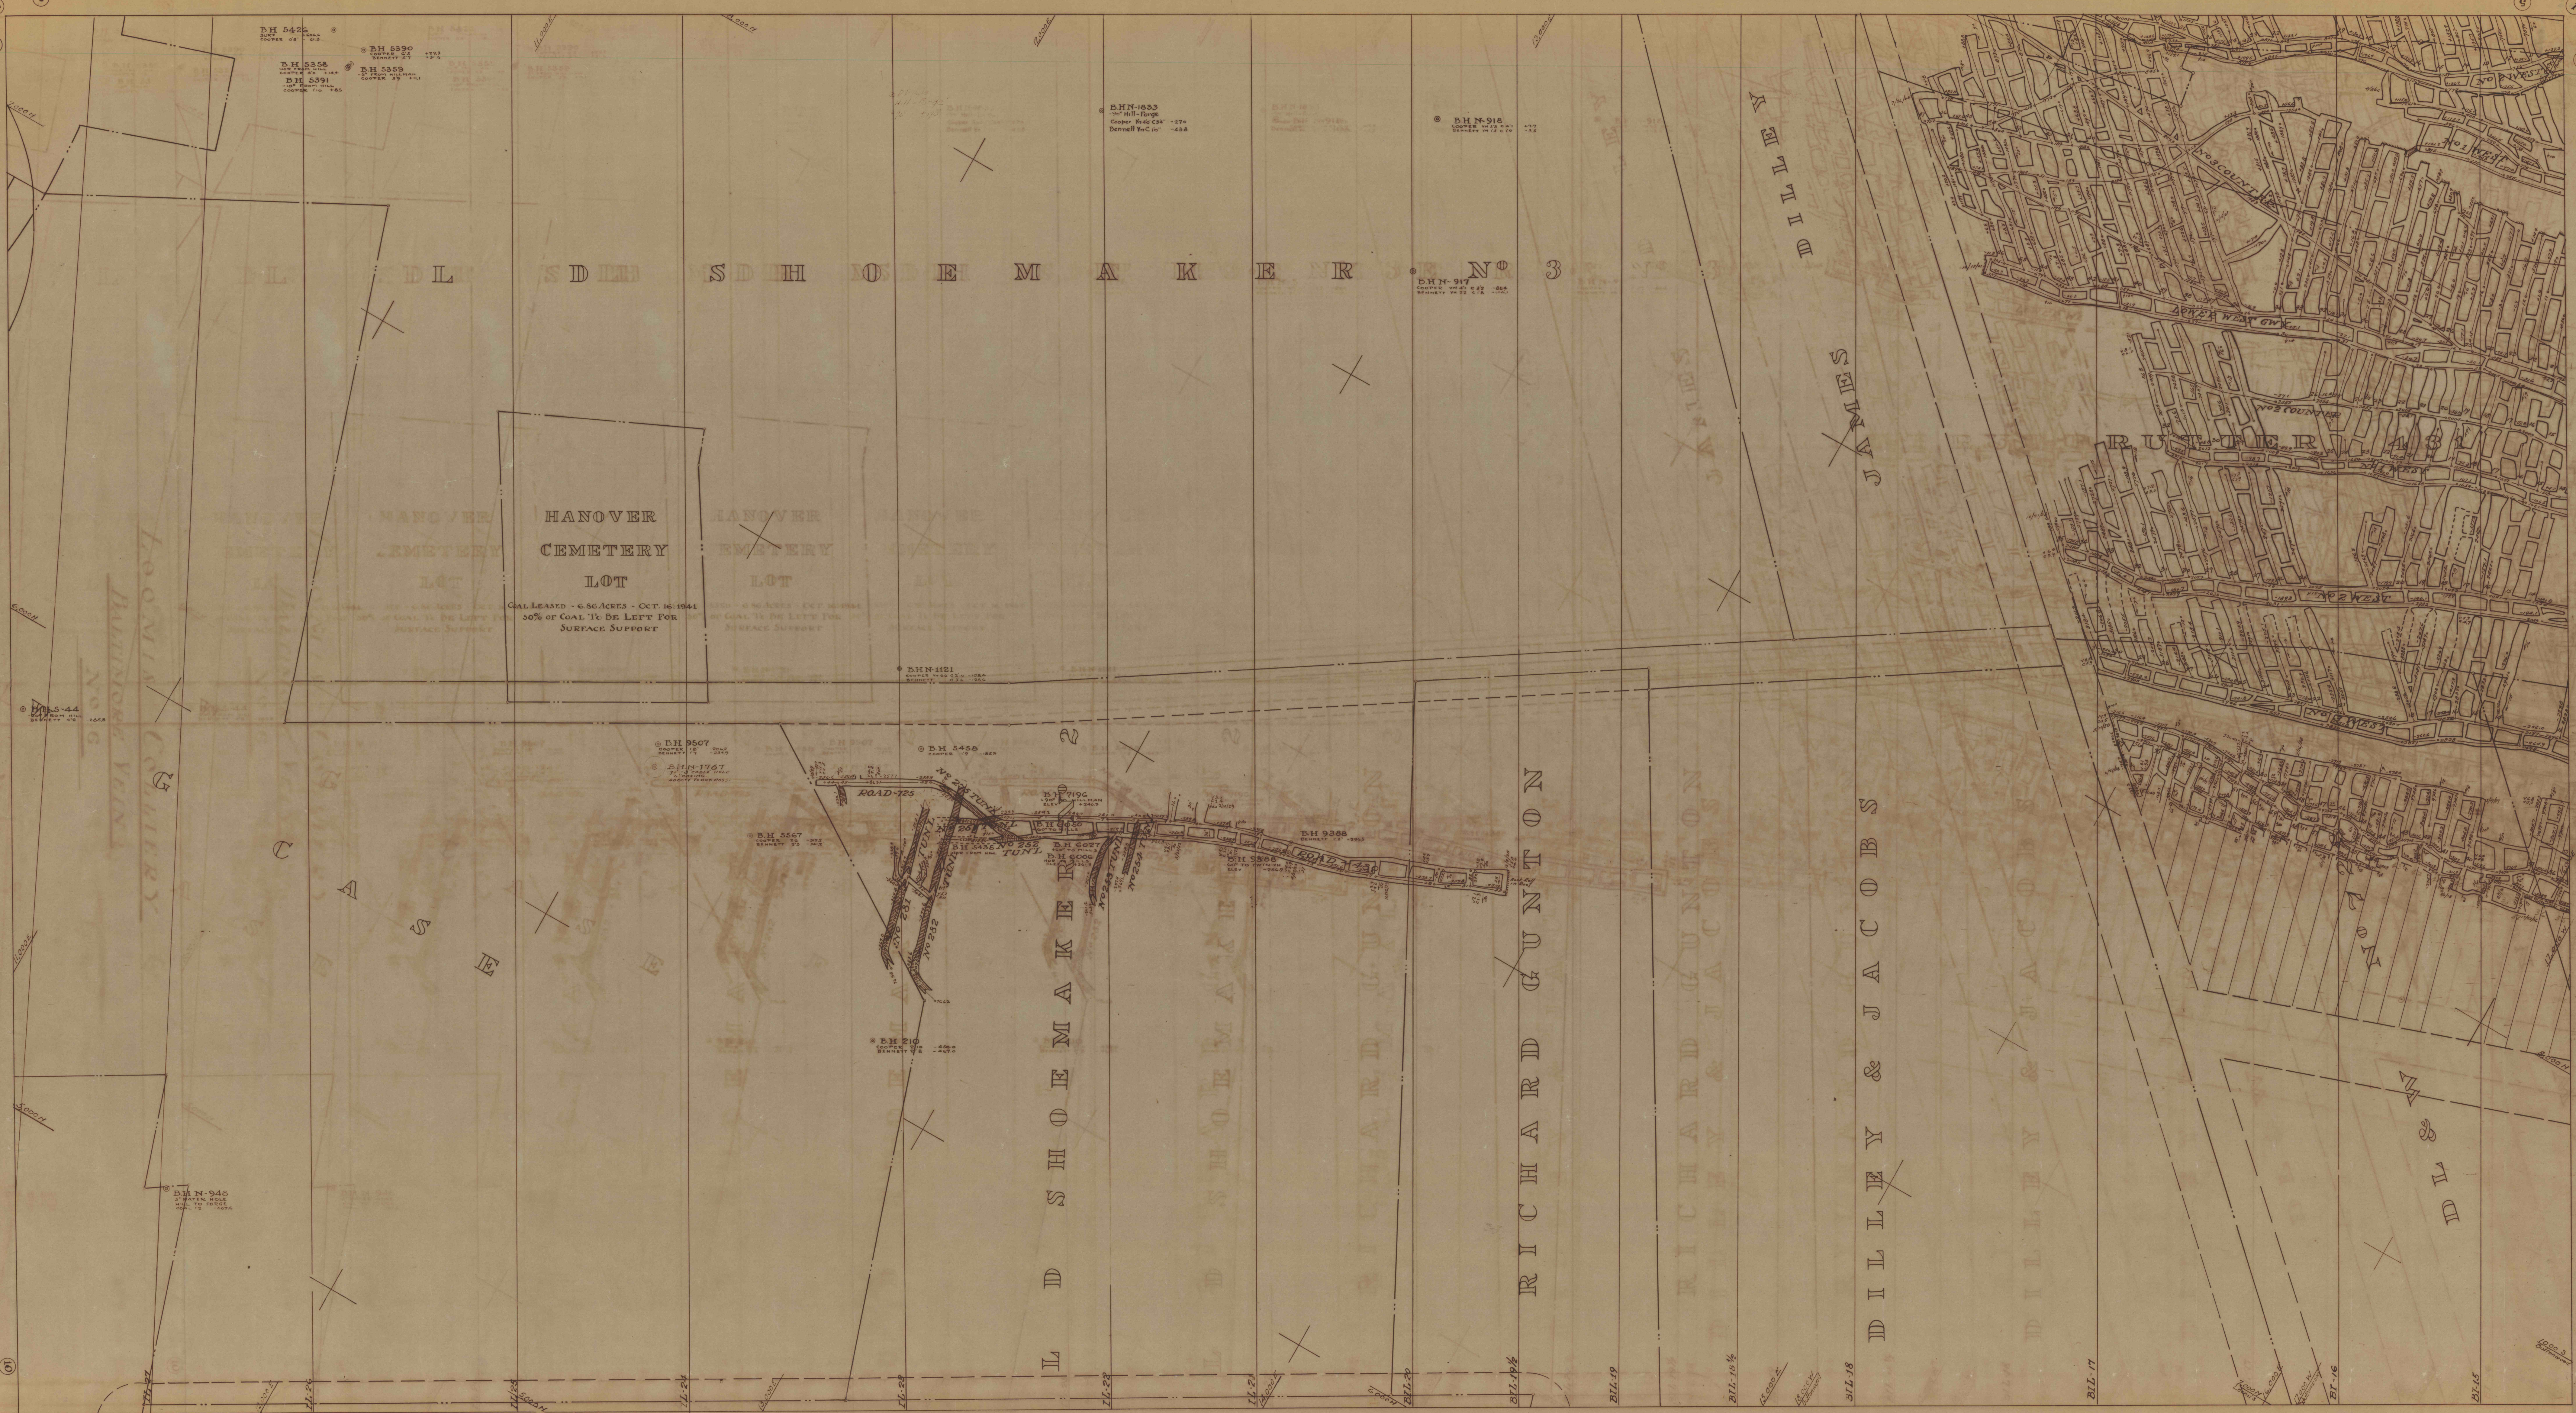

LOOMIS COLLIERY
BALTIMORE VEIN
NO 6