

LOOMIS COLLIERY
GEORGE VEIN
No 6

LOOMIS COLLIERY
GEORGE VEIN
No 6

D S H O E M A K M E R

D I L L E Y J A M I E S

D I L L E Y J A M I E S

R U T T E R U 4 3 1

L D S H O E M A K M E R N O 2

R I C H A R D C U N T O N

D I L L E Y & J A C O B S


HANOVER
CEMETERY
LOT
COAL LEASED - 6.86 ACRE - OCT. 16, 1941
50% OF COAL TO BE LEFT FOR
SURFACE SUPPORT

SAFETY ZONE

SAFETY ZONE

D N 1640
No 287 TUNNEL

D N 2000

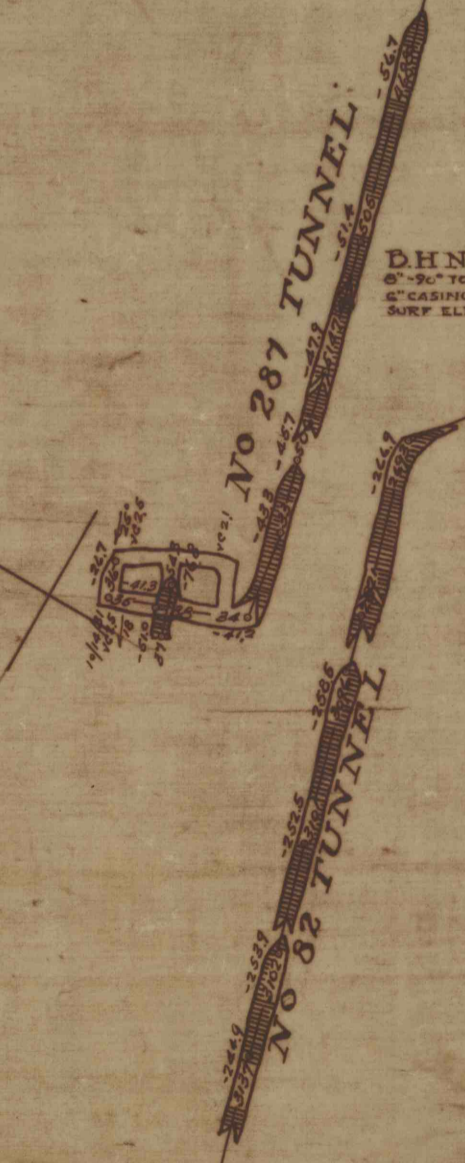

BH 5426
BH 2843
BH 2844
BH 6197
BH 6196
BH 4602
BH 4605
BH 4604
BH 9023
BH 4605
BH 4606
BH 210
BH 3124
BH 5756
BH 4607
BH 4608

BH 2849
BH 2850
BH 2852

