


BUTTONWOOD COLLIERY No 3 VEIN  
LOOMIS COLLIERY No 6 VEIN

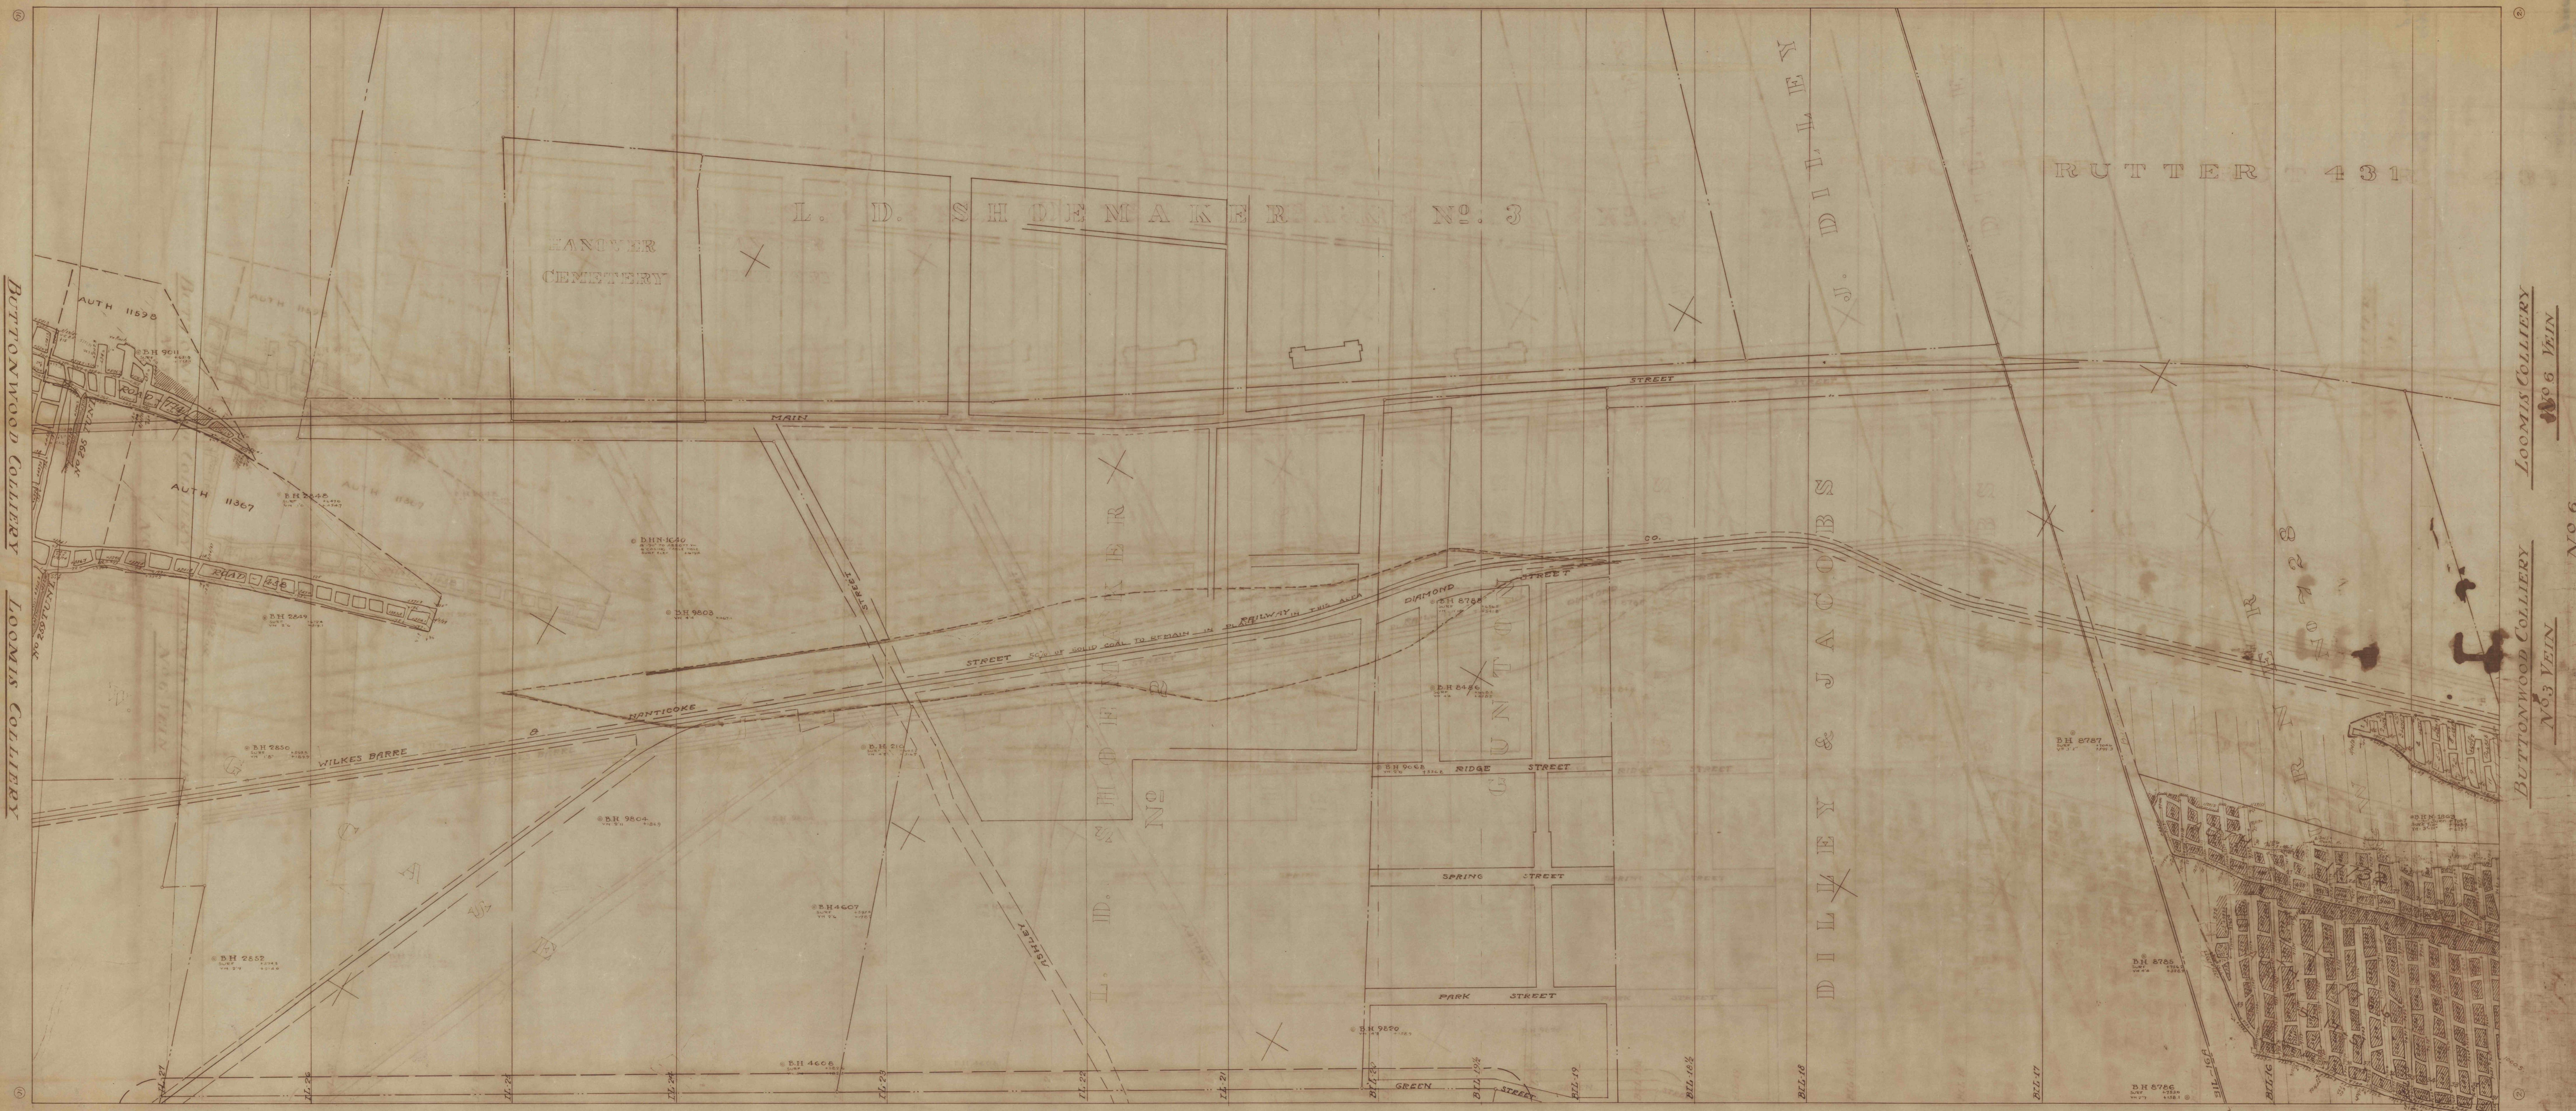

RUTTER 431

L. D. SHODENAKER No. 3

HANOVER CEMETERY

DILLEY & JACOBS

ASHLEY

BUTTONWOOD COLLIERY No 3 VEIN  
LOOMIS COLLIERY No 6 VEIN