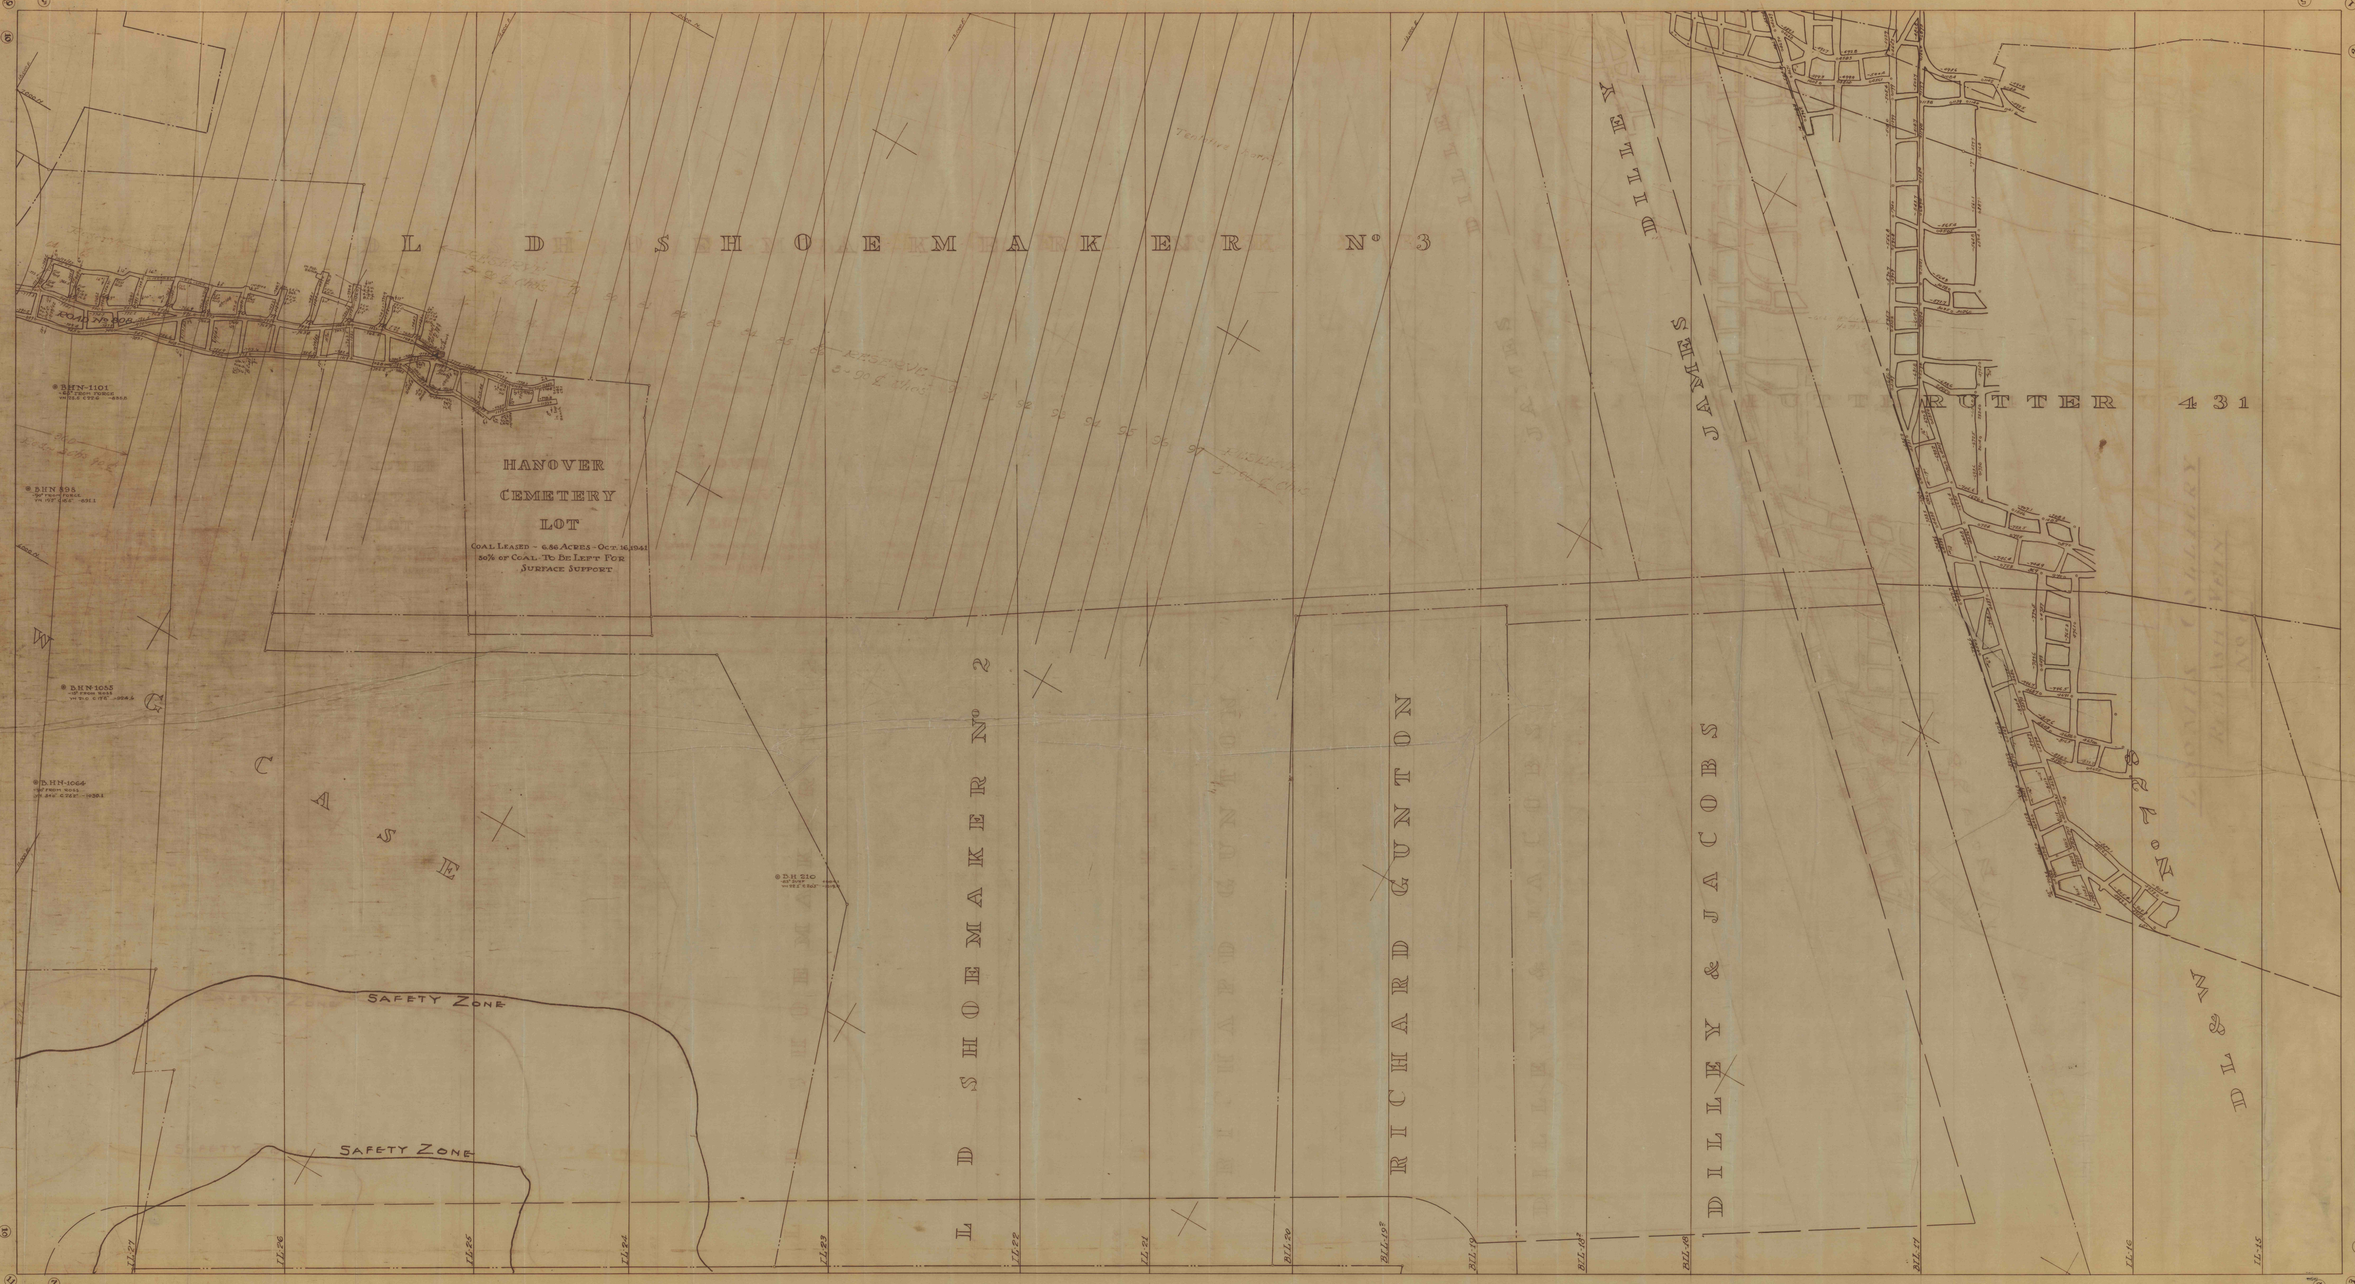

LOOMIS COLLIERY
RED ASH VEIN
No 6

LOOMIS COLLIERY
RED ASH VEIN
No 6