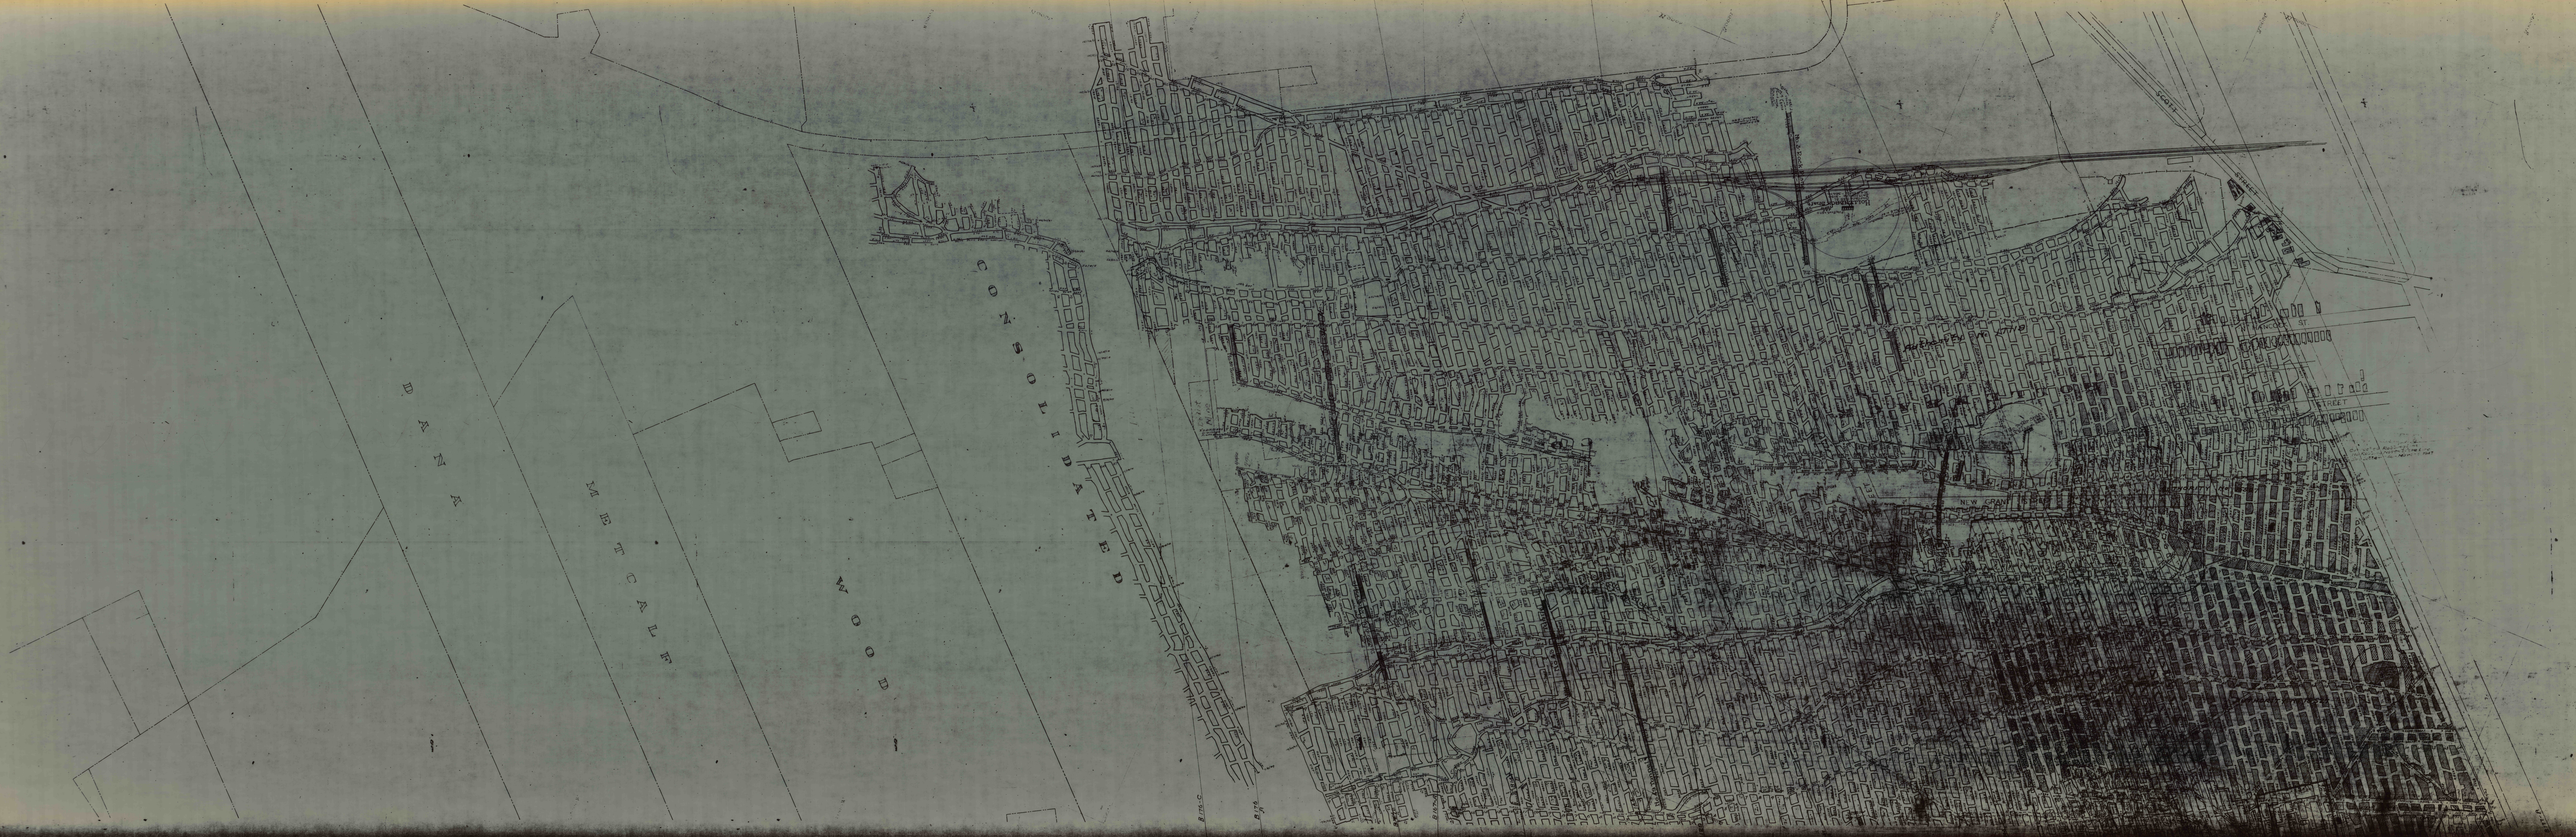
DANA
METCALF
WOOD
CONSOLIDATED
NEW CRANE
STREET