


Halleback No. 2 Shaft

R. RAEDER

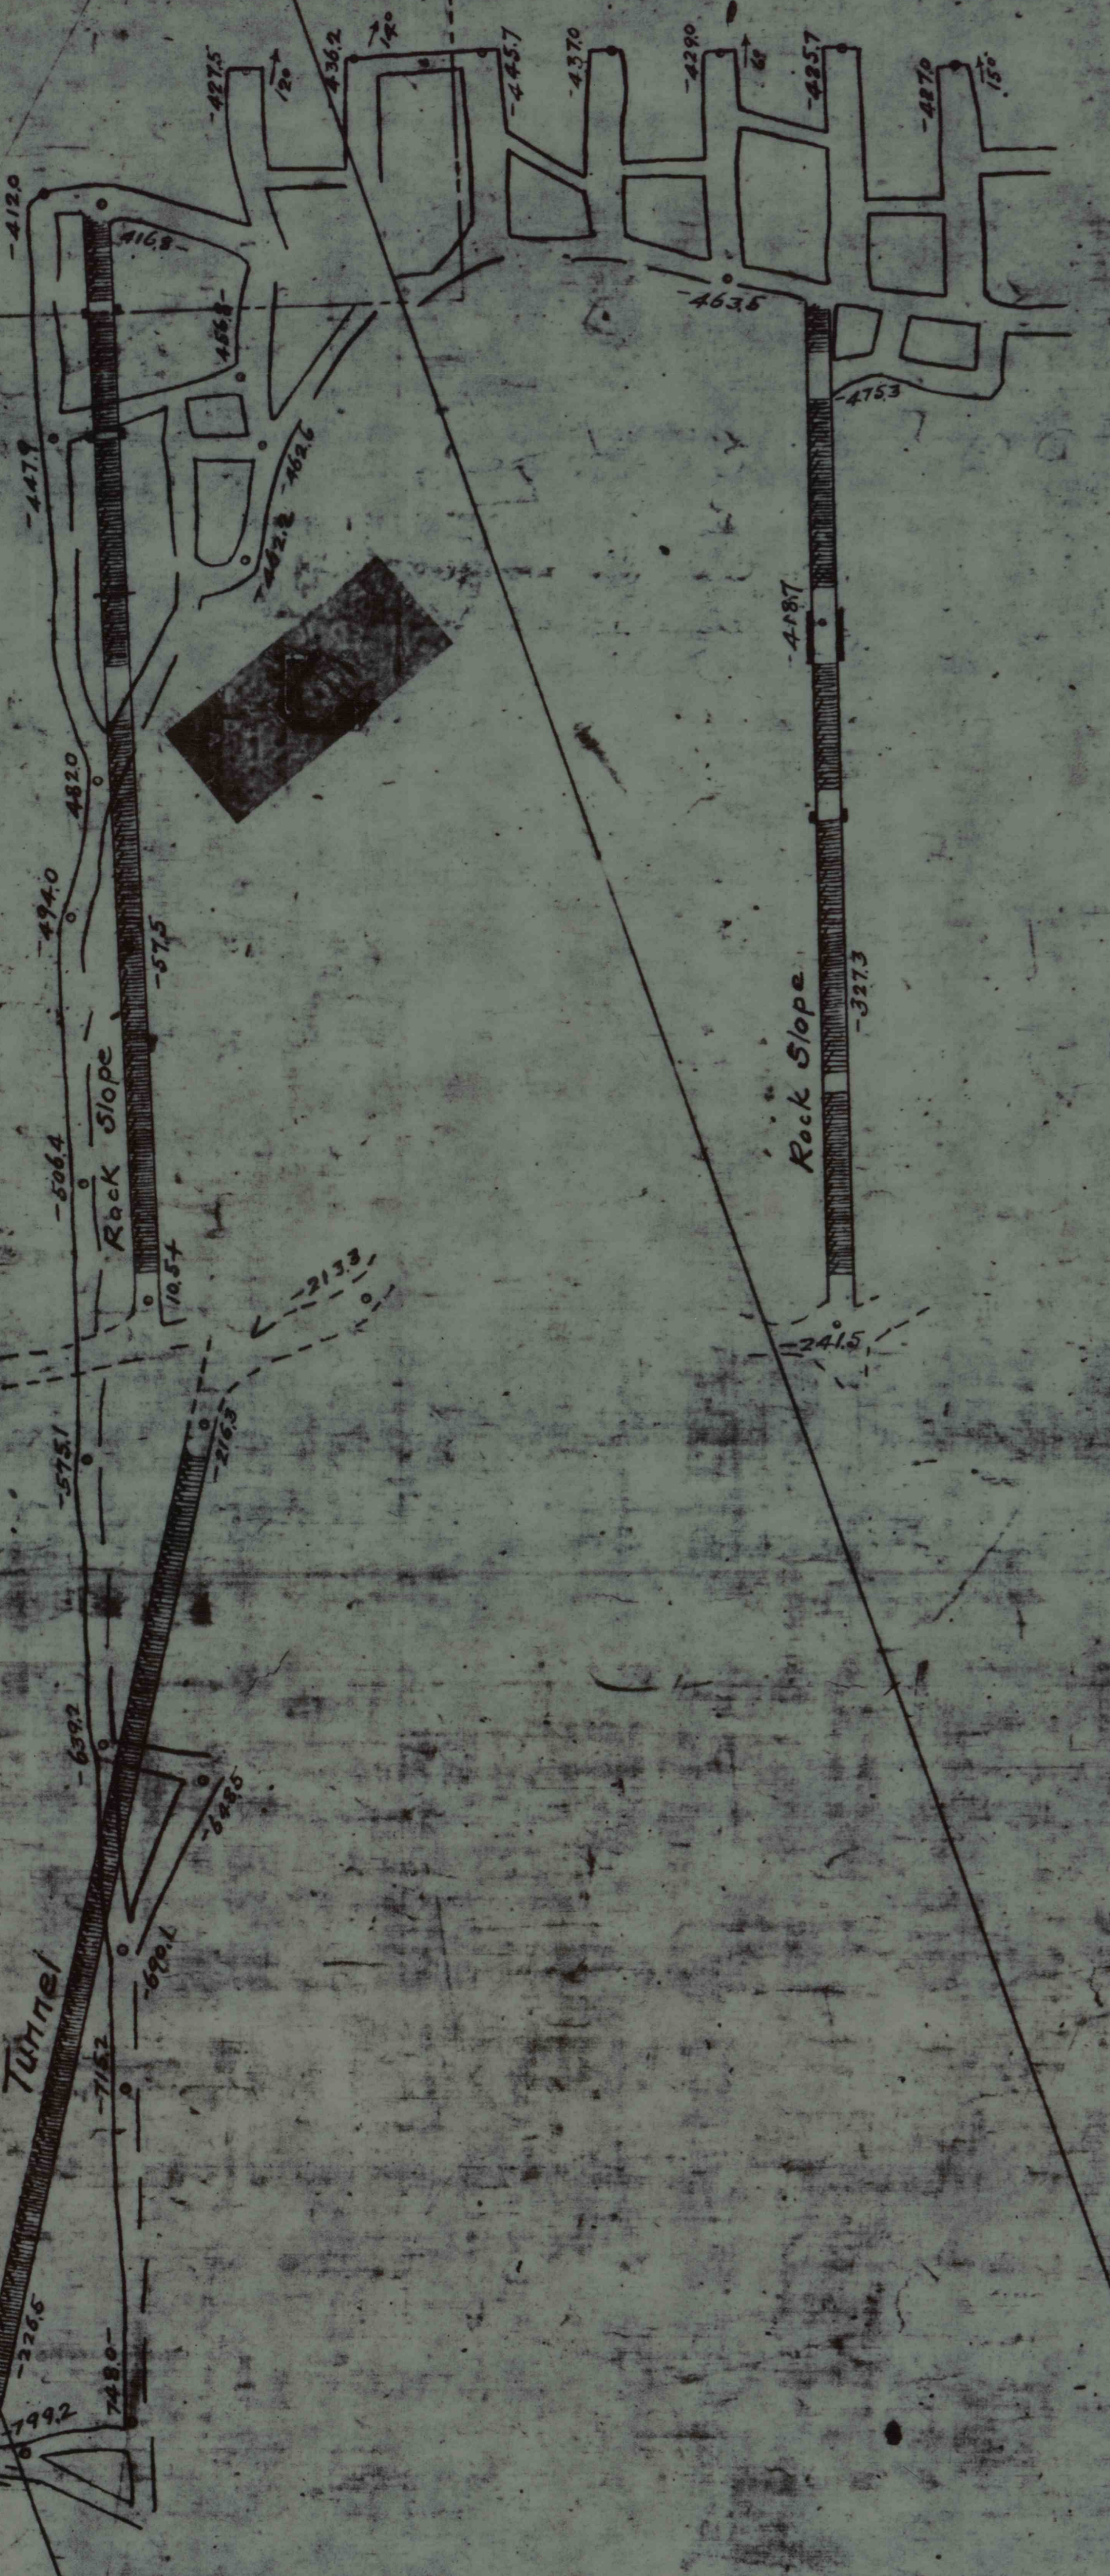

Riv. & Sops

Hall
102
101
100

B 143

B 143

B 147

B 147

B 147

B 147

B 176

B 176