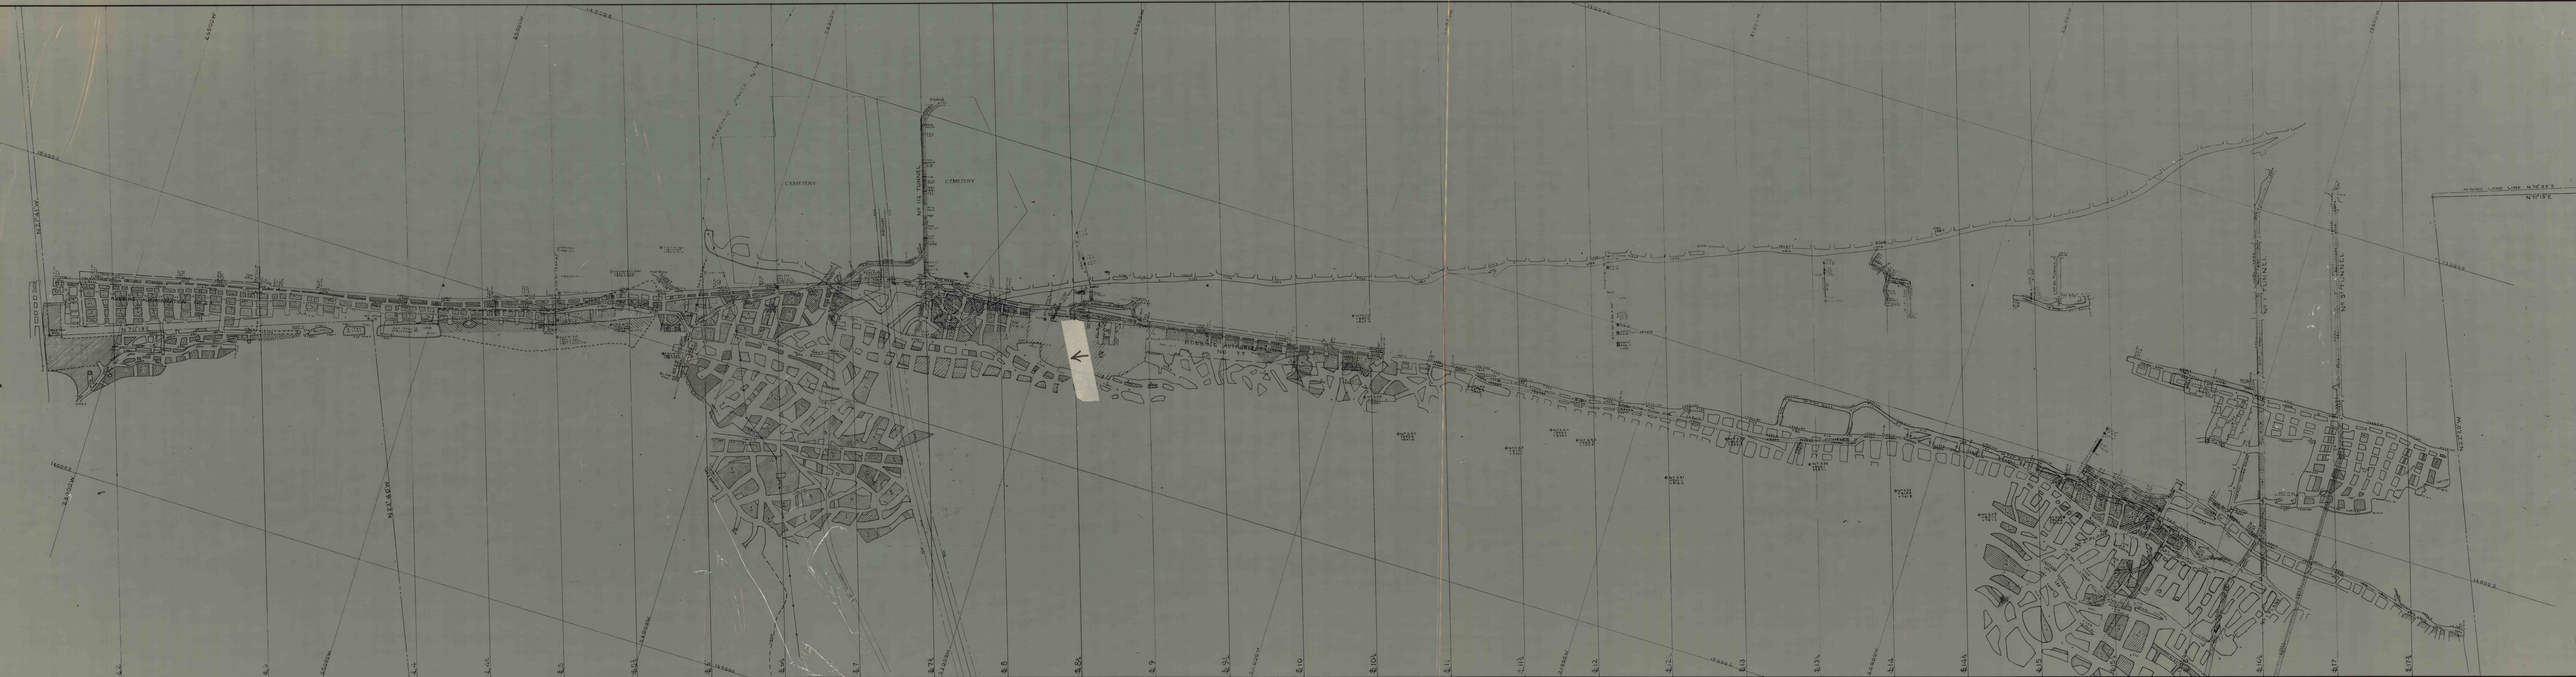
CEMETERY
CEMETERY
NO 115 TUNNEL
ROBBINS AVENUE
NO 117
NO 31 TUNNEL
NO 32 TUNNEL