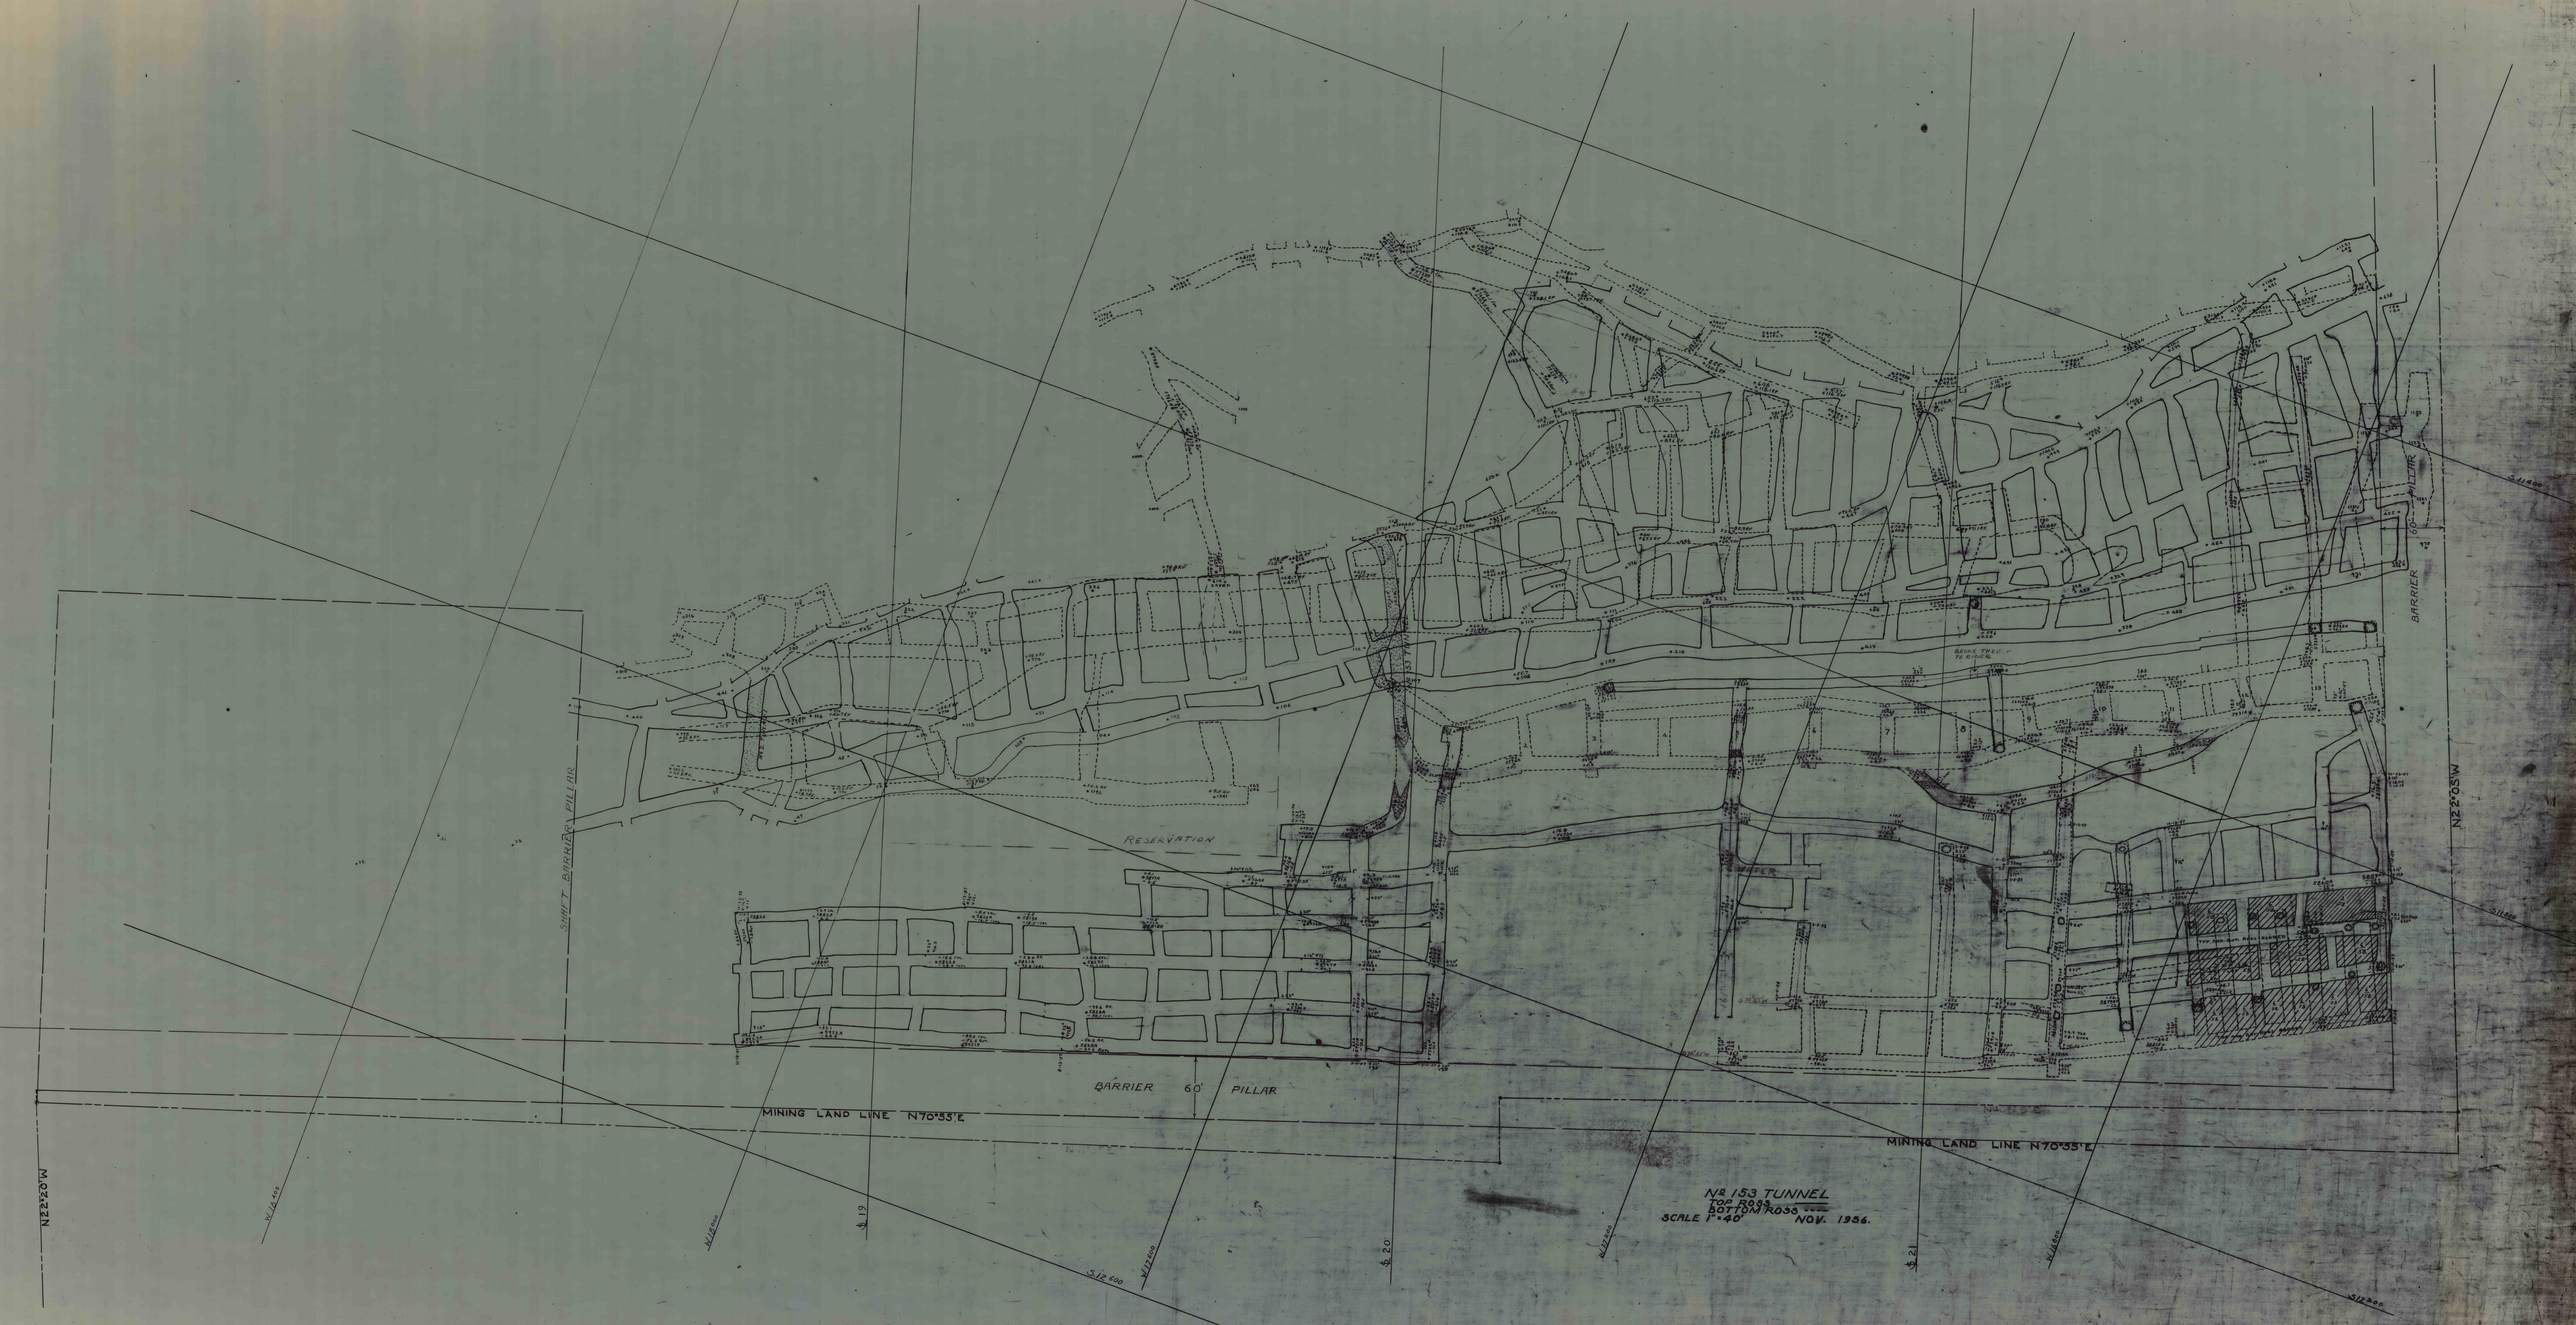
SHAFT BARRIER PILLAR
RESERVATION
BARRIER 60' PILLAR
MINING LAND LINE N70°55'E
MINING LAND LINE N70°55'E
BARRIER 100' PILLAR
N22°05'W
N22°05'W
No 153 TUNNEL
TOP ROAD
BOTTOM ROAD
SCALE 1"=40'
NOV. 1956.