


SECTION LINE
Scale 1" = 100'

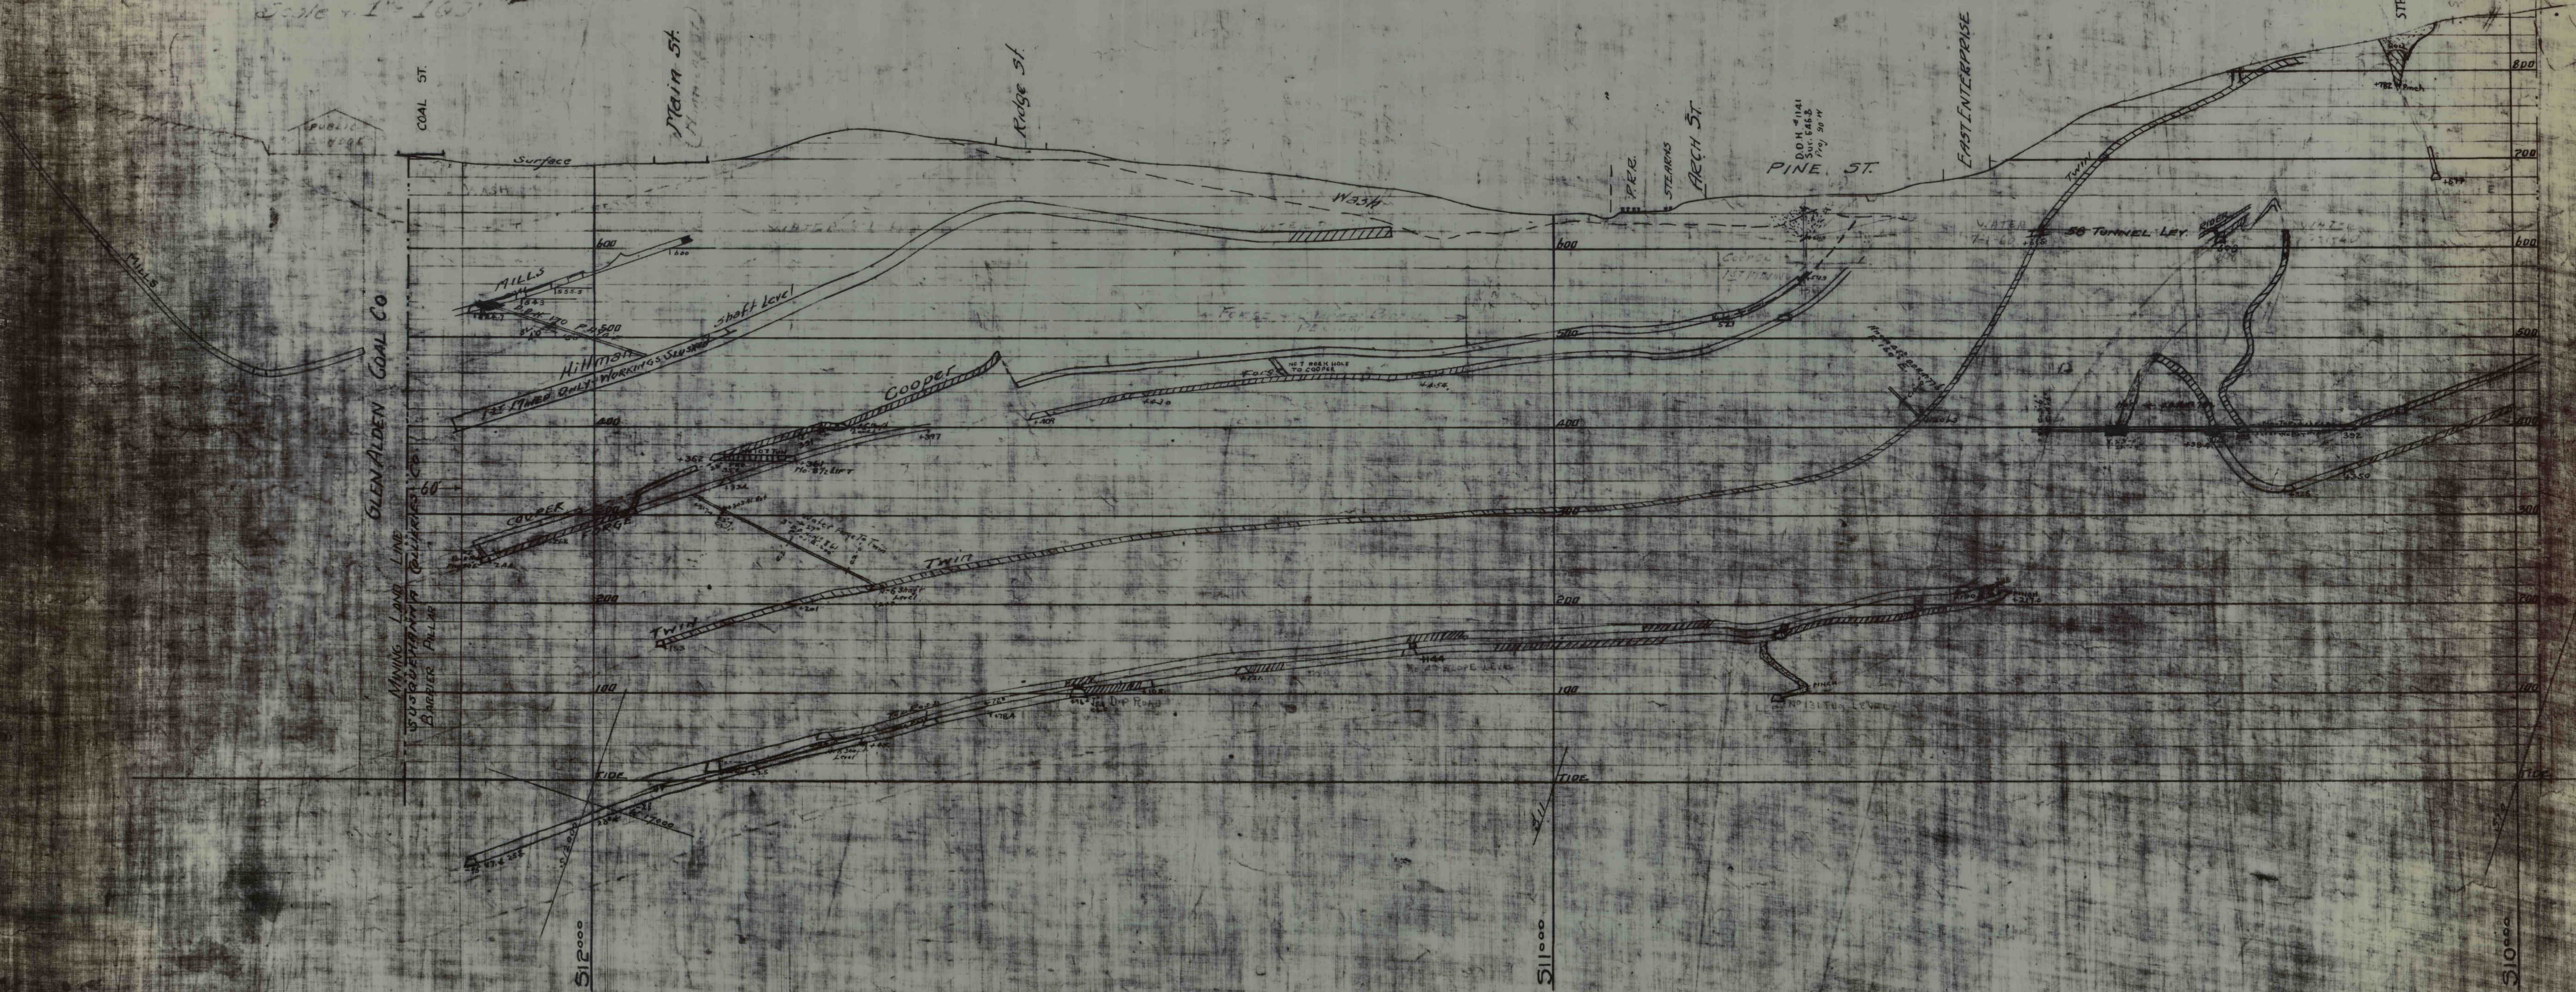

GLEN ALDEN COAL CO

MINING LAND LINE
BARRIER POLINE

512000

511000

510000