


SUGAR NOTCH LANDS

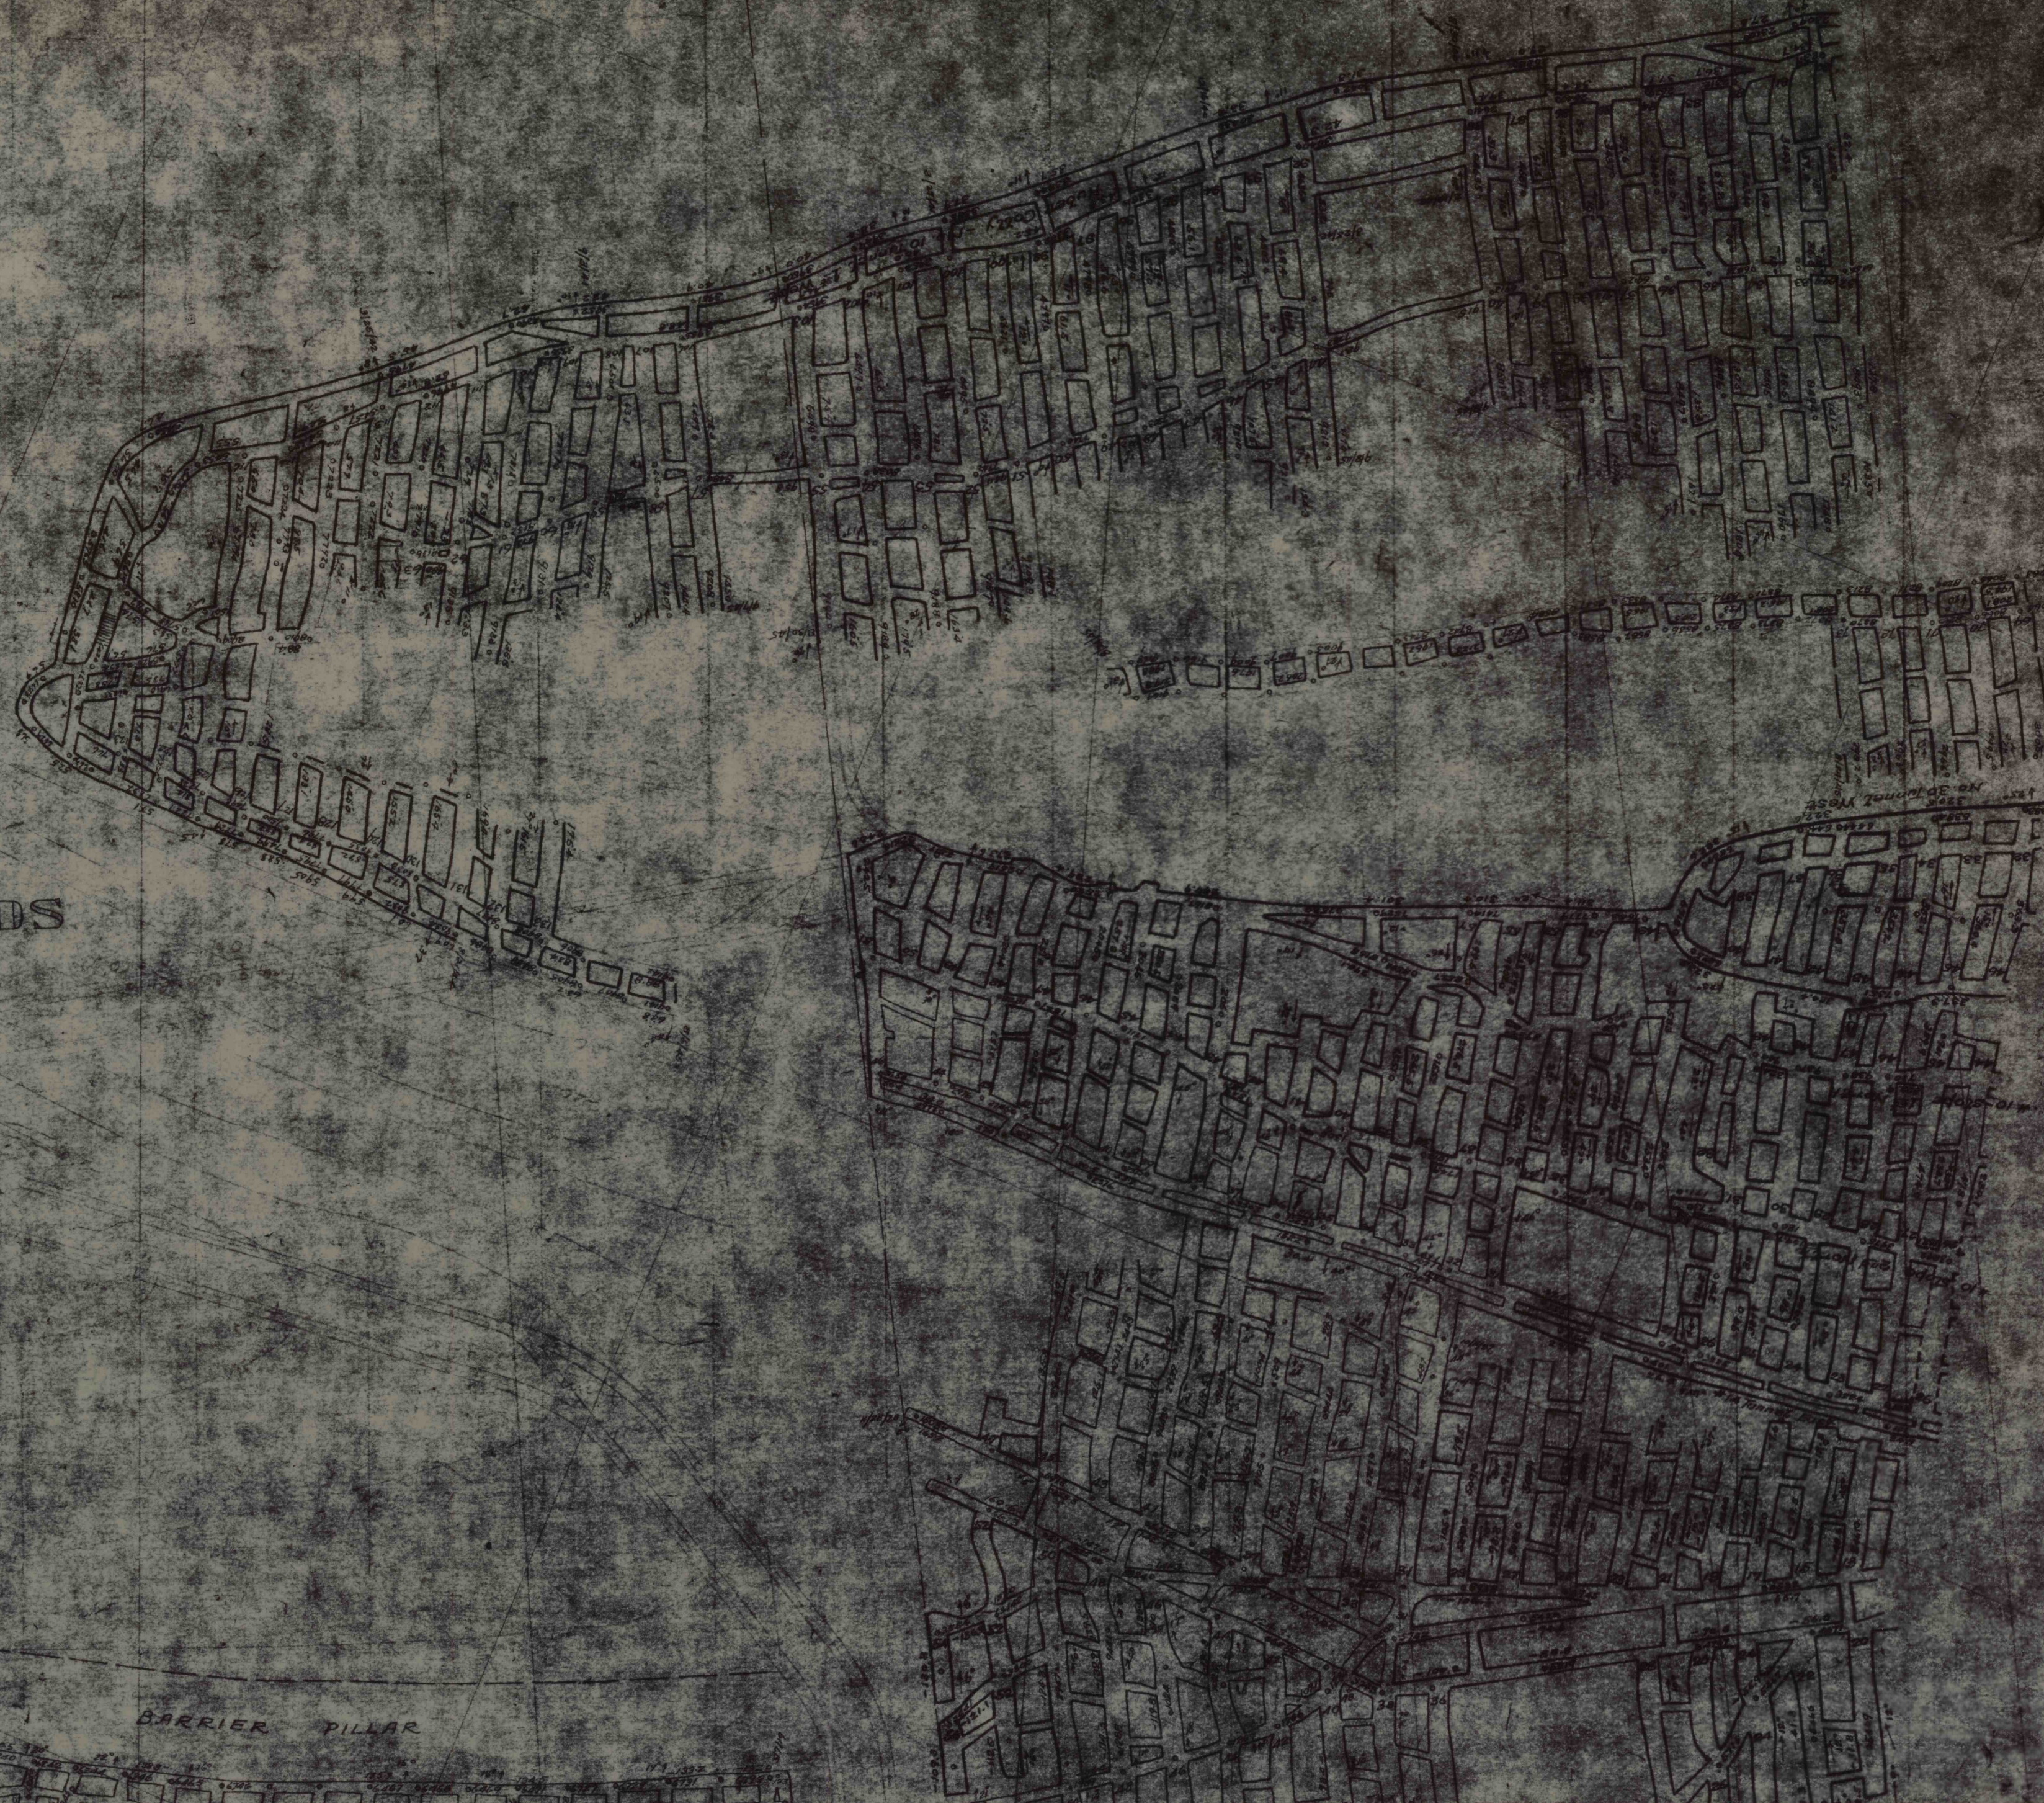

BARRIER PILLAR