


SUGAR NOTCH LANDS

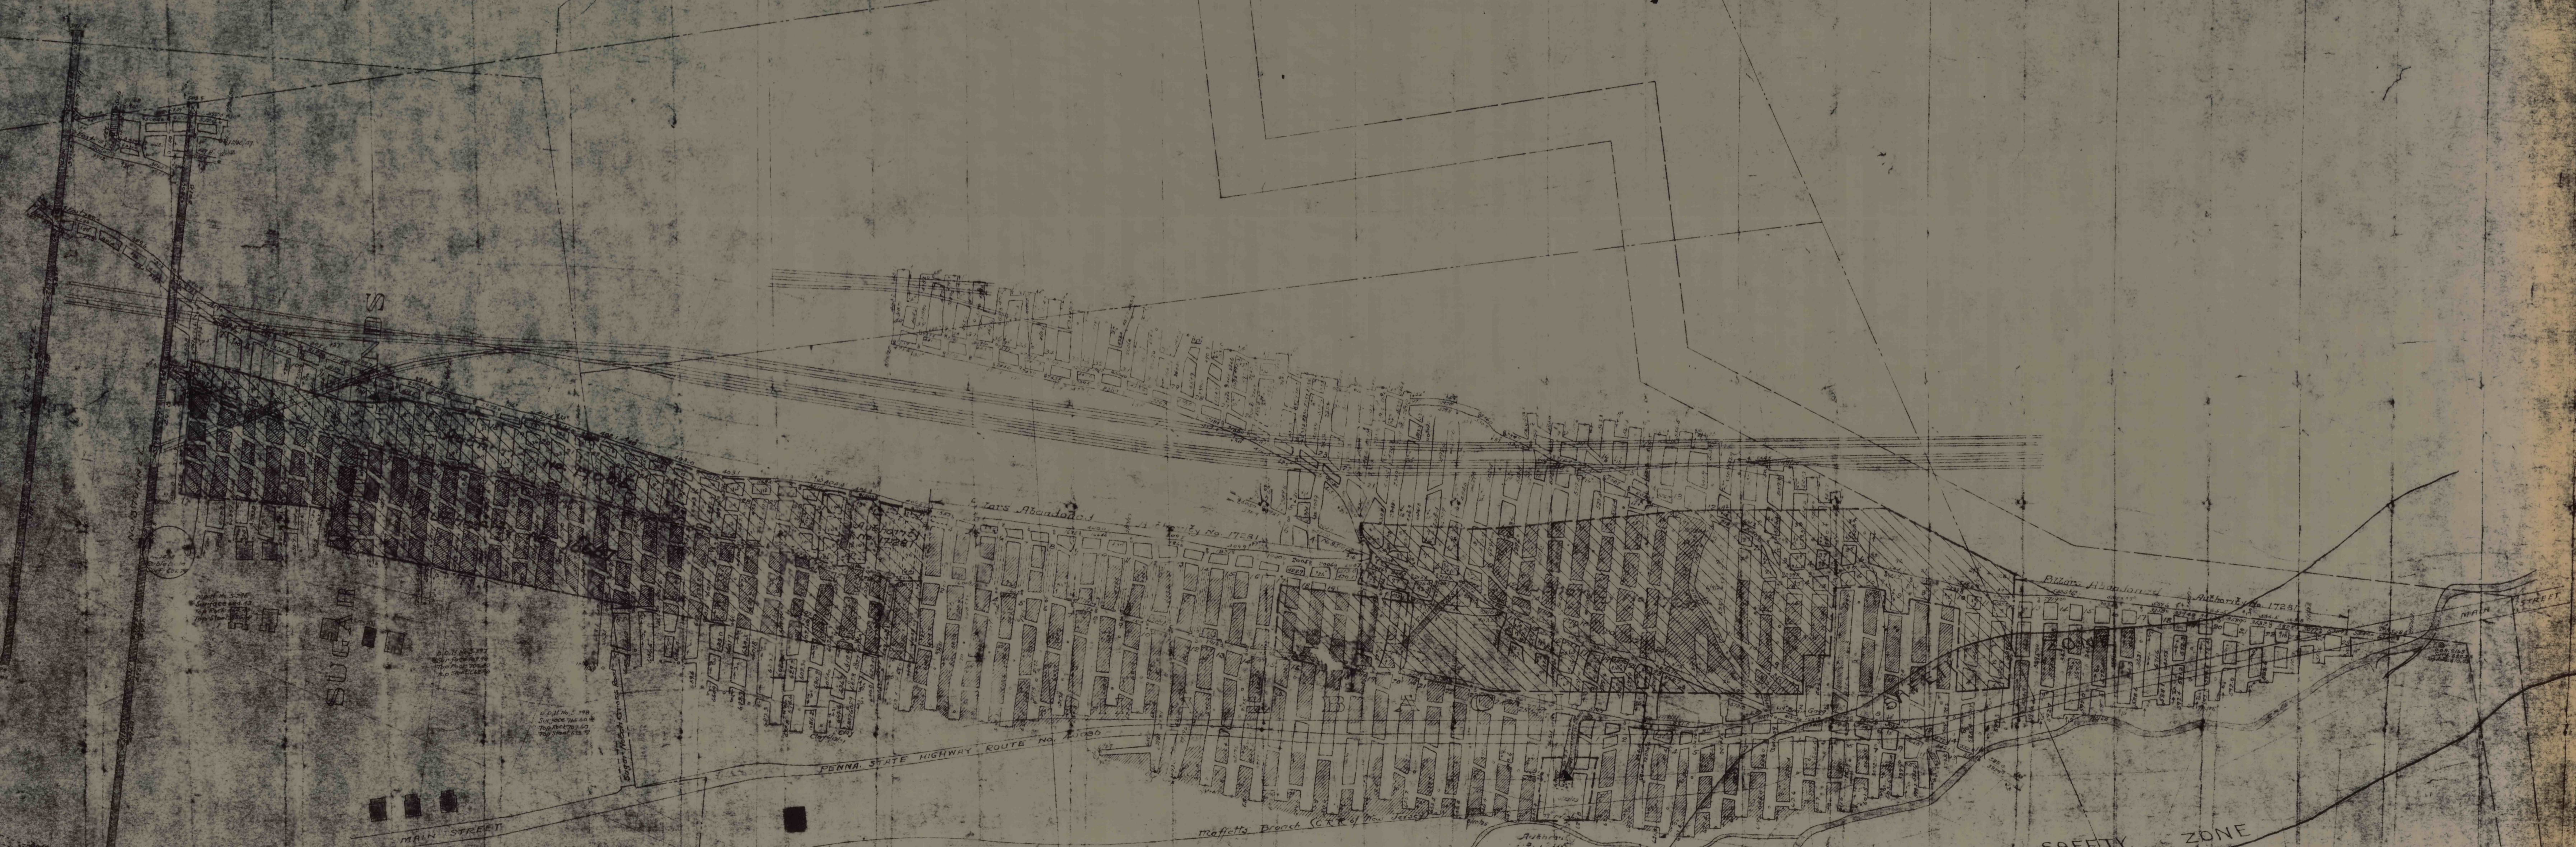

SUGAR

PENNA STATE HIGHWAY ROUTE NO. 2100

SAFETY ZONE

SUGAR NOTCH LANDS

MAIN STREET

Maple Street

Allen Abandoned

Abandoned No. 1788

F 300





