


SAFETY ZONE

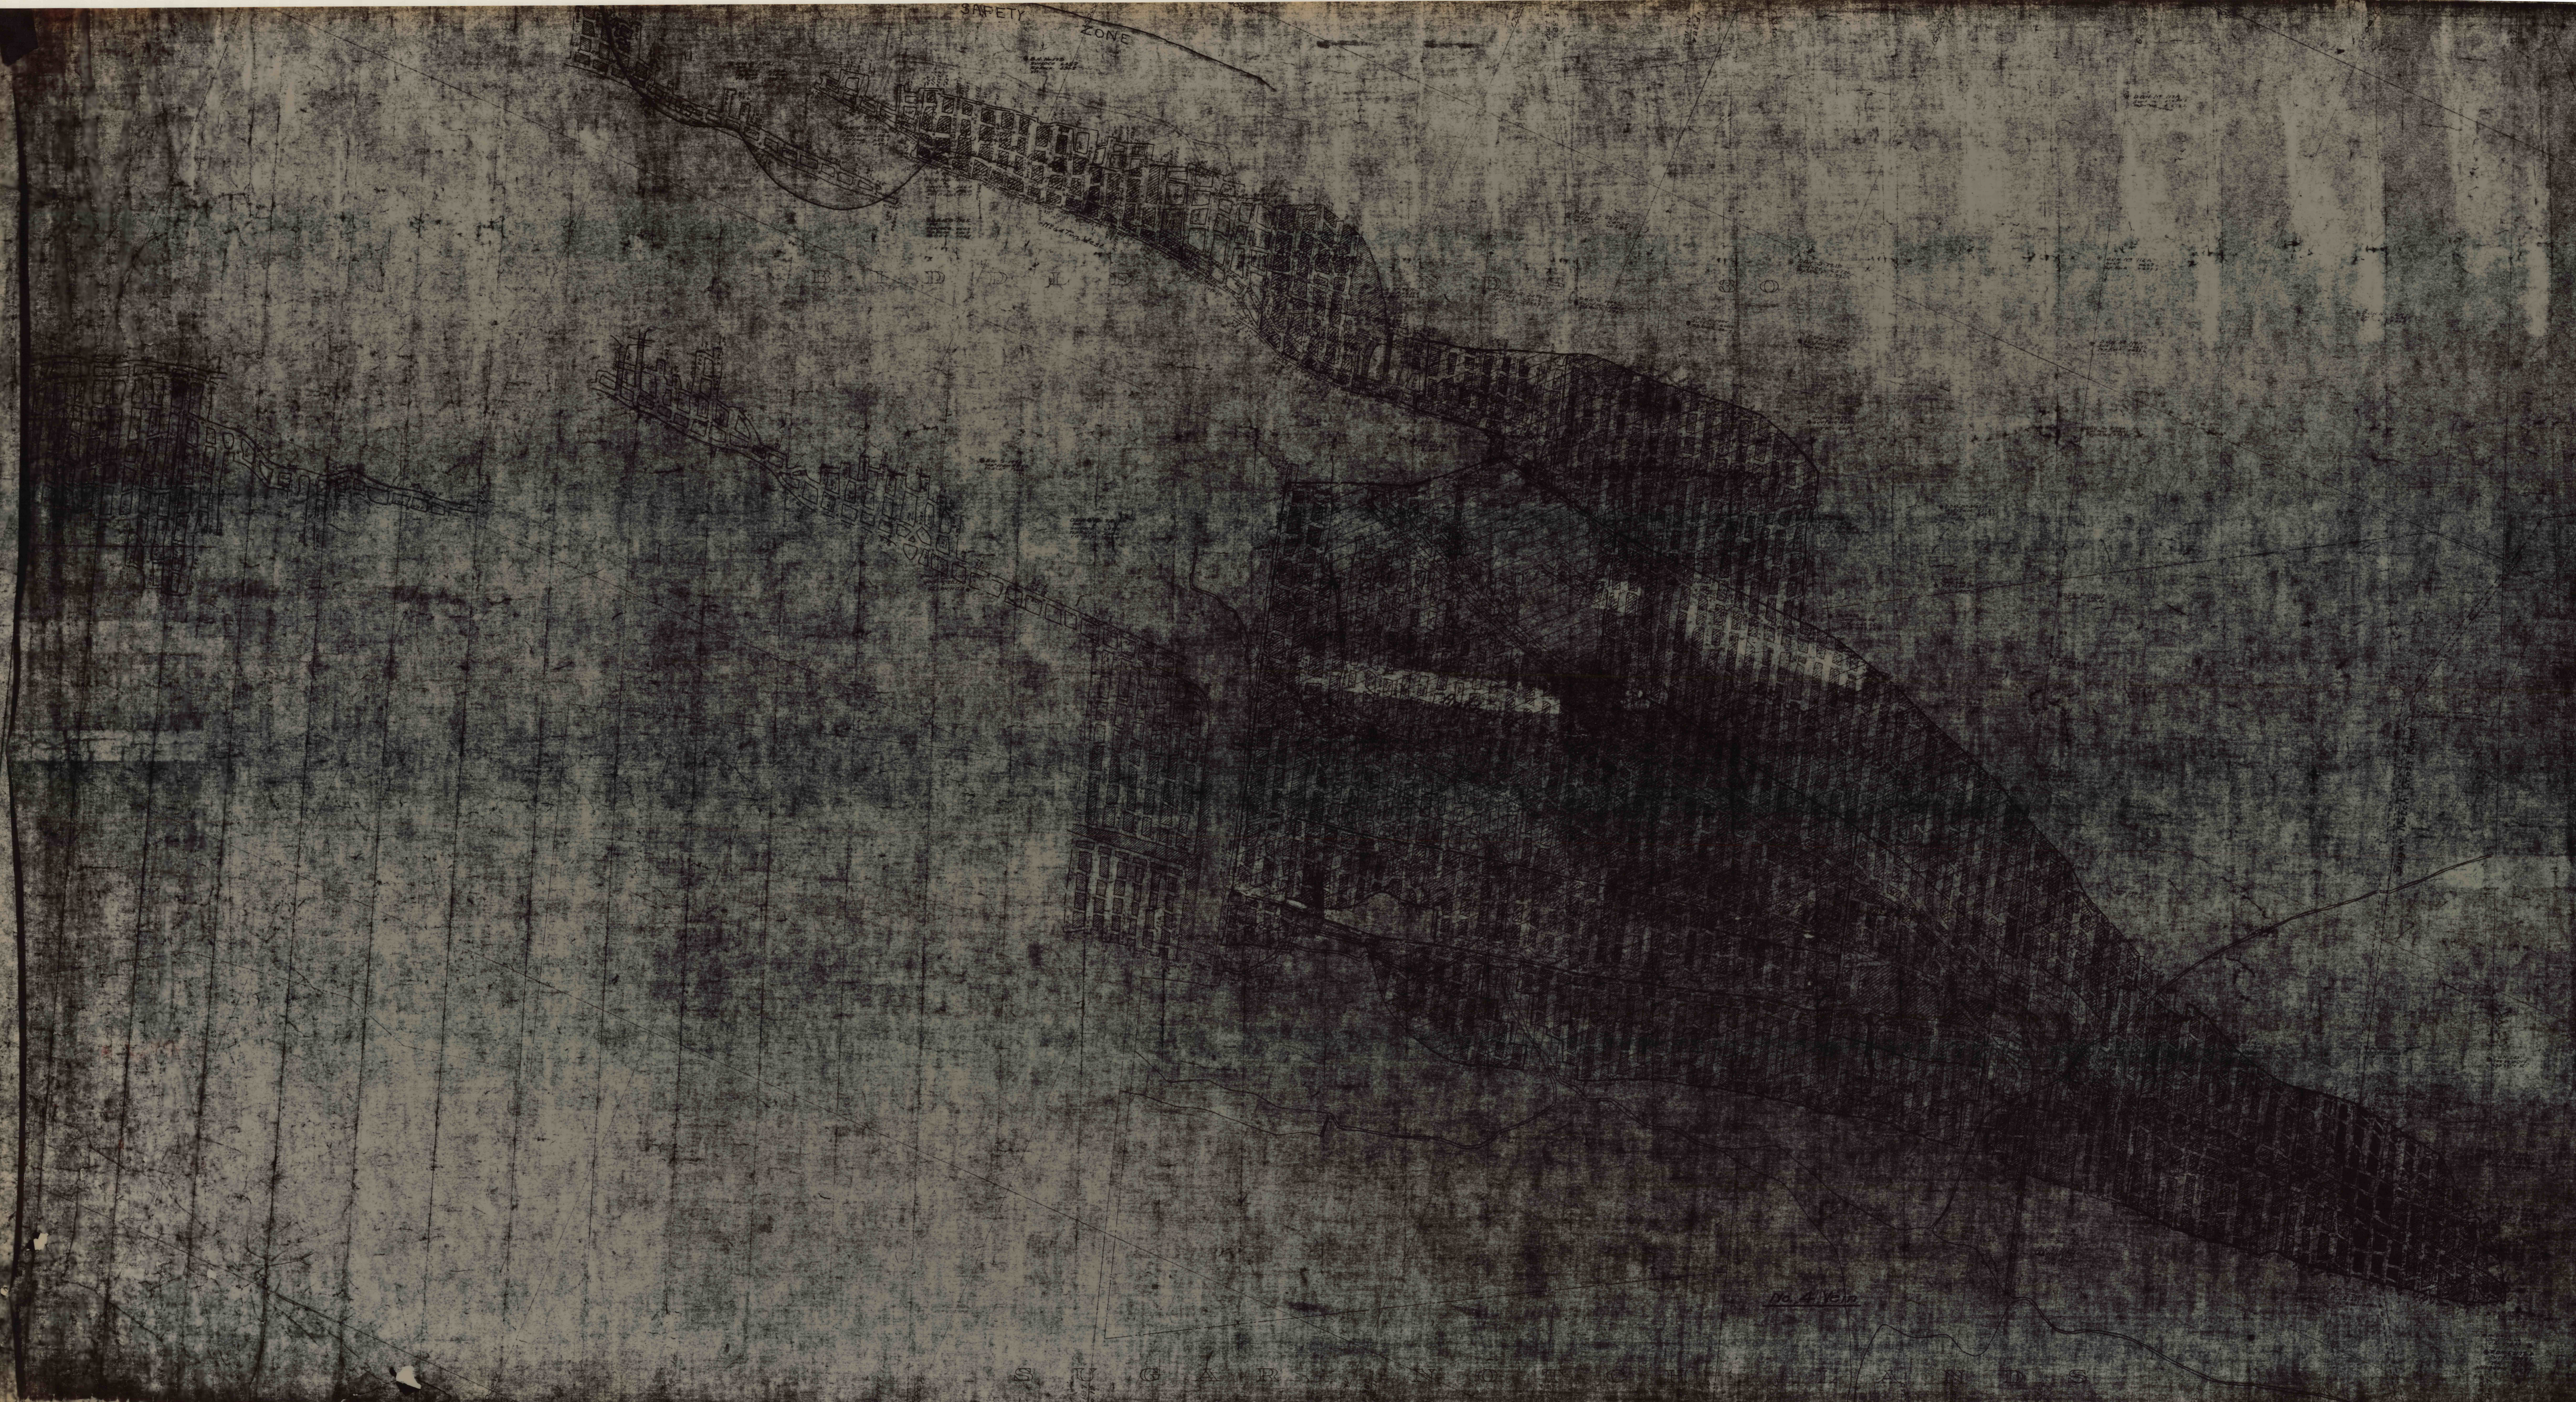

SUGAR NOTCH ISLANDS

No. 4, 1/2 in