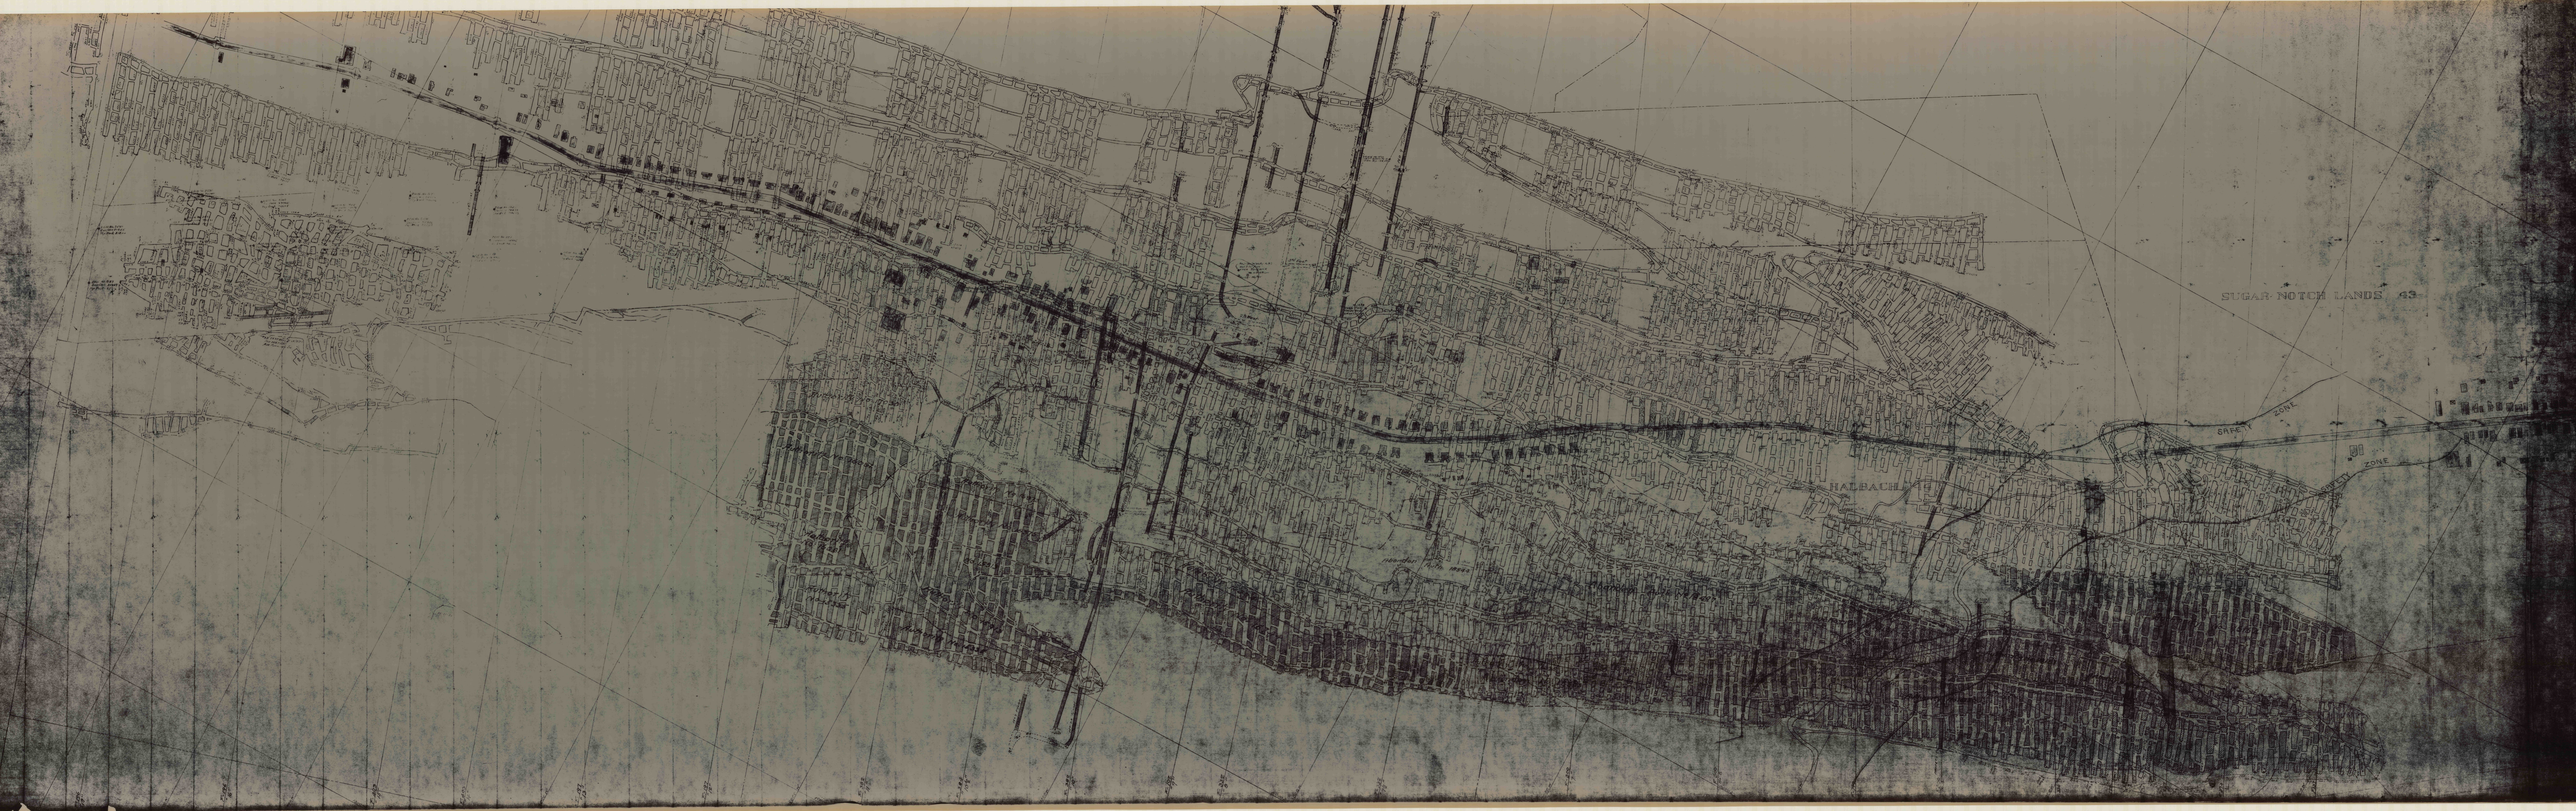
SUGAR NOTCH LANDS 43
HALBAUER
GRAVEL ZONE
SILT ZONE